

Newcastle


Extract from Mr. Martin's  
Report dated 21<sup>st</sup> June 1856.

No 15

A Ship  
1200 Tons  
S.S. 13 A

A Ship of 1200 tons building for  
Mr. George Marshall of London recently  
placed under S.S. for  $\frac{12}{13}A$ . Found her  
Planked outside from light water mark  
to upper edge of Sheerstrakes of East India  
Teak, (except three strakes of Wales  
Greenheart) six strakes of Bottom planking  
also wrought at Bilges, Inside Main &  
Riding Keelsons fitted of Greenheart, & Bolted  
through, the latter at alternate floors  
with Yellow Metal Bolts; Lower Deck  
Shelves or thick Clamps wrought of dimensions  
described in the Sketch, & eight strakes of  
Ceiling below them wrought, also six  
strakes of Ceiling at Floorheads, & the  
Liner Strake wrought of E. India Teak  
& Greenheart;

Dimensions of Beams  
by Table at Rule 14 & 11  $\frac{3}{4}$

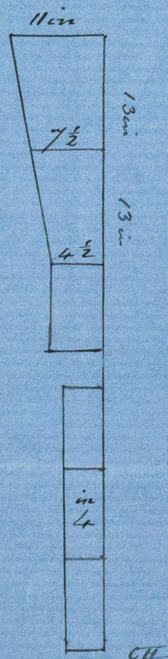



are yet bored through from outside, it is  
intended to put all thro' the Ceiling & to  
dispense with Lodging Knees at Lower  
Deck except in Mast Rooms.

Materials and Workmanship very good.



© 2019

Lloyd's Register  
Foundation