


Letter to Mr. Shields
 11-7-80
 20-7-90

BOILERS

INCH SCALE

WORKING PRESSURE 115 lbs per sq inch.

All parts of this boiler to be of steel excepting Stays & Tubes.
 To be tested with Water to 230 lbs per sq inch

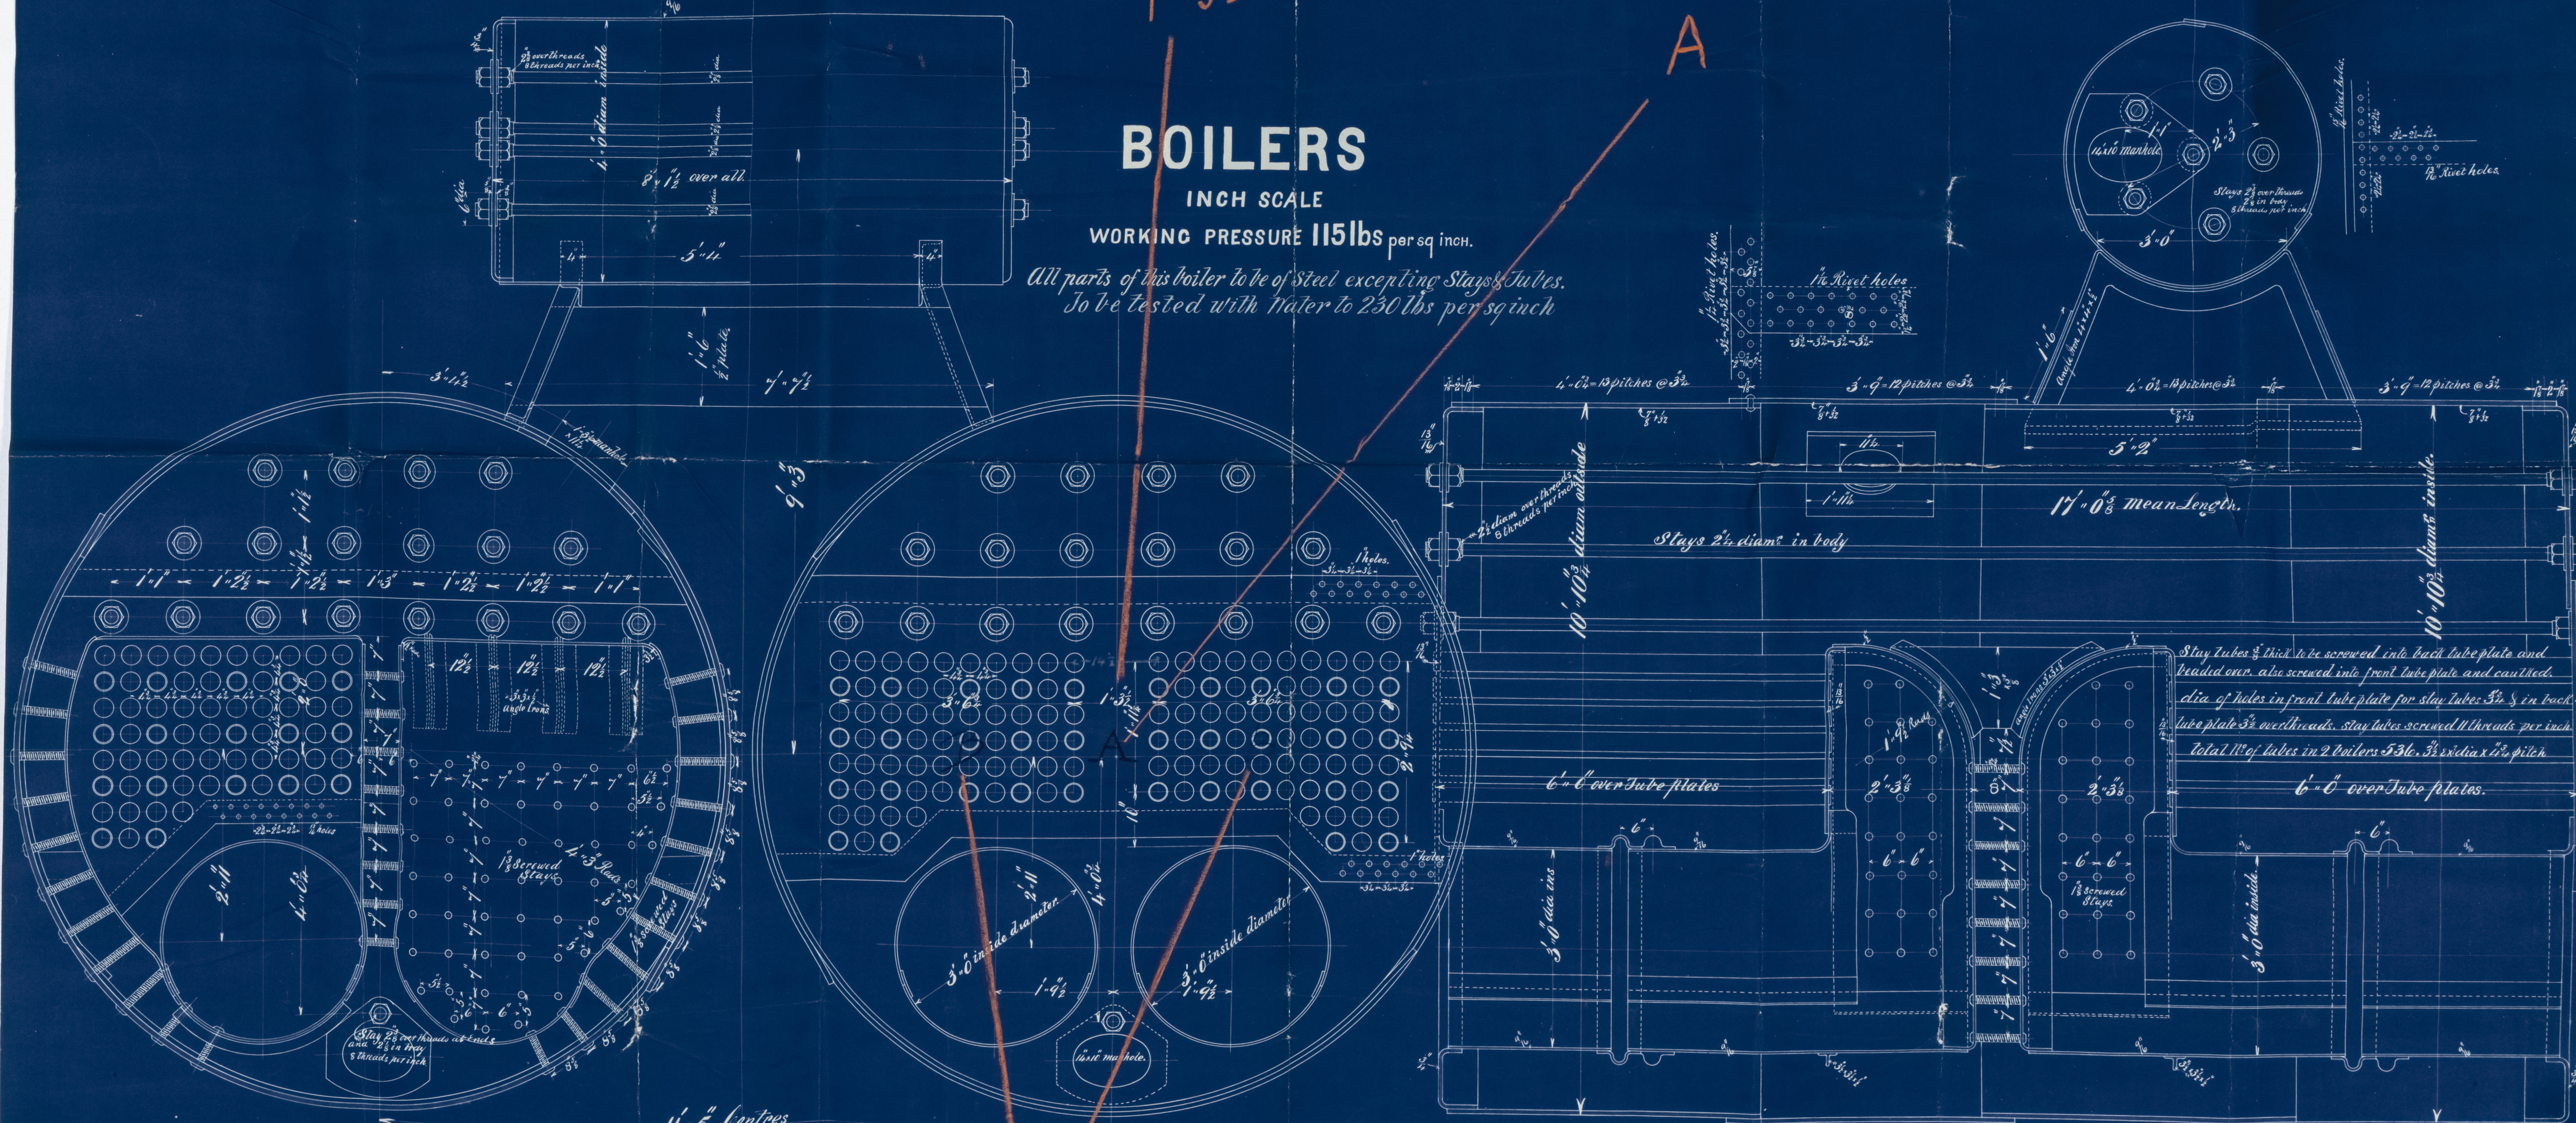

ENGINES N° 342

N°



Box

0034



© 2021

Lloyd's Register
Foundation

Palmer's ^{no} 428 ship
" 342 engine

S.S. "Northern"
New Report No. 15182
Machy No. 425

NWC 777-0034

