



30980

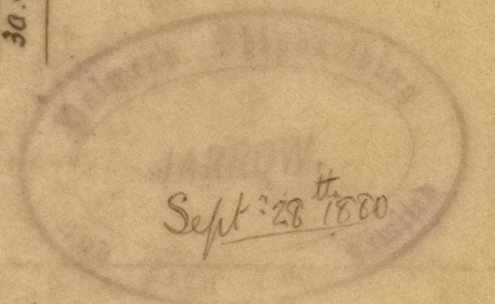

S.S. "Northern" Nwc Report No. 15182.
Sketch shewing position of Cargo Port. Fore Tween Decks.
S.S. N^o 428.
Scale 1/4" = one foot.

Note Original position of Port's plenum in dotted blue line.

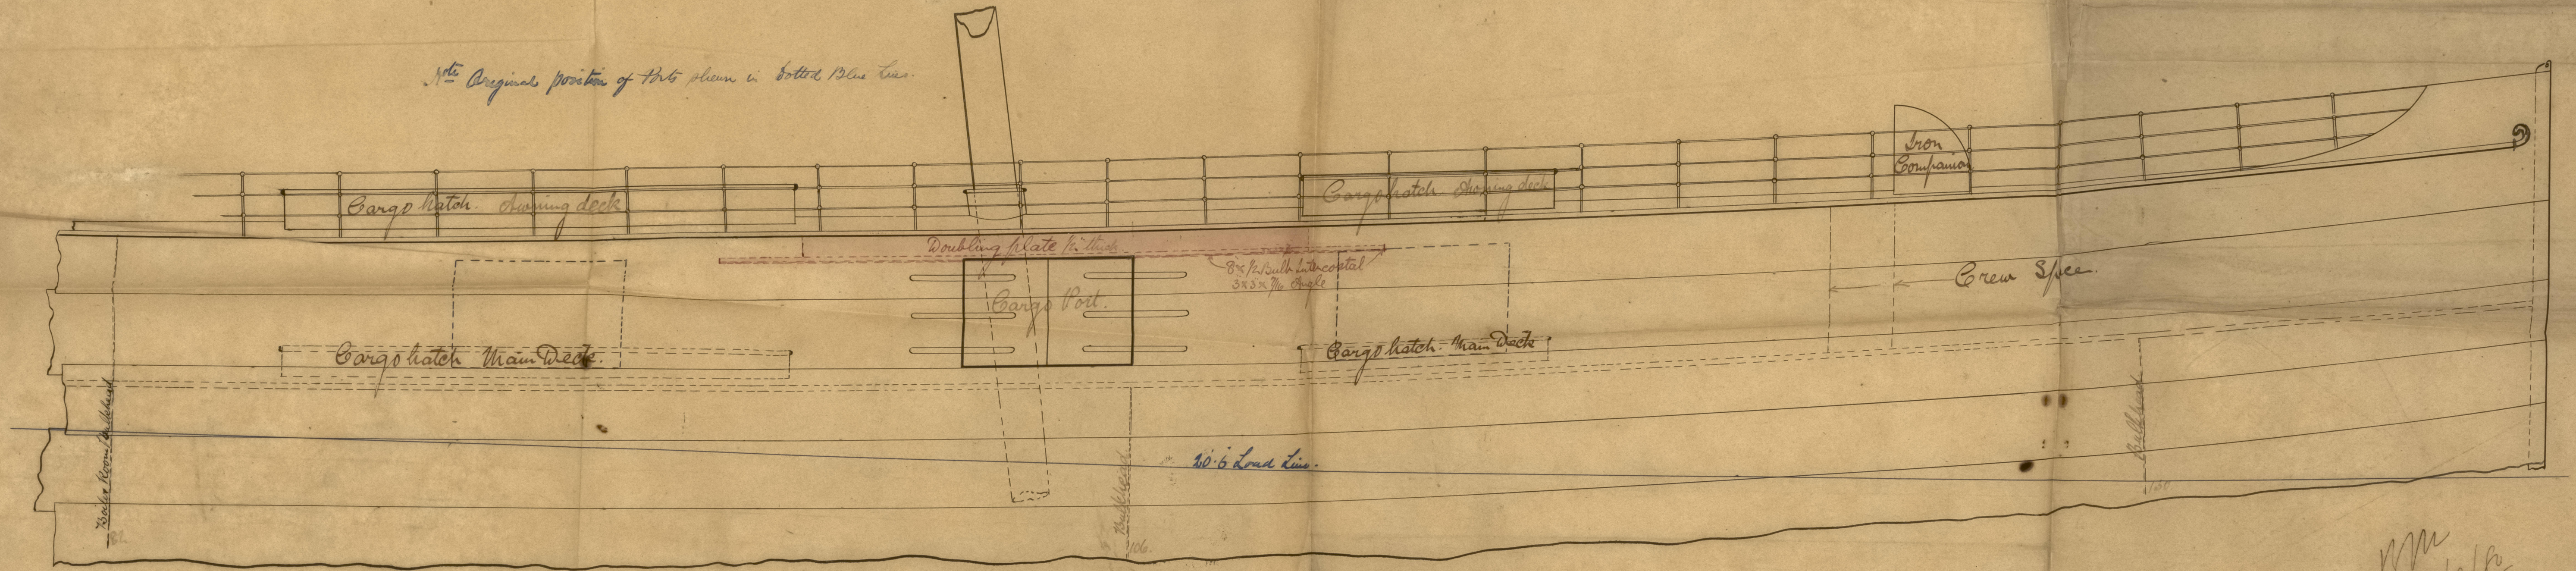

NWC
29/9/80

28/9/80

NWC 444-0035