

Ltr to RSHls:
 7/7/80


S.S. "Grimsel" Ave. Report No. 15009

PLAN SHOWING PUMPS AND PIPES IN No 163.

SCALE 1/8 INCH = 1 FOOT

M
 5.7.80

S.S. "Homer" Ave. Report No 15201

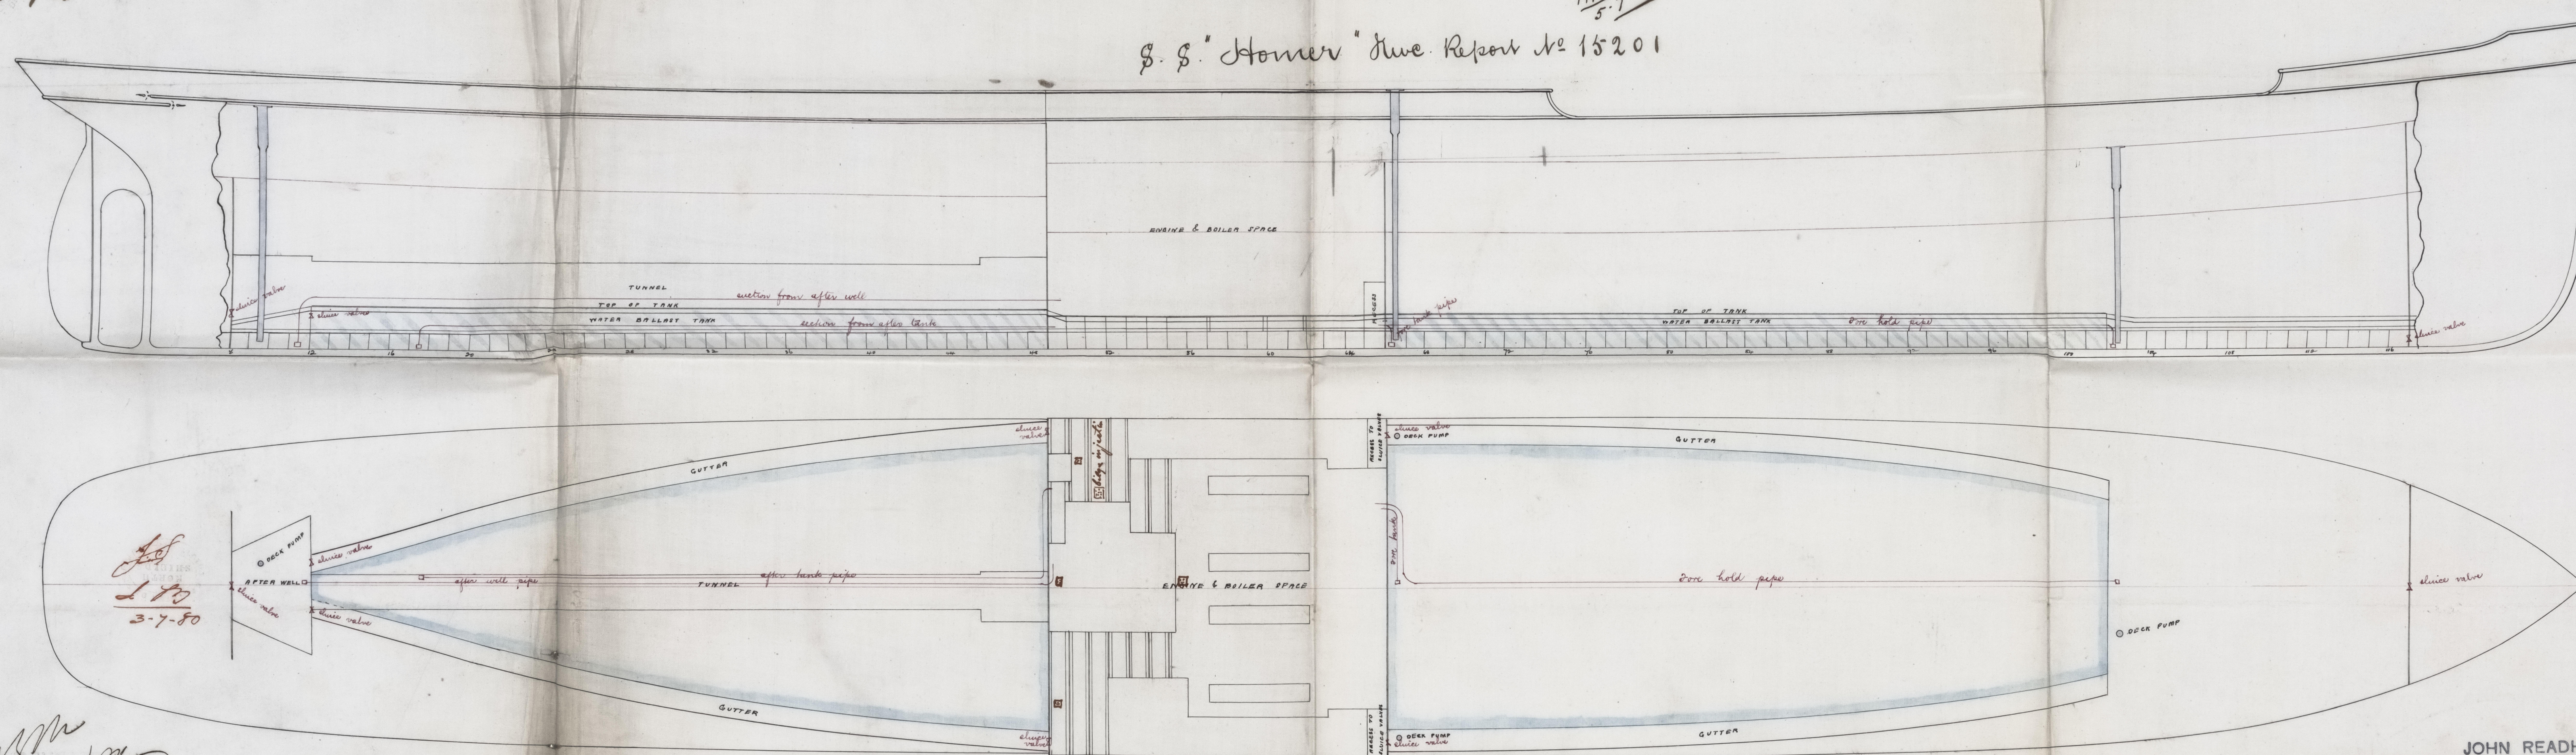

L.S.
 1.80
 3-7-80

18th
 5/7/80

2100-111-0111

JOHN READHEAD & CO,
 Shipbuilders,
 SOUTH SHIELDS.

© 2021