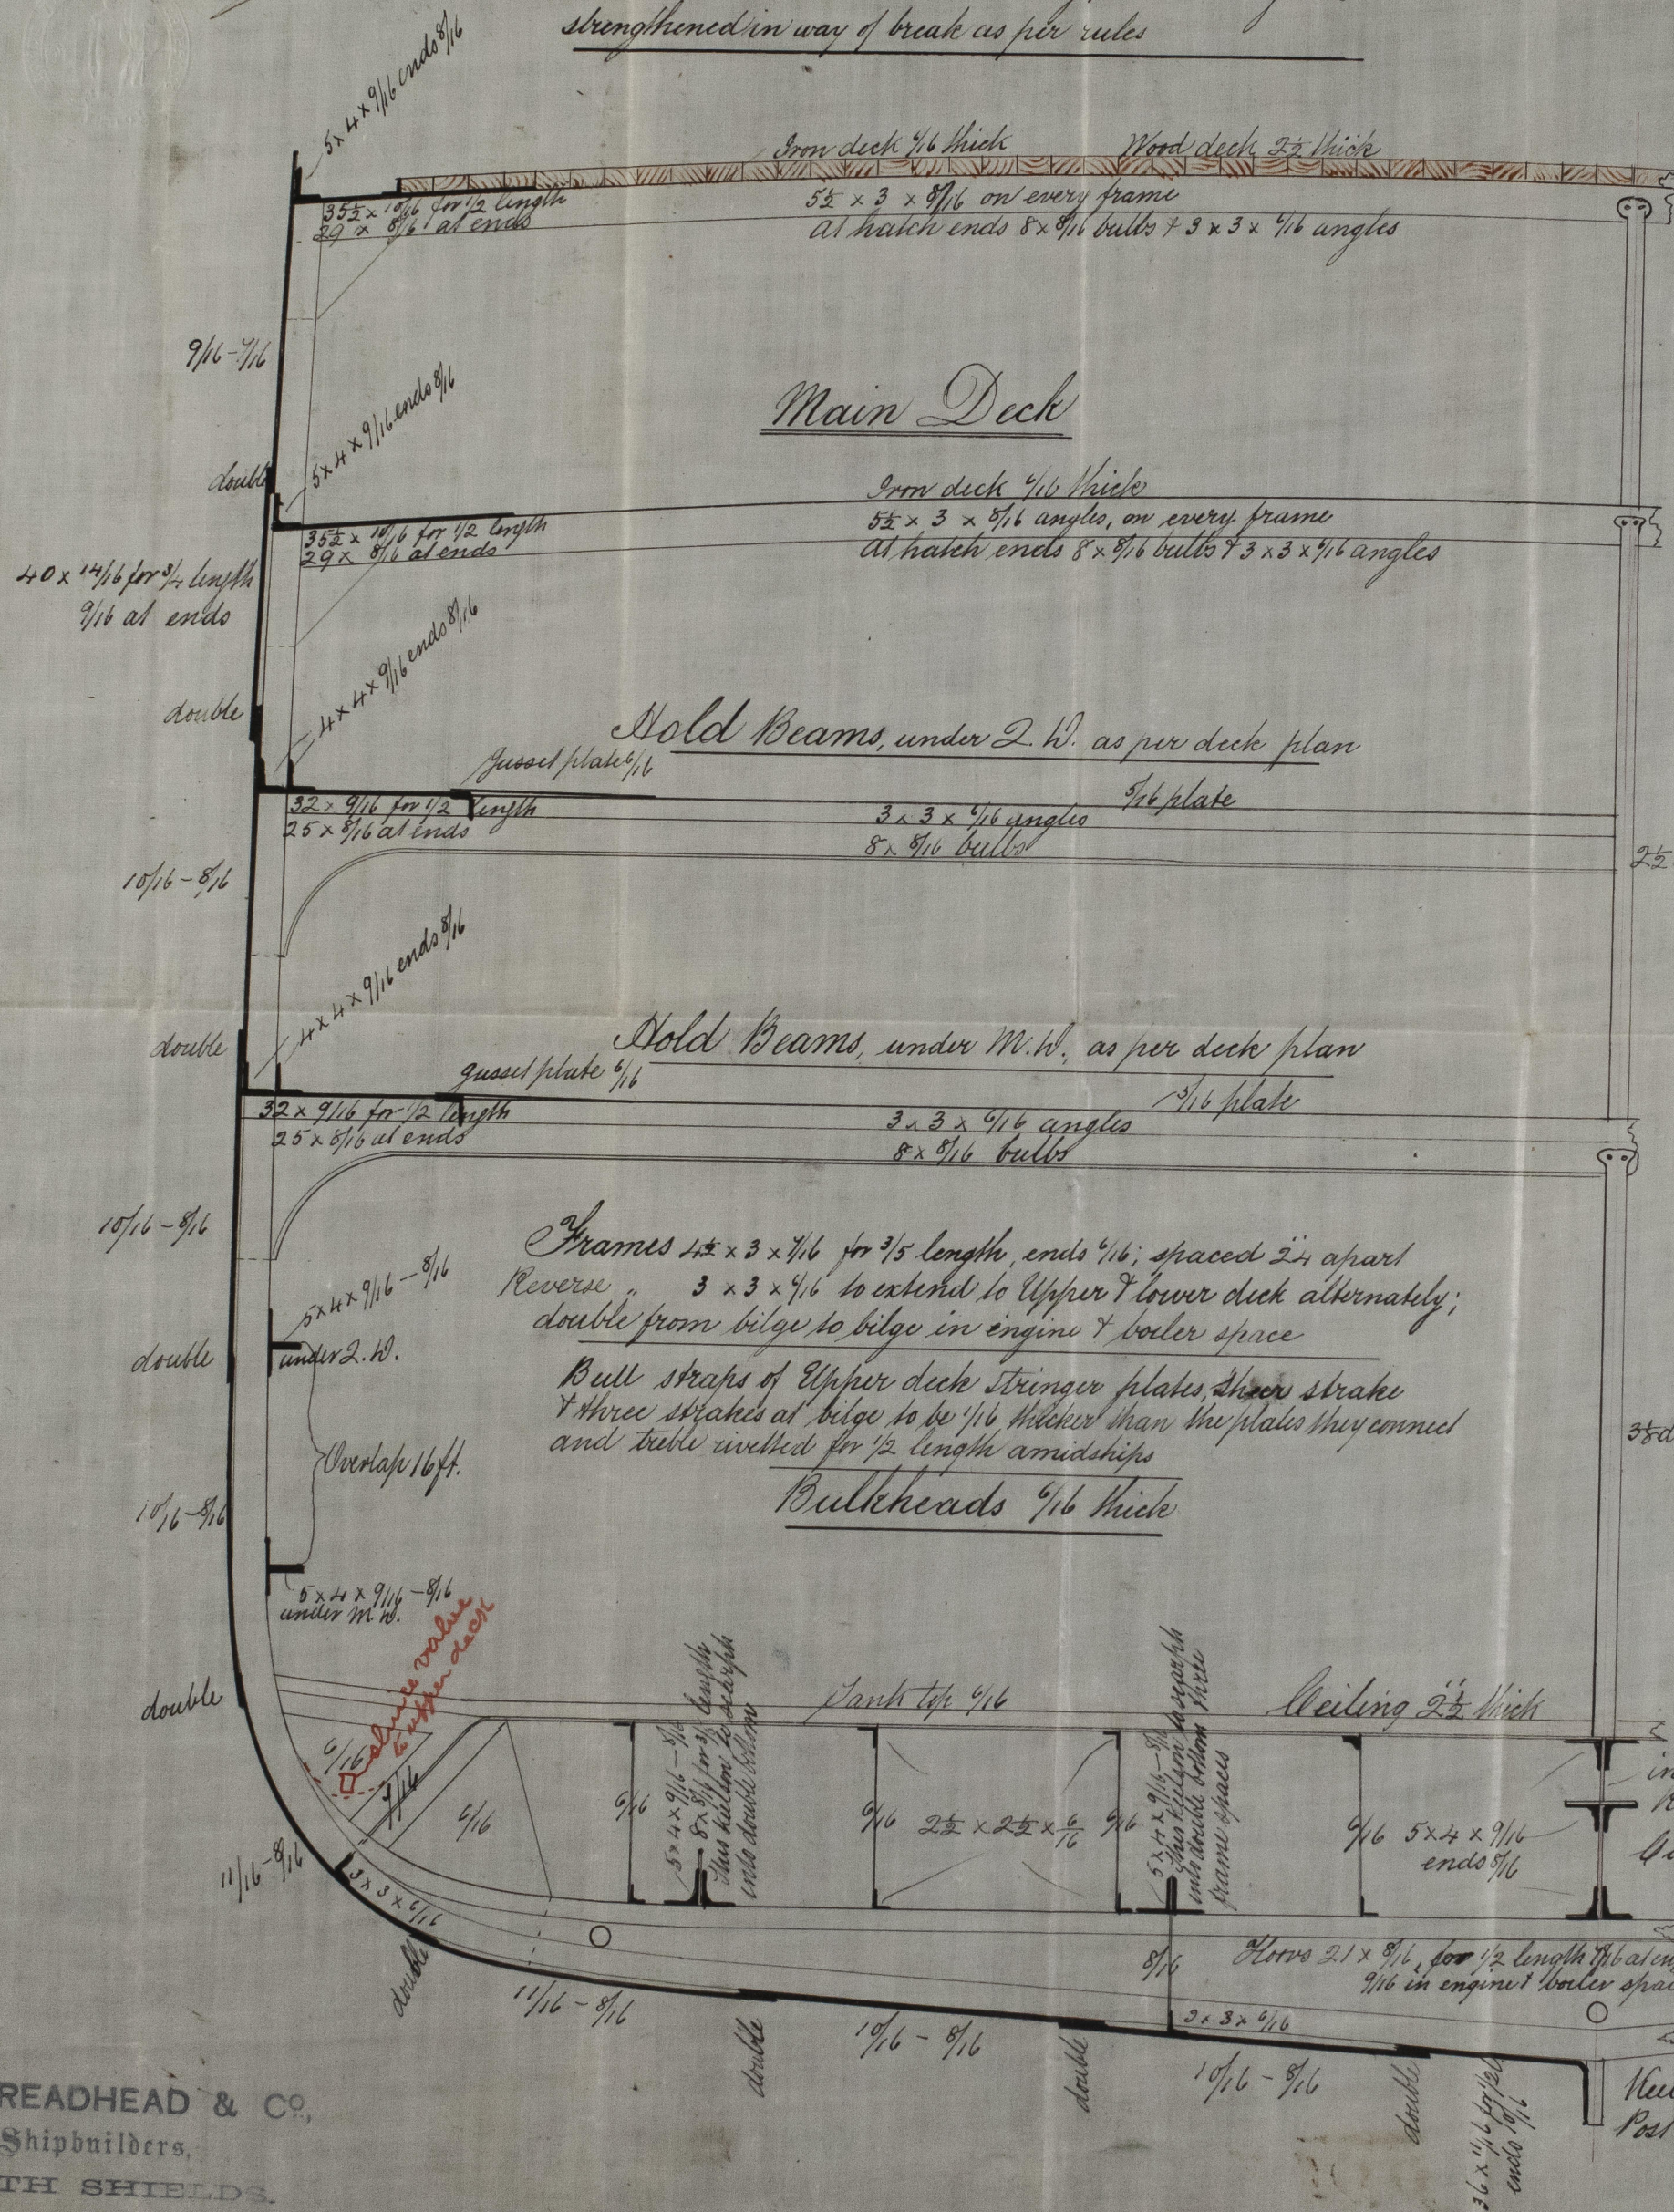


S S N°163. & 166

4. 3. 80


$$68.95 \times 248.3 = 17120$$

12 & 13 depths

Equipment No = 18832

Fore Tank 70 ft 0 in long  
After do 74 " 0 " "

JOHN READHEAD & CO.,  
Shipbuilders,  
SOUTH SHIELDS.

XXXX-777-0049