


11/10 111-0023

S.S. "Grimmel" Nwc. Report No. 15009

S.S. "Homer" Nwc. Report No. 15201

S. S. N° 163 - 166

Dimensions—  
1/2 Girth = 52.7  
1/2 Beam = 17.0  
Depth = 19.25  
 $68.95 \times 248.3 = 17120$

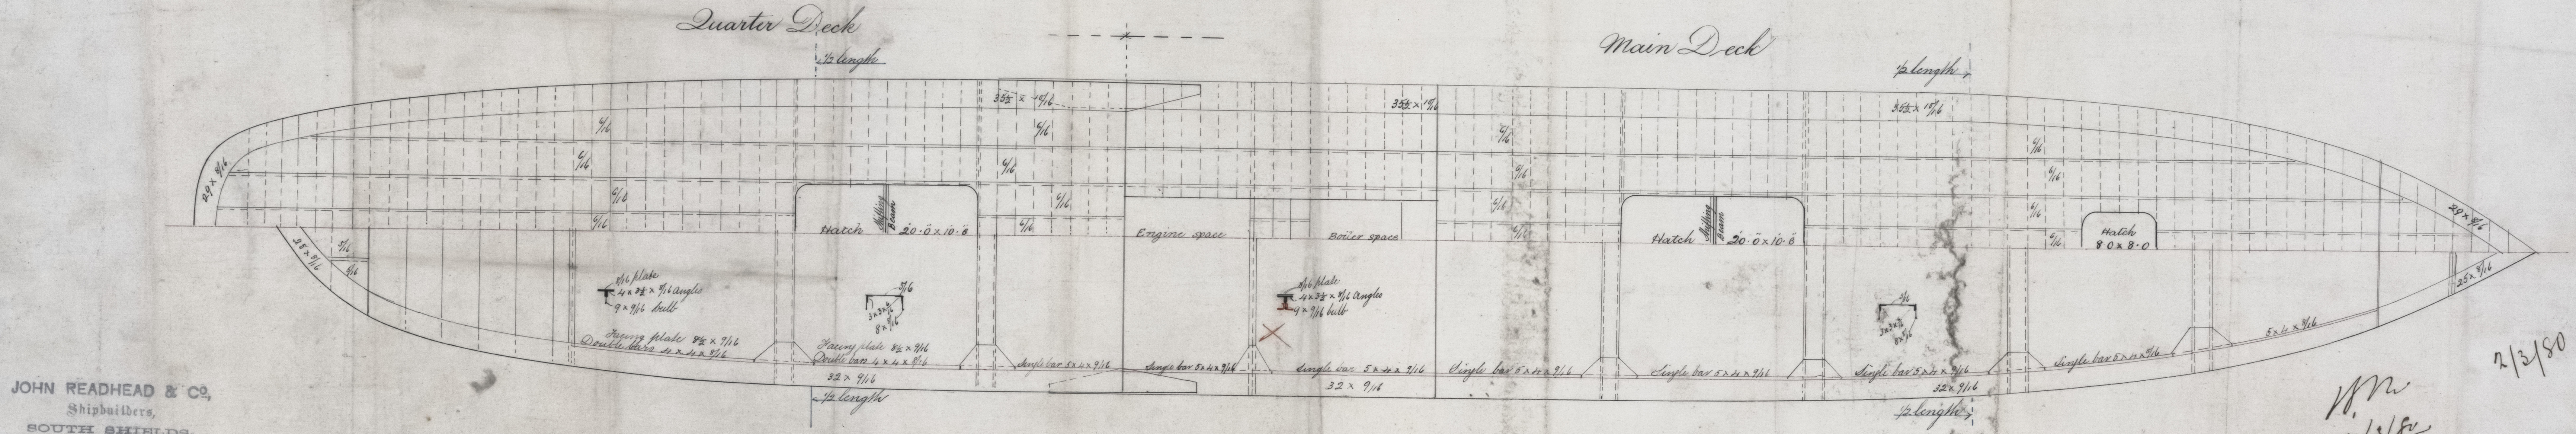

JOHN READHEAD & CO,  
Shipbuilders,  
SOUTH SHIELDS.

2/3/80  
4/3/80