


3.1.81

# S.S. "De Bay" Nwc. Report No. 15458

## MIDSHIP SECTION · S.S. N° 439.

SCALE  $\frac{1}{2}$  INCH TO A FOOT.

adnc. 28 1/2 1880.

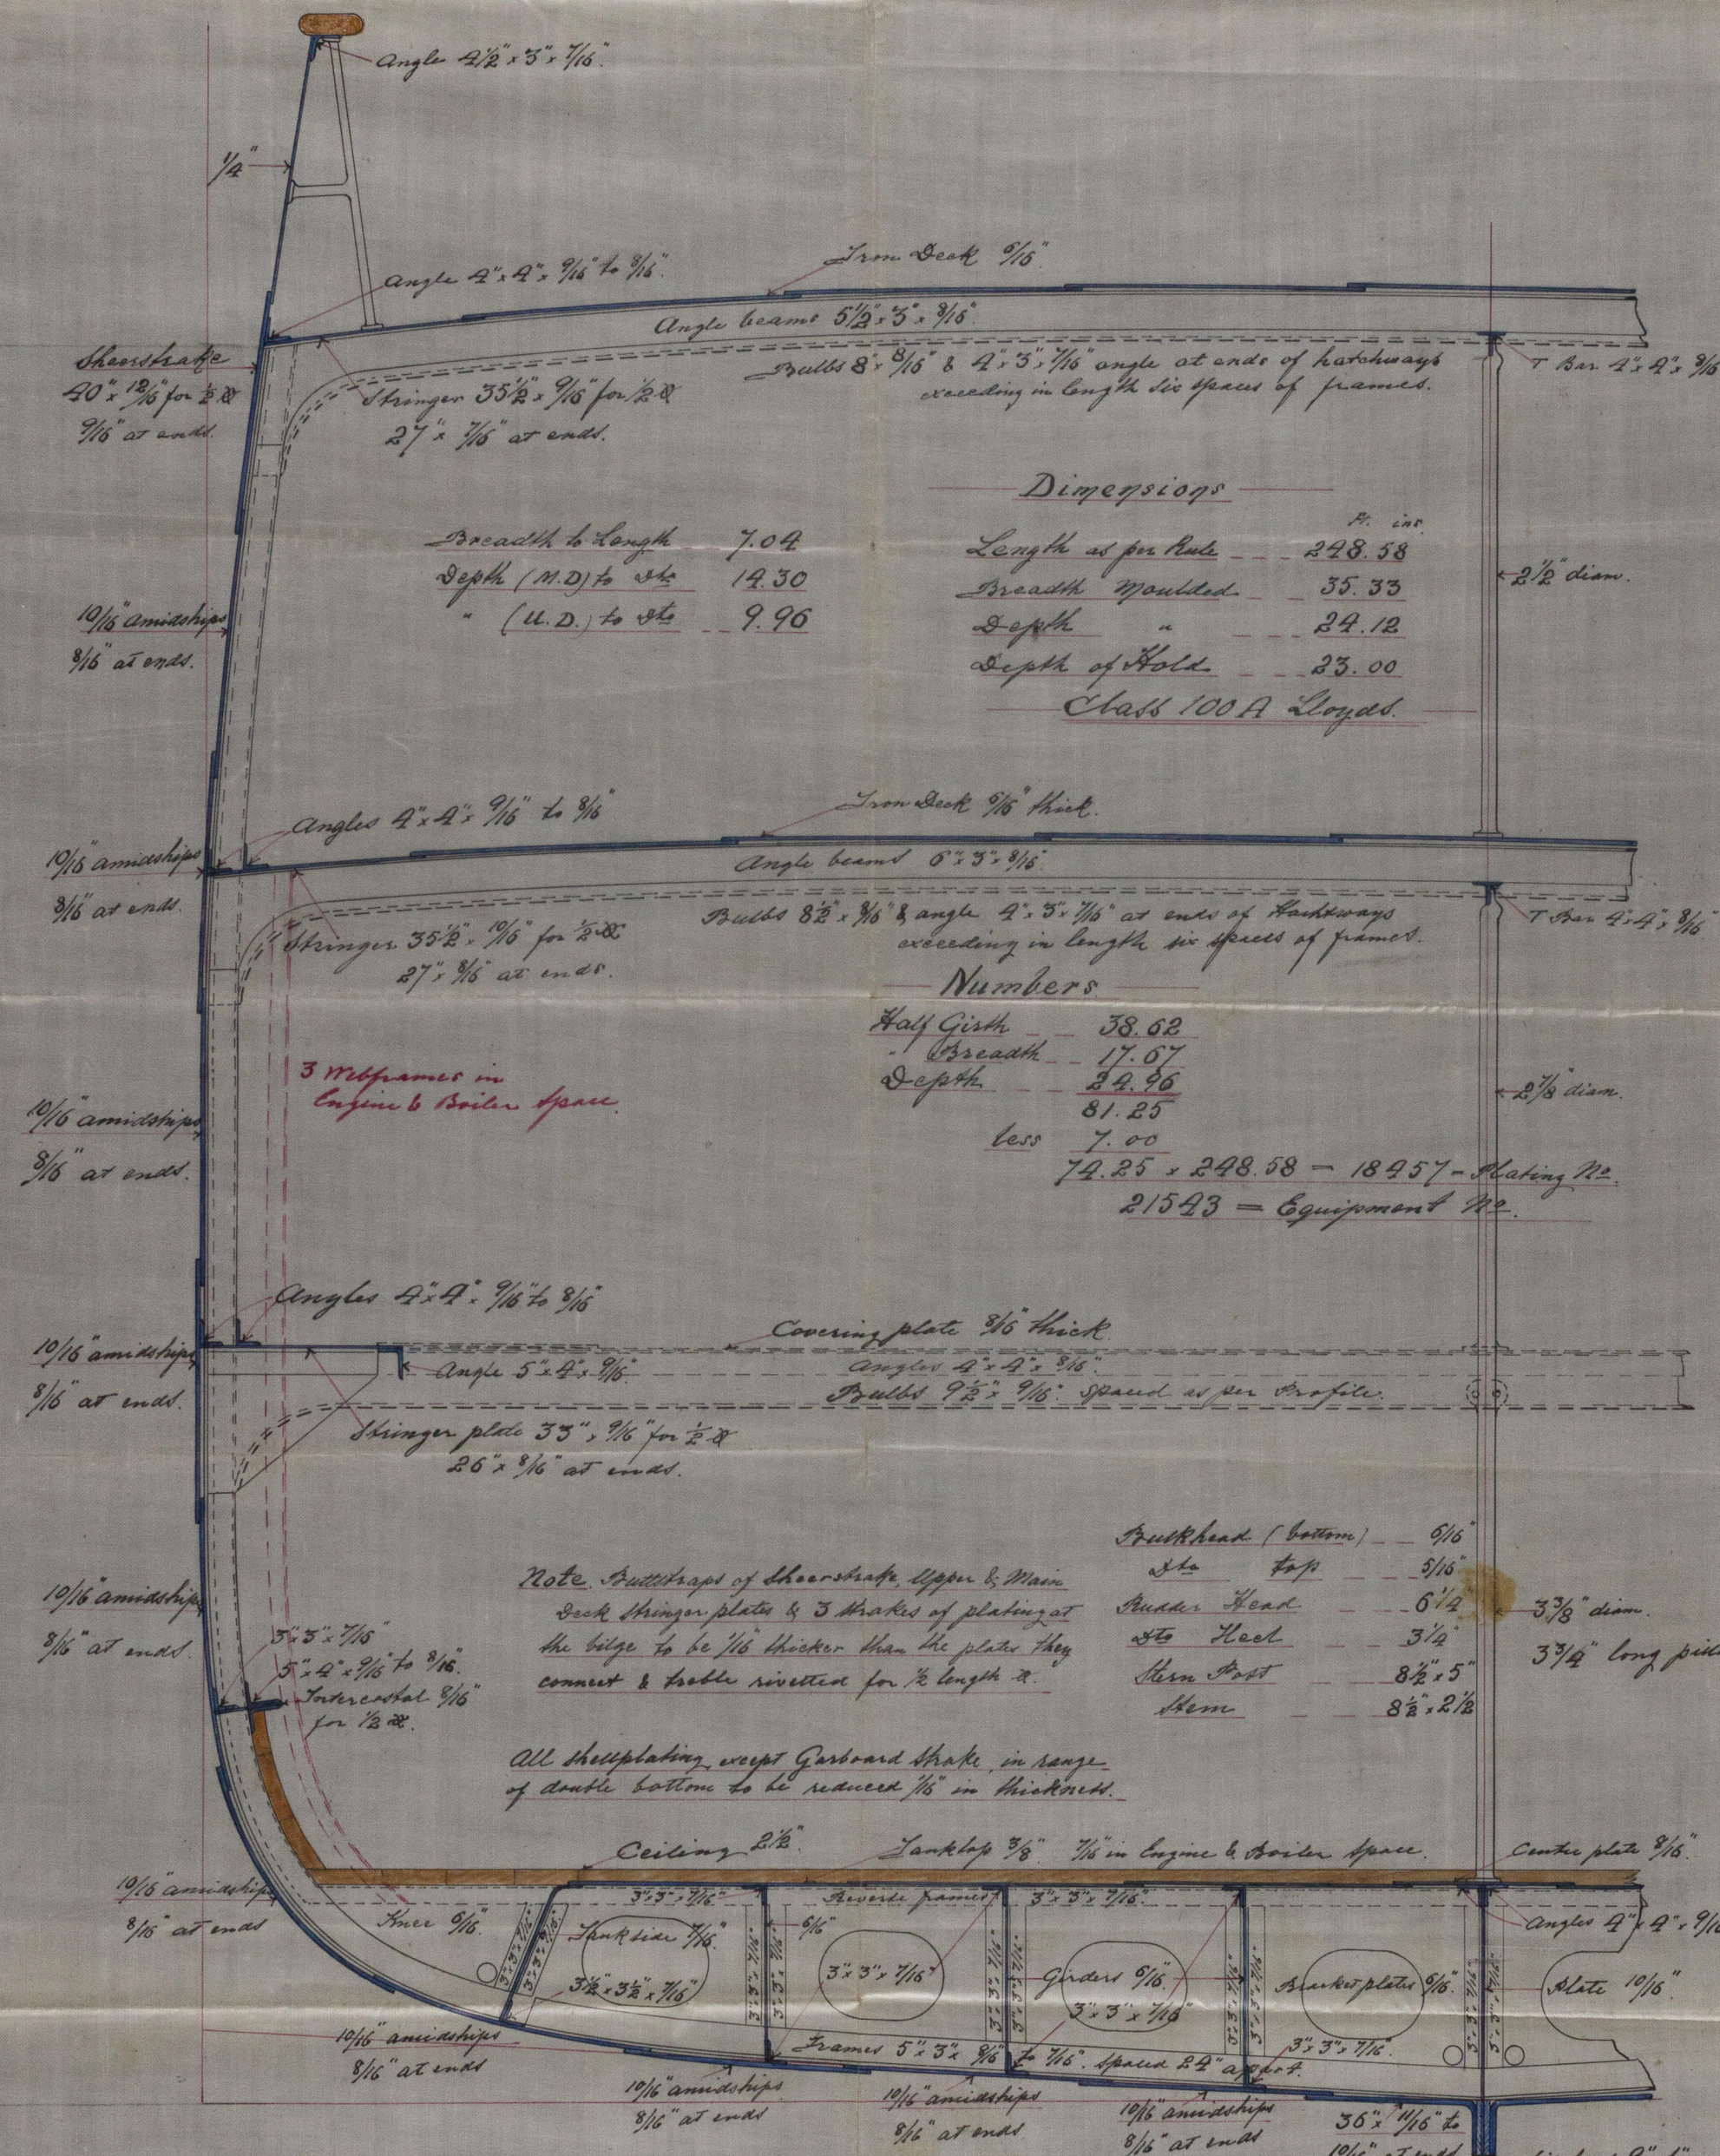

1880  
3/1/81