




S.S. "Largo Bay" Nwe. Report No. 15566
LONGITUDINAL SECTION FOR IRON SCREW STEAMER No. 223
TO CLASS 100 A. THREE DECK AT LLOYDS.

Scale 1/8" = 1 ft

1/2 Girth -- 38.16
1/2 Beam -- 14.00
Depth -- 25.41
80.57
73.57
260
19.128 ht. for Lloyds

Breadths to length -- 7.66
Depths to V. D -- 10.23
Depths to M. D -- 14.52

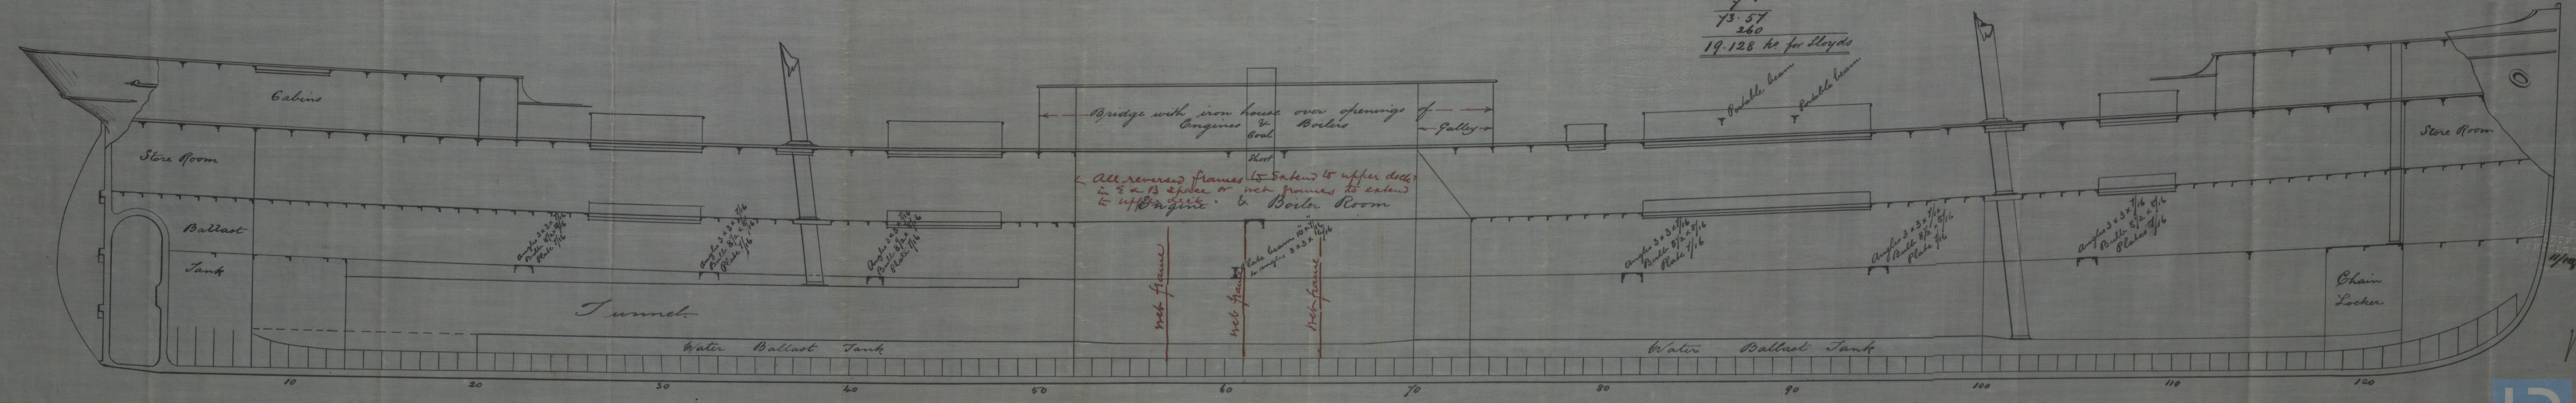



