


Scale $\frac{1}{2}'' = 1' 0''$

S.S. "Largo Bay" Ave Report No. 15566 MIDSHIP SECTION No 223

Principal Dimensions
Length between perp^s ----- 260.0
Beam moulded ----- 34.0
Depth top of floors to top of ---
upper deck beam amidships } --- 23.6

100 A

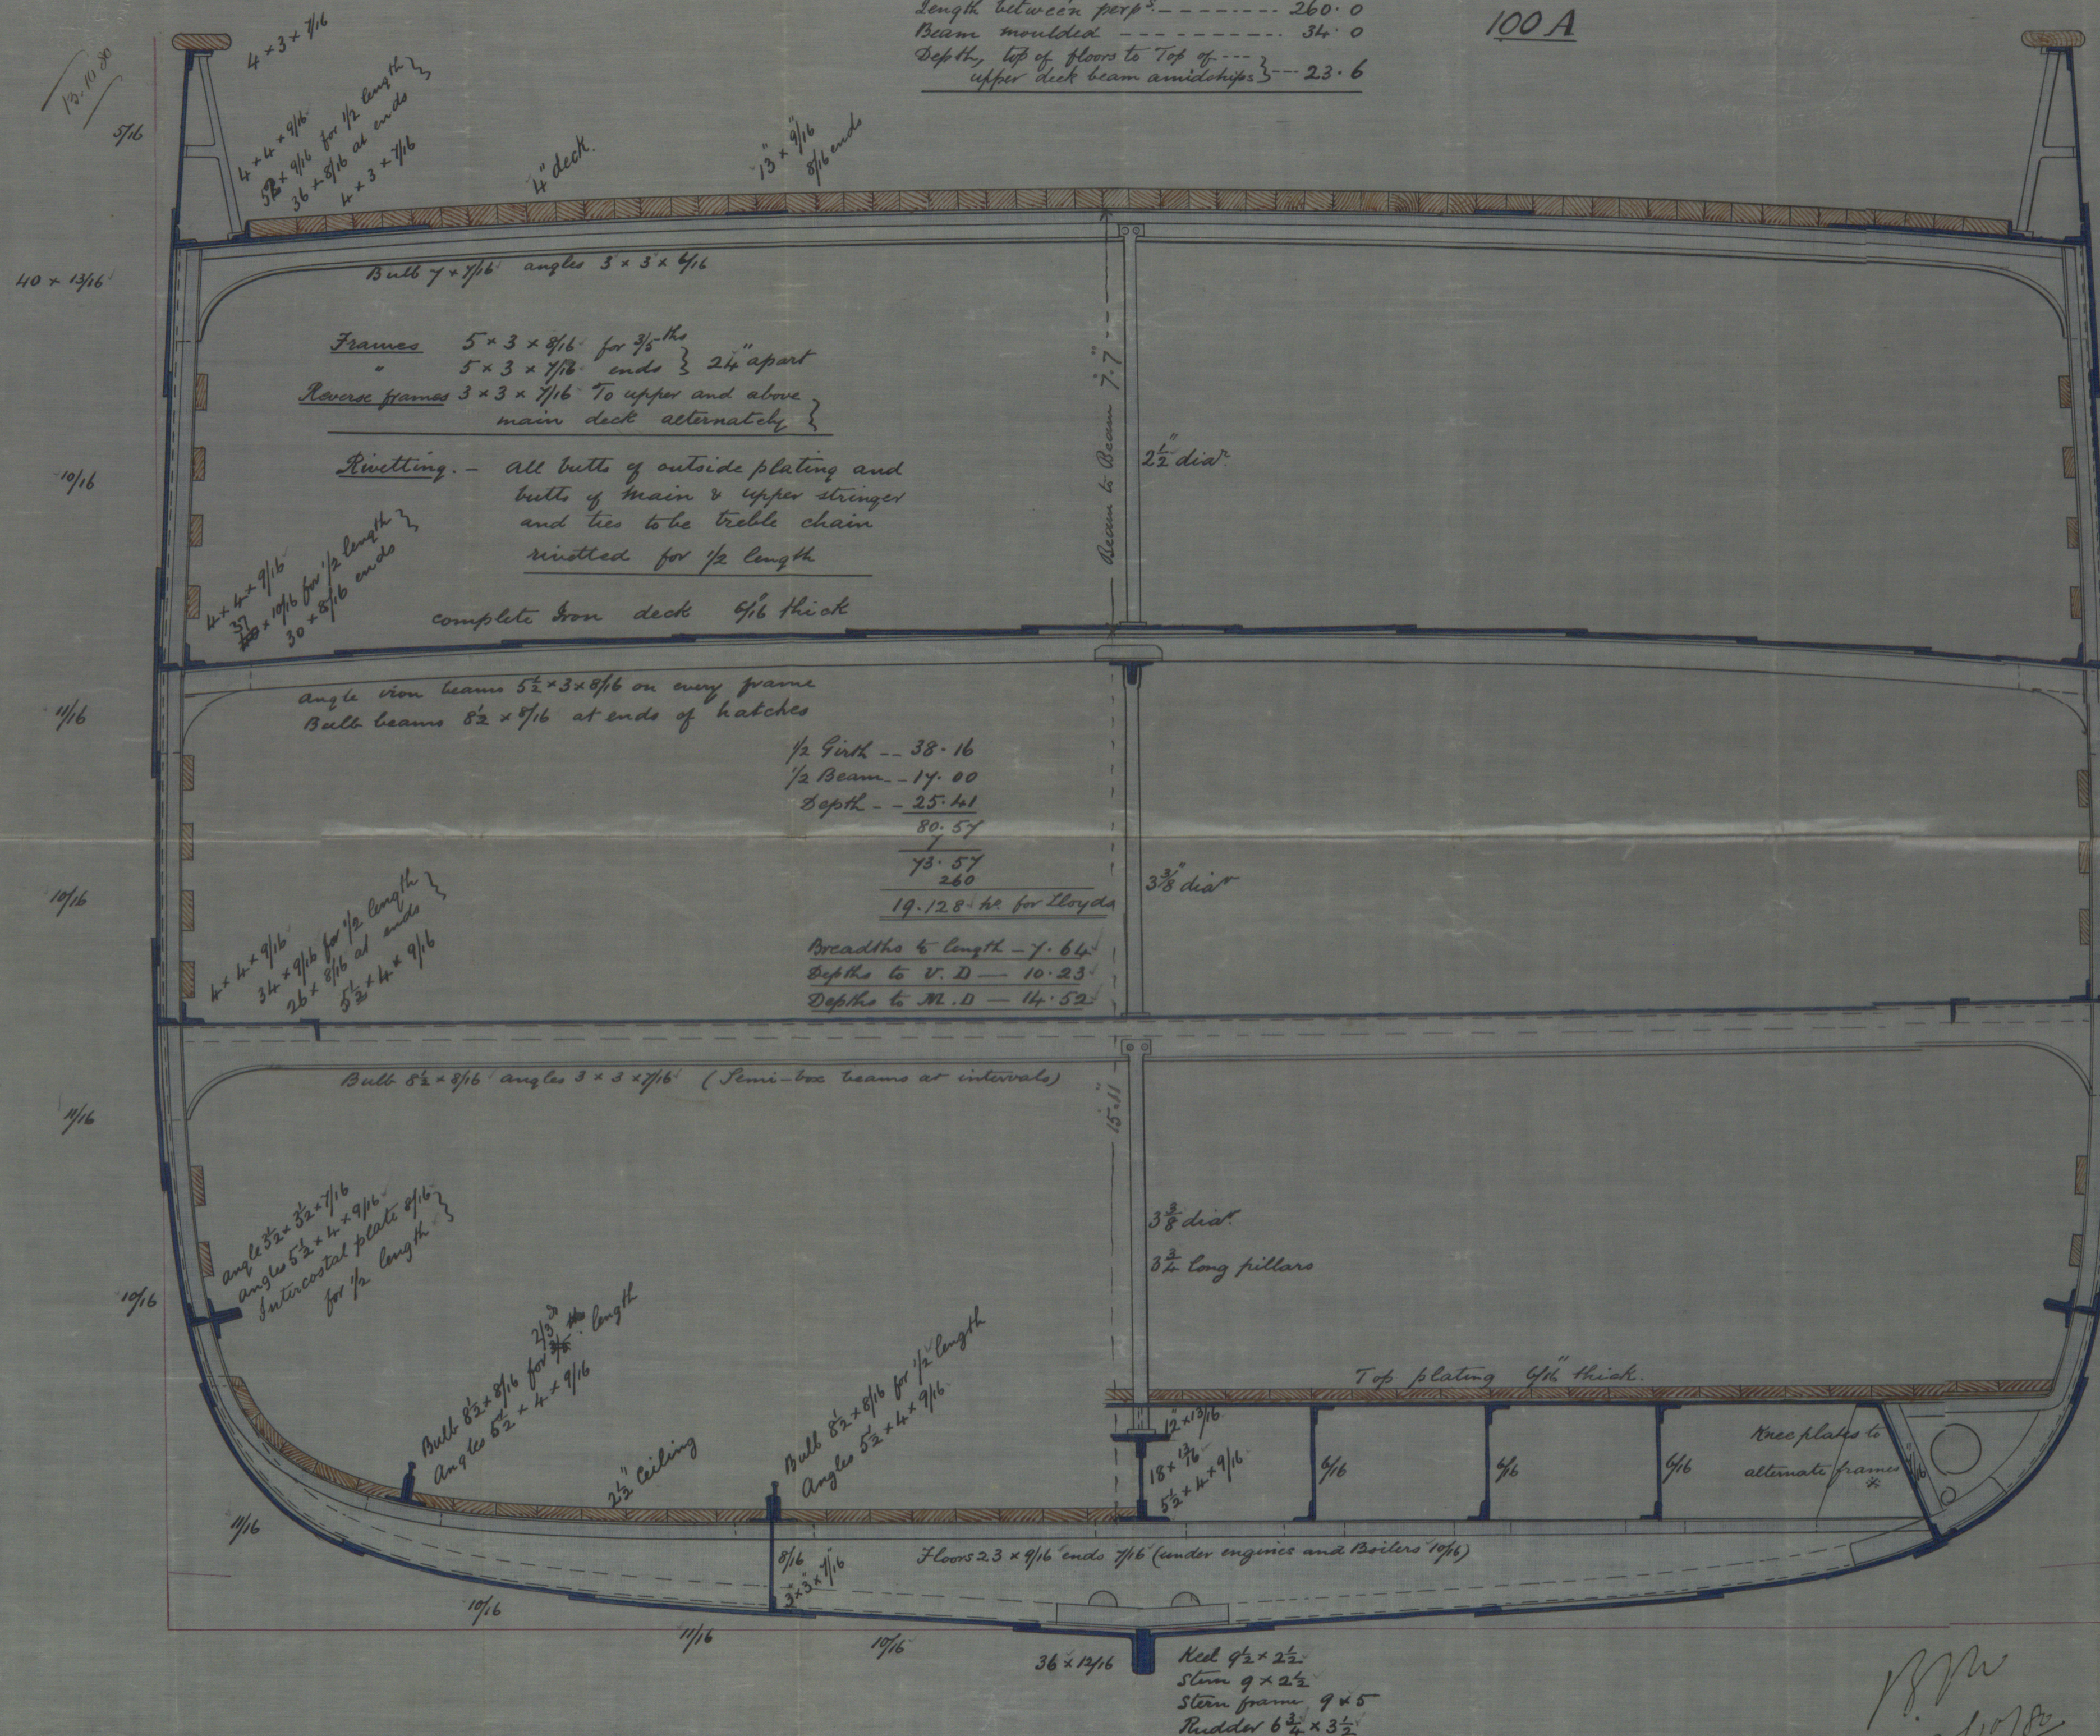

1872
12/10/80