


Palmer's Shipbuilding
JARROW.
April 8, 1990
and Iron Co., Limited

S. S. "Darien" Awe. Report No. 15454
S S. "Principia" " " " 15731

Ballast Suctions Pumping Arrangement. No 44 & ship & 448 Ship
Scale's = one foot.

13/4/87

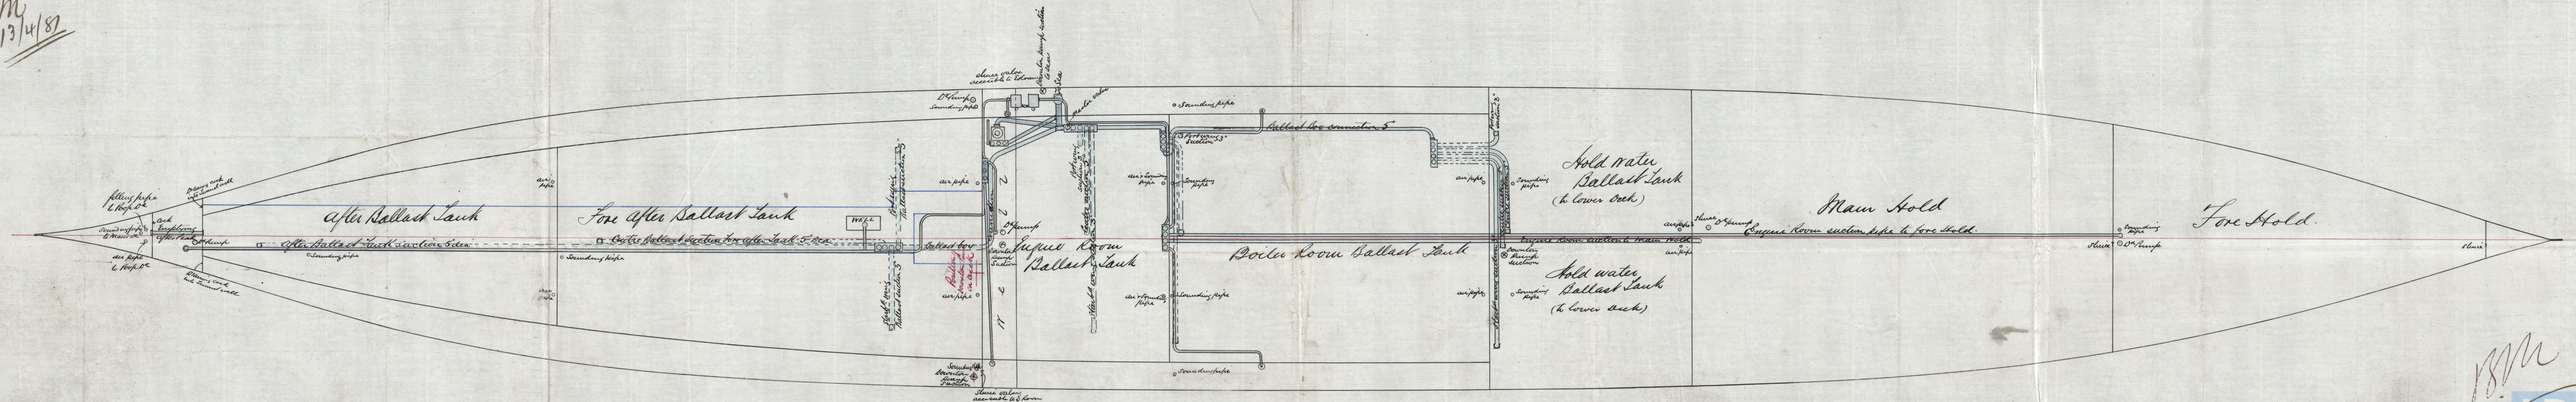


12/4/81

1872



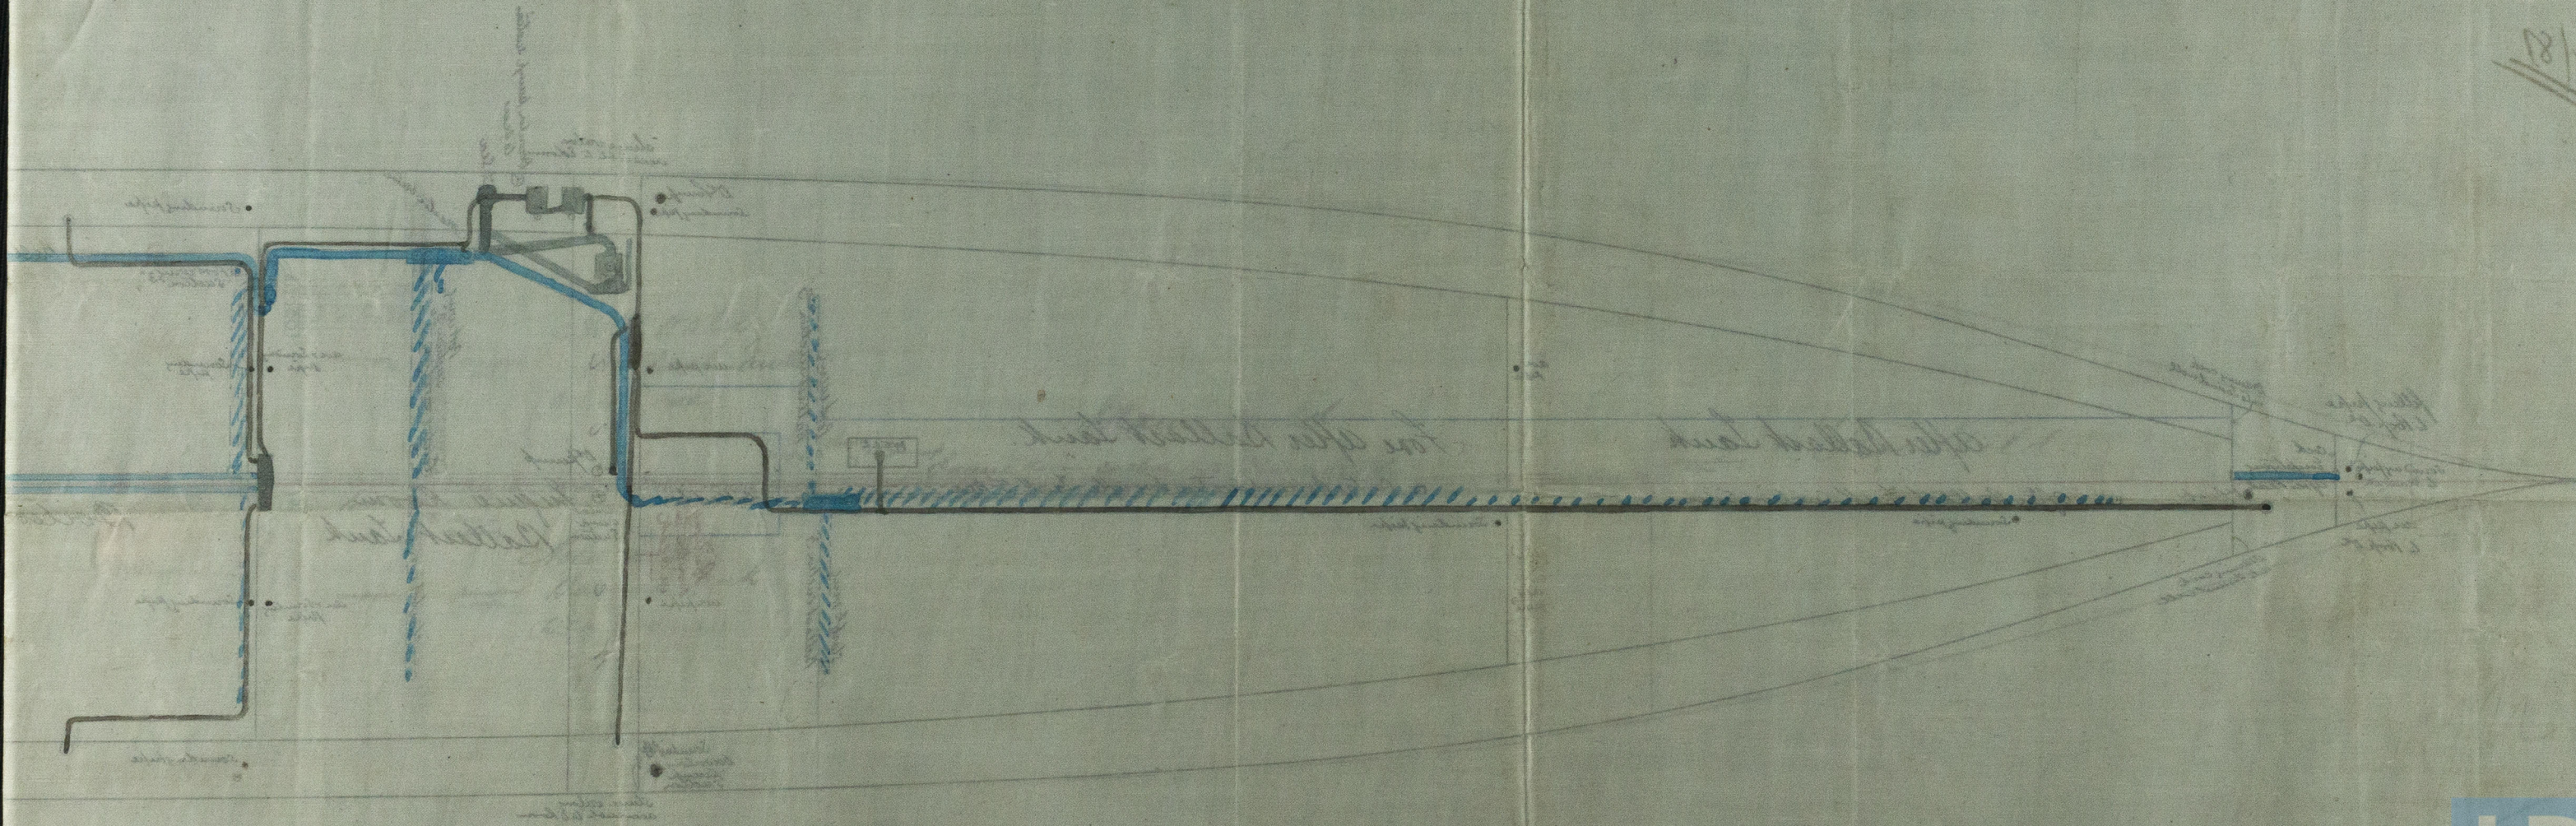

18/4/81



© 2021

Lloyd's Register
Foundation

NWC 780-0027