



See to N.B. 1881
5 July 1881

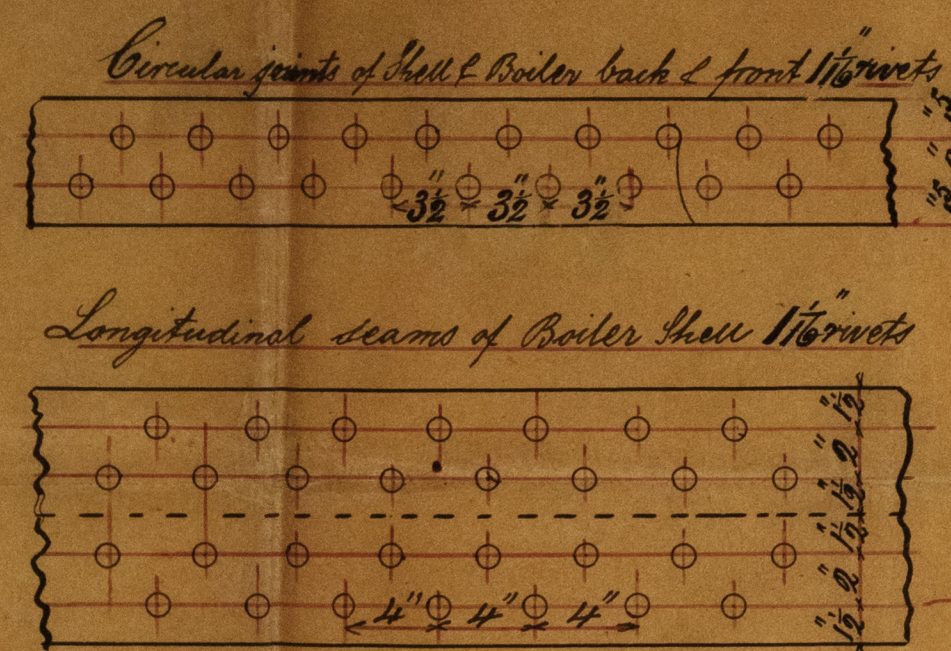

Iron 22 brn
Steel 26 brn

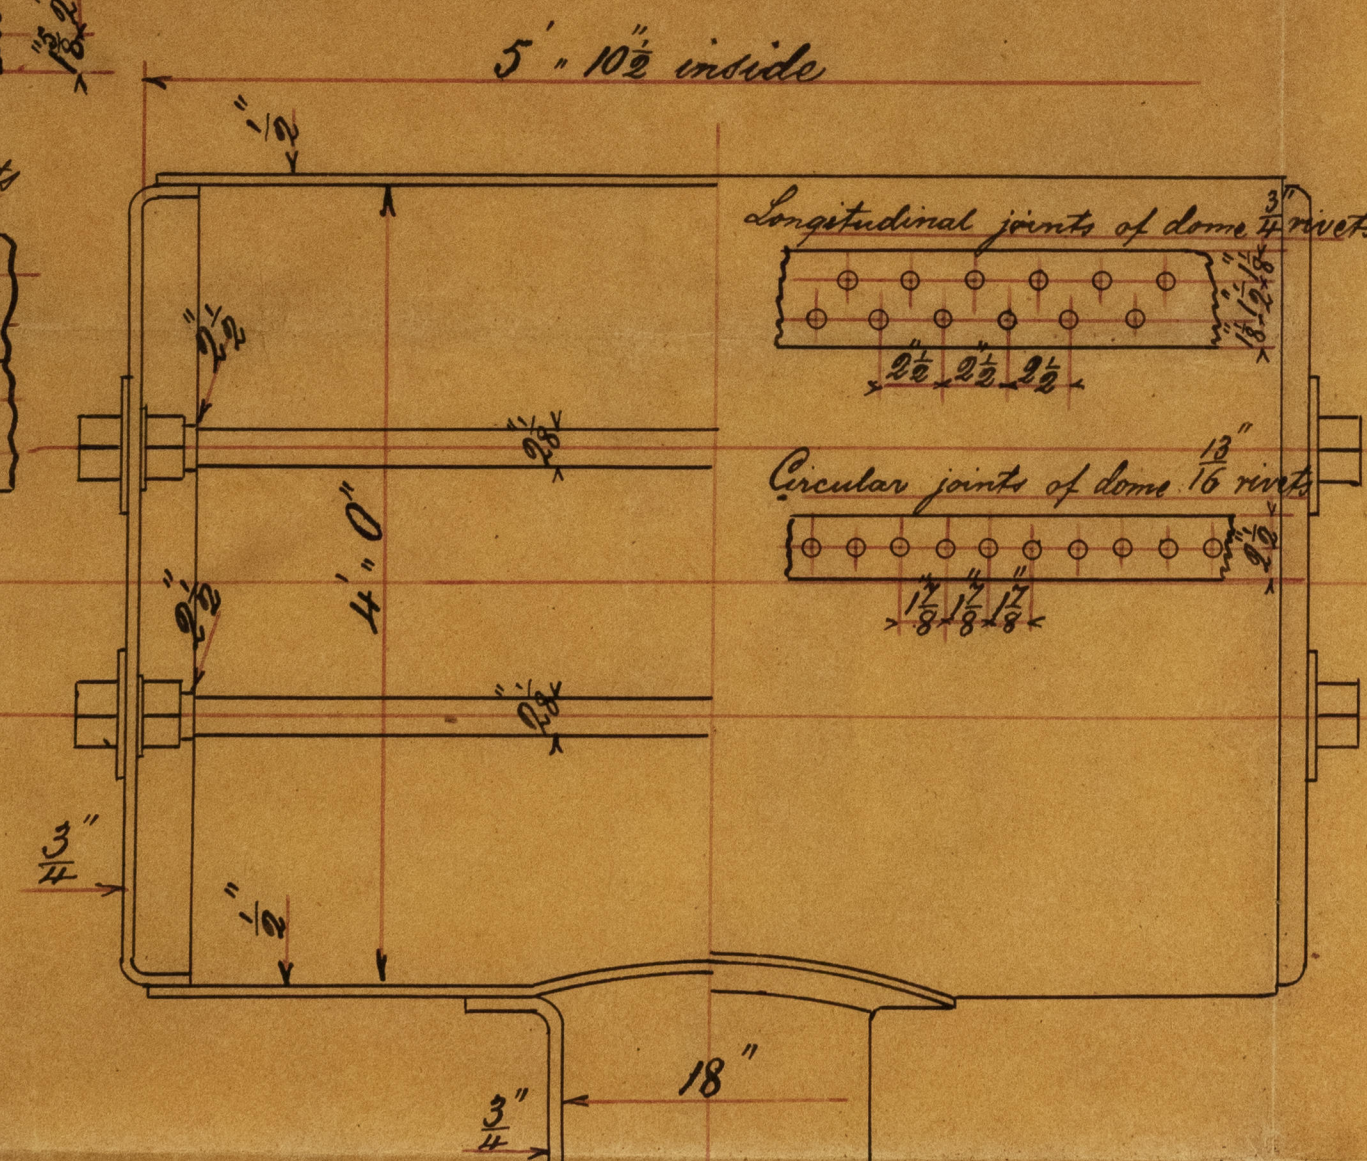

Steel Boilers No 1120

Working Pressure 80 lbs

Longitudinal seams of shell Double butt strapped



All holes in shell plates drilled in place

Messrs Campbell, Mackintosh & Bowstead's No 2 S.S.


Tracing No 1287

Scale 1" = 1 Foot


Iron Stay bolts - tubes & rivets

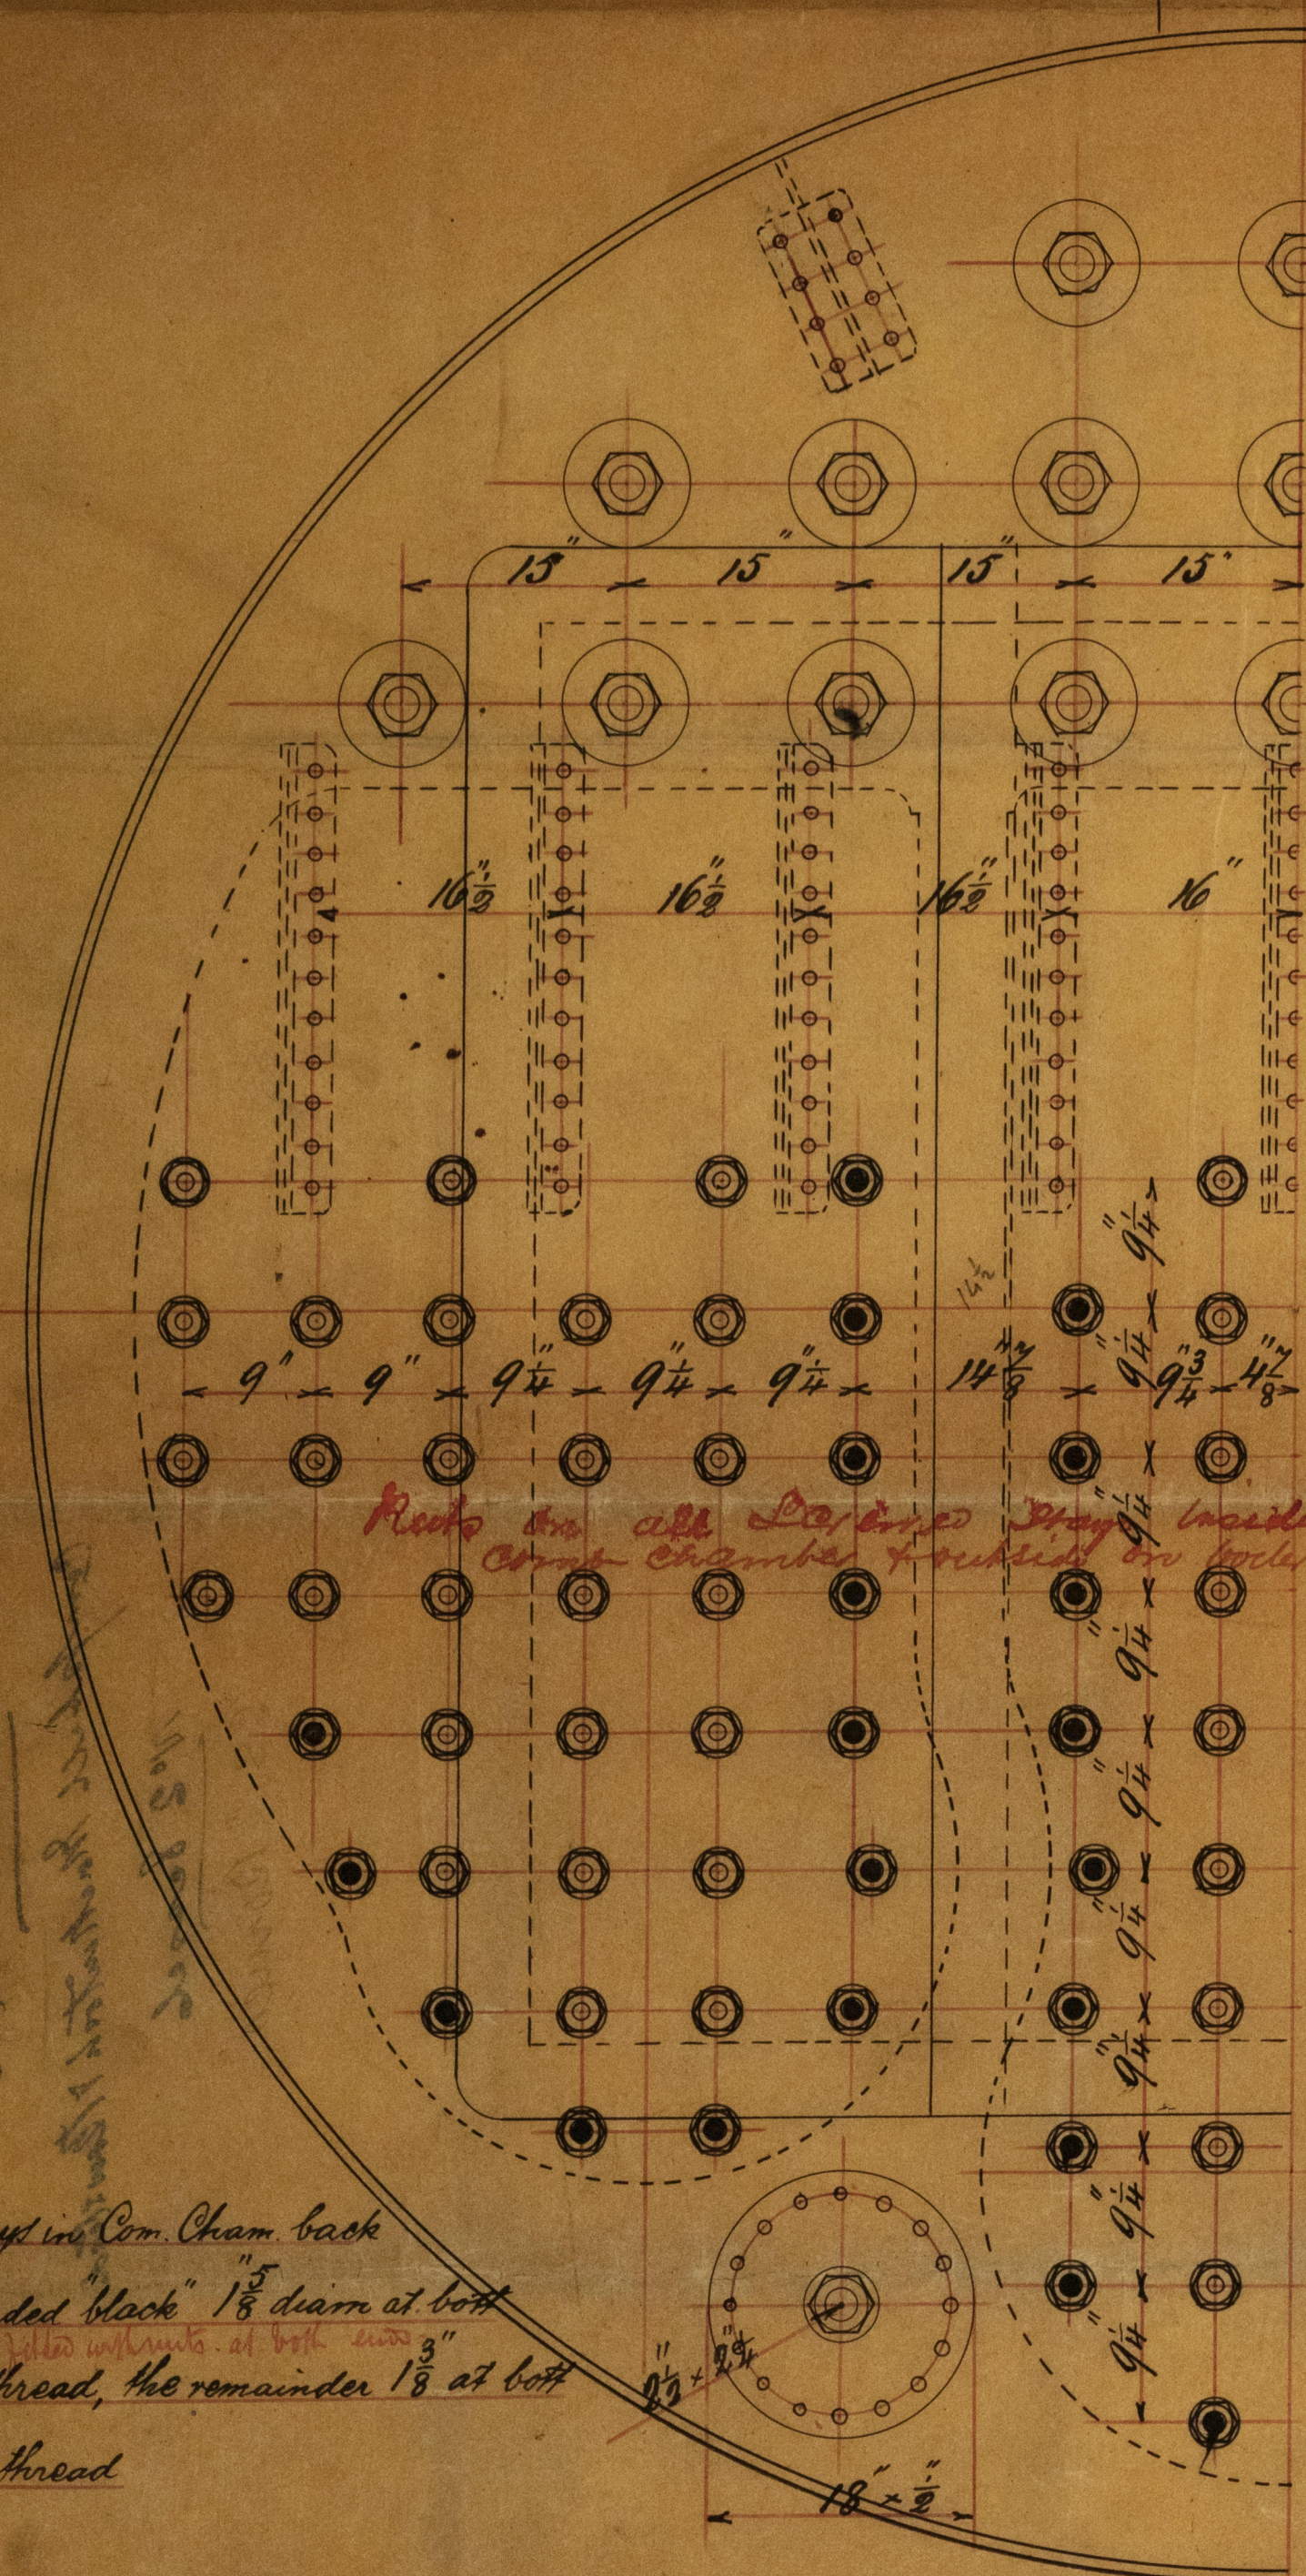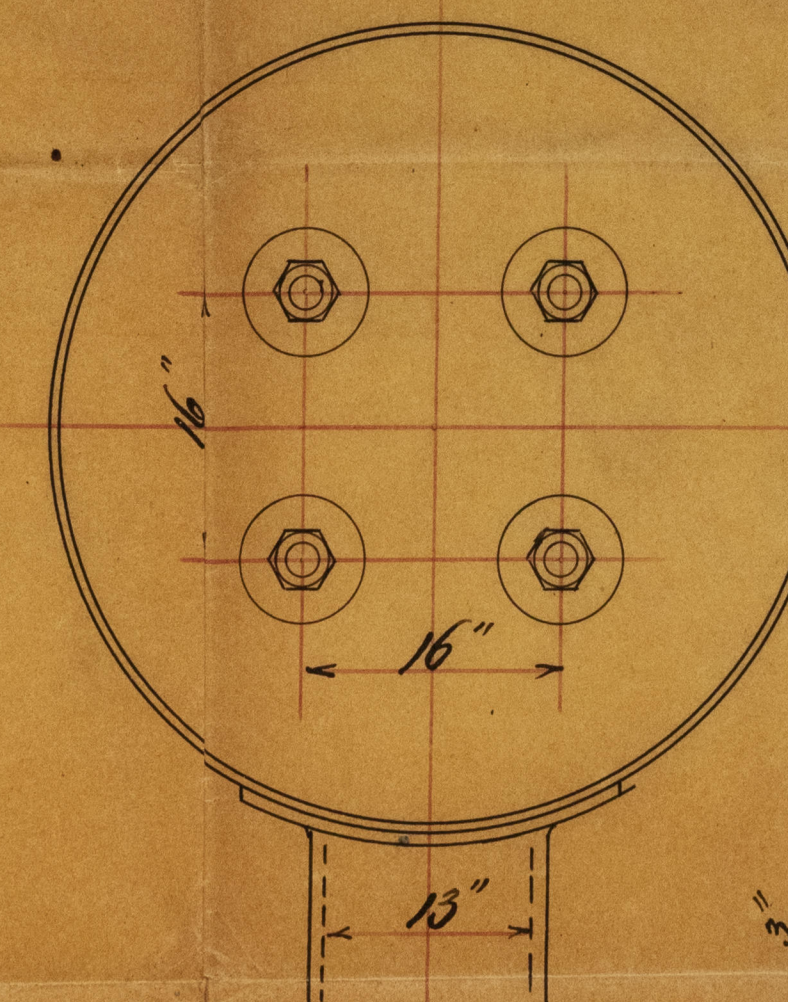

10' 0"

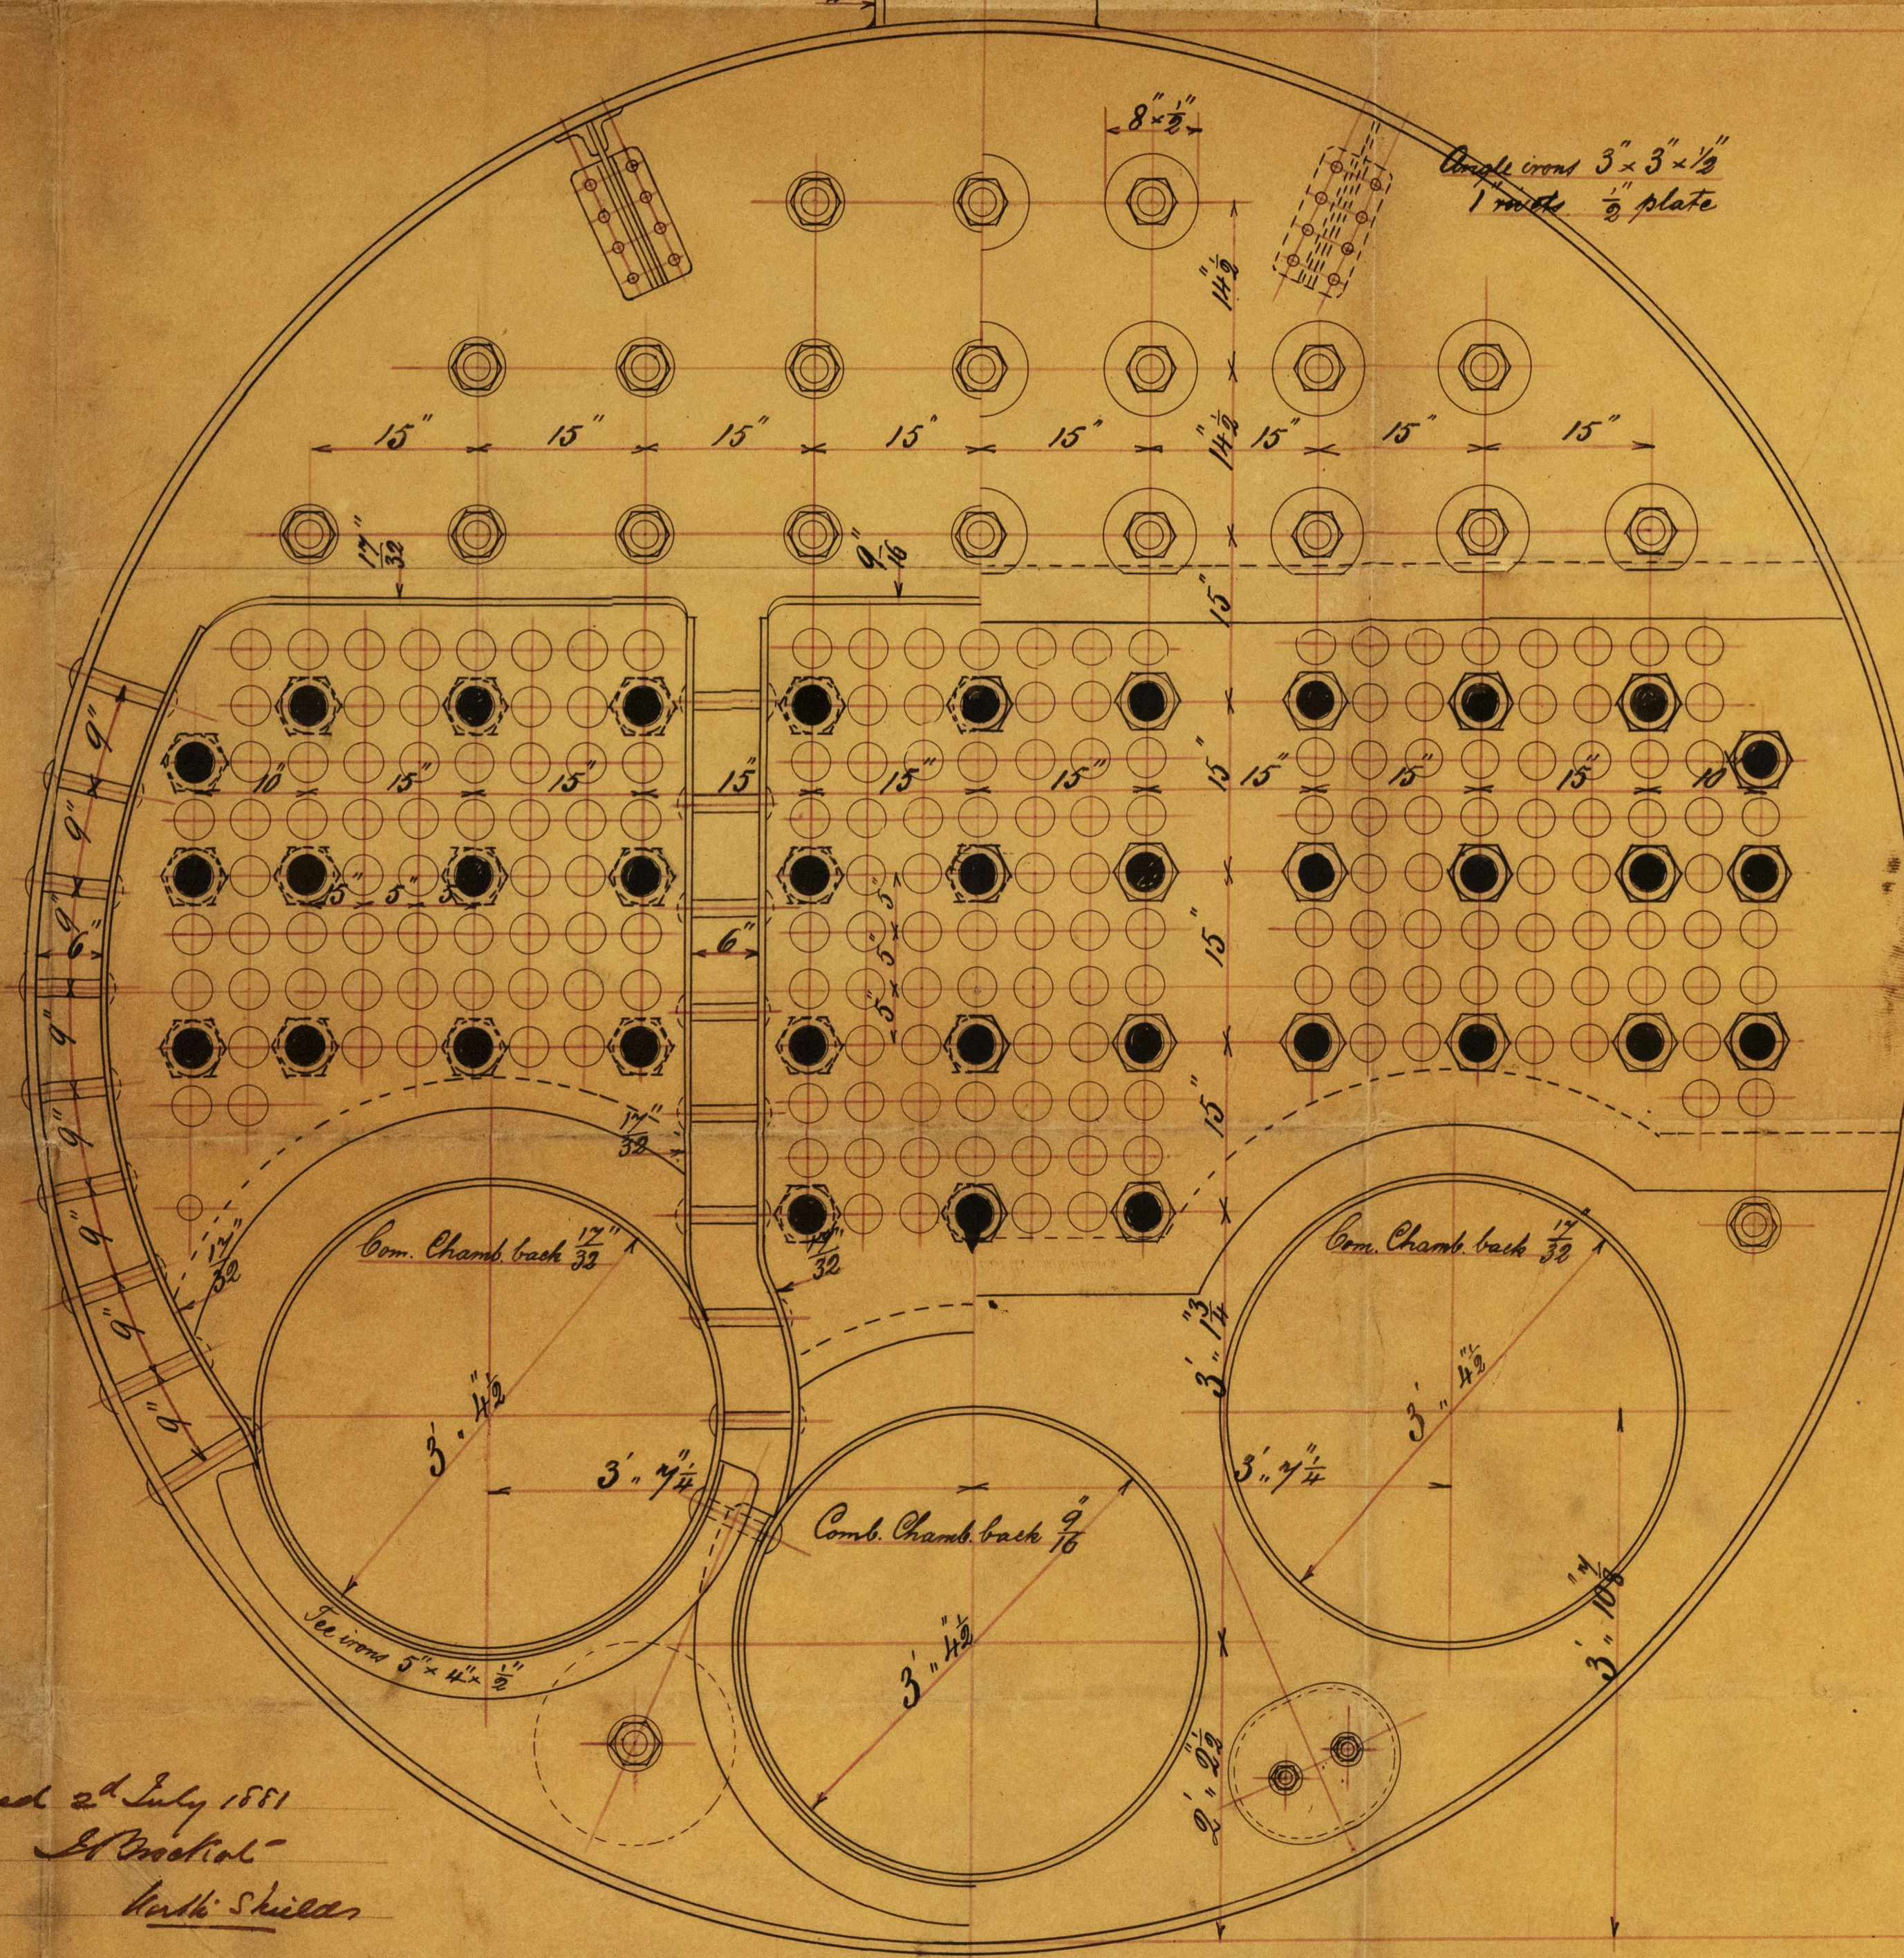

Examined 2nd July 1881
St. Bowstead
Ruth. Stiles

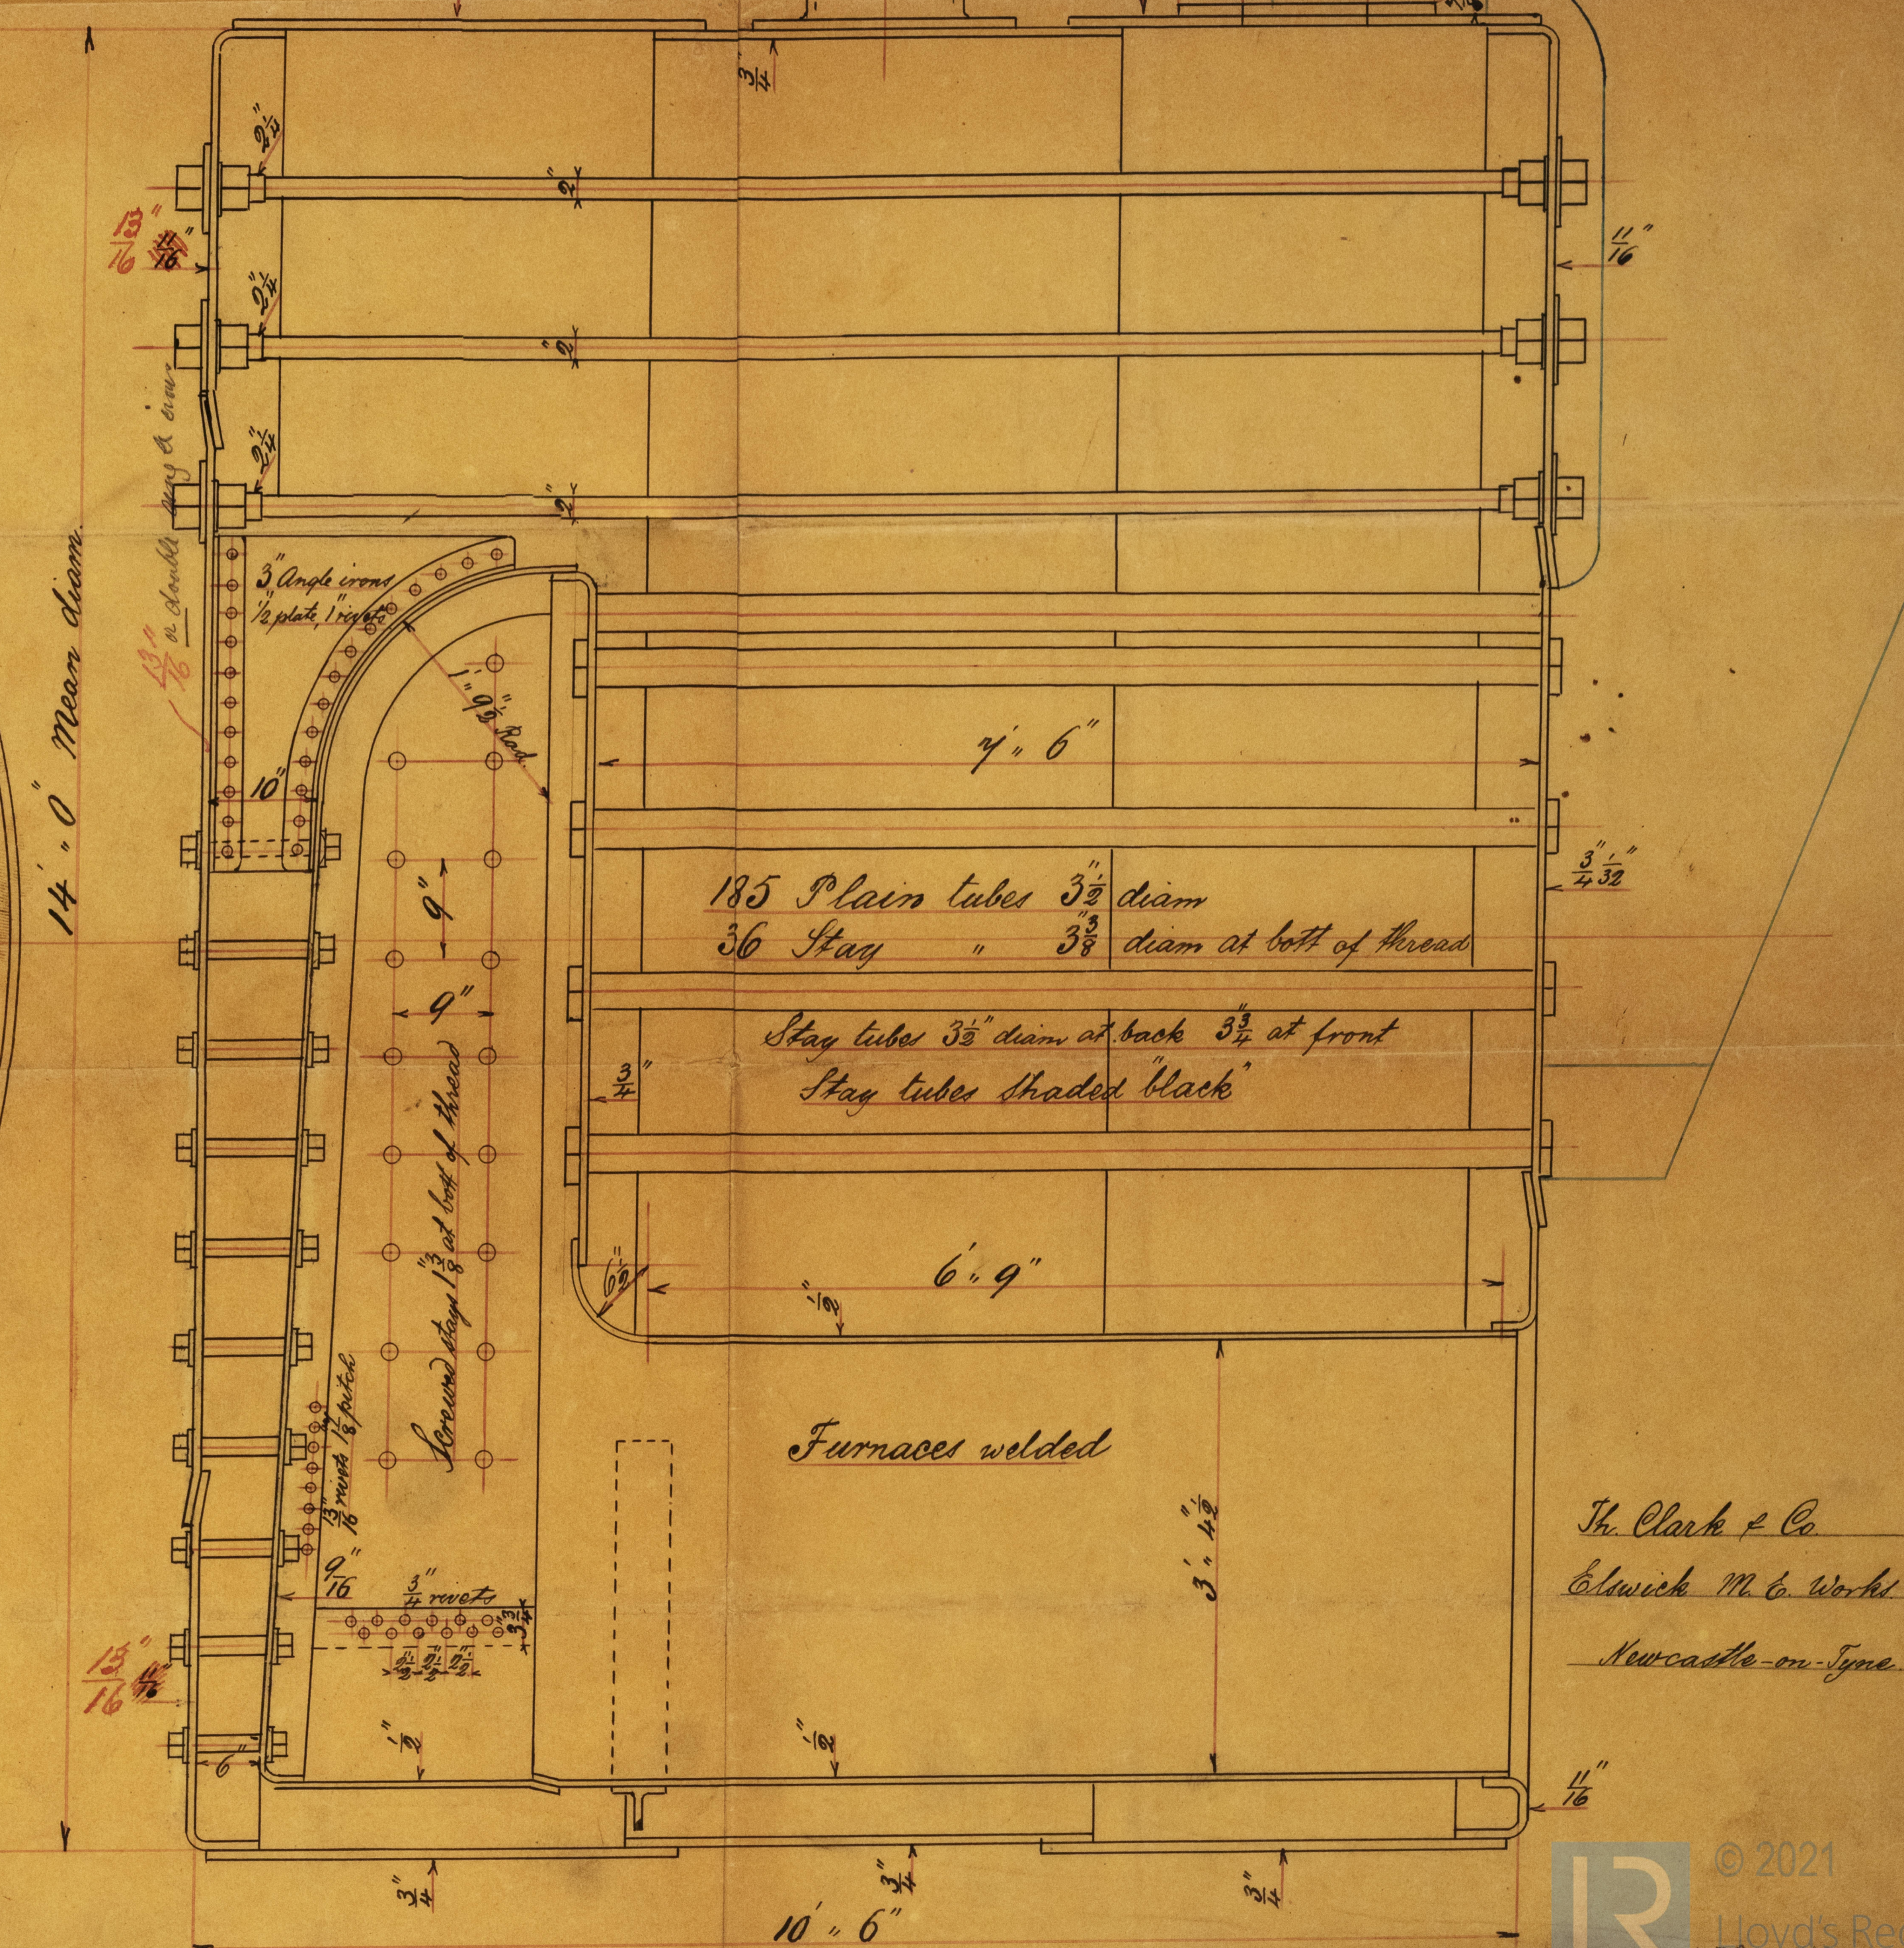

The Clark & Co
Elswick M. & Works
Newcastle-on-Tyne

Steel Coiler

Campbell MacKintosh & Newstead

Nº 2 Bessel

SS. "Borneo"

NWC 780-0120

NWC 780-0120



© 2021

Lloyd's Register
Foundation