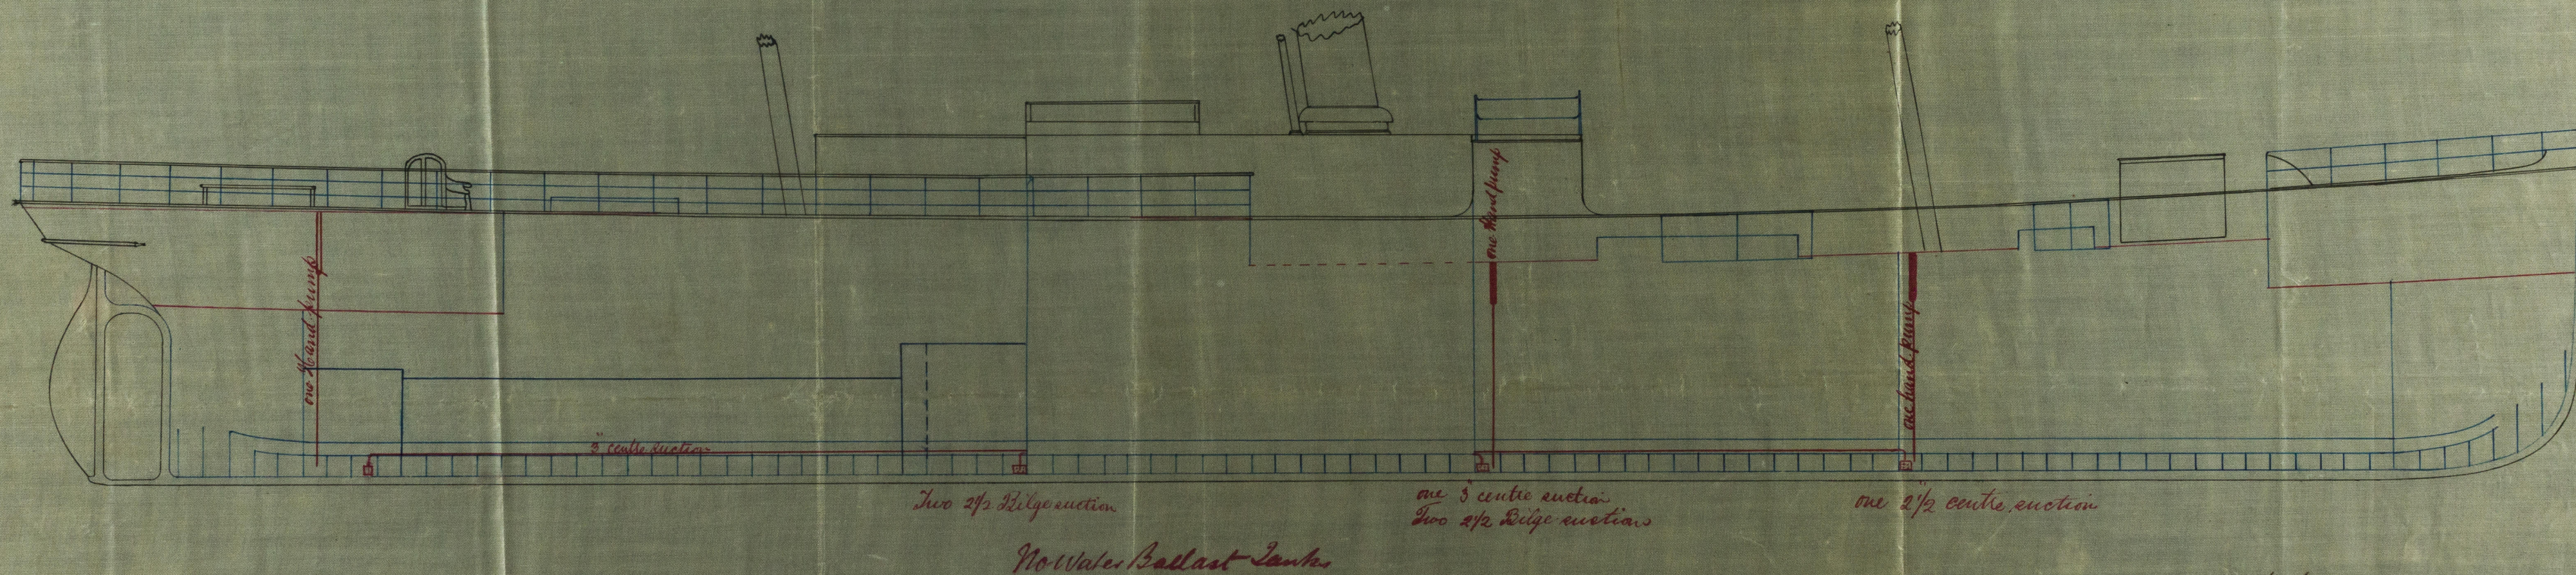

 Dr to N. Shlds
 15 Decr/81

S.S. "Borneo" Nwc. Report No. 15804

Pumping Arrangement S.S. No. 2
 Scale 1 inch = one foot

M
 14.12.81



LB

160
 13/12/81
 LB

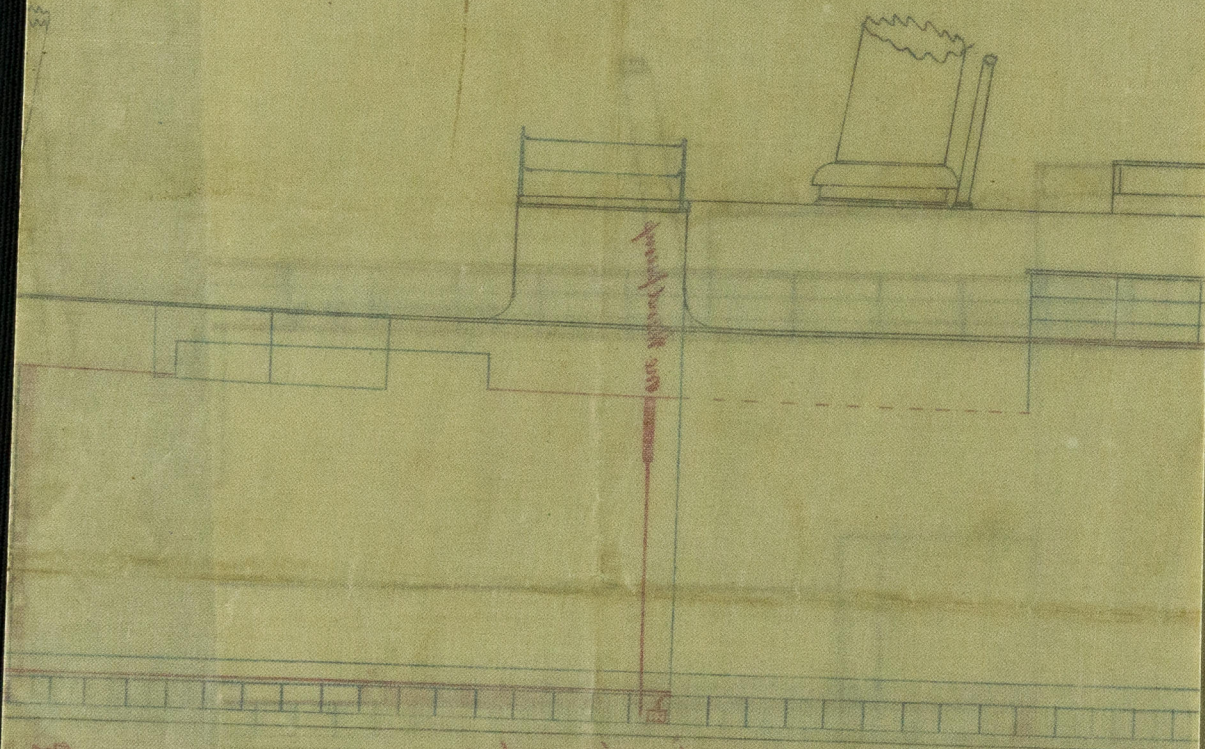


Lloyd's Register
 Foundation
 NW0780-0122

"New Report No. 12804"

18.51.41
M

to be removed
to be removed



one of center section
also also section

Robert Jones



© 2021

Lloyd's Register
Foundation

NWC780-0122