


Midship. Section. S. S. No 457.

Scale  $\frac{1}{2}" = 1 \text{ Foot}$

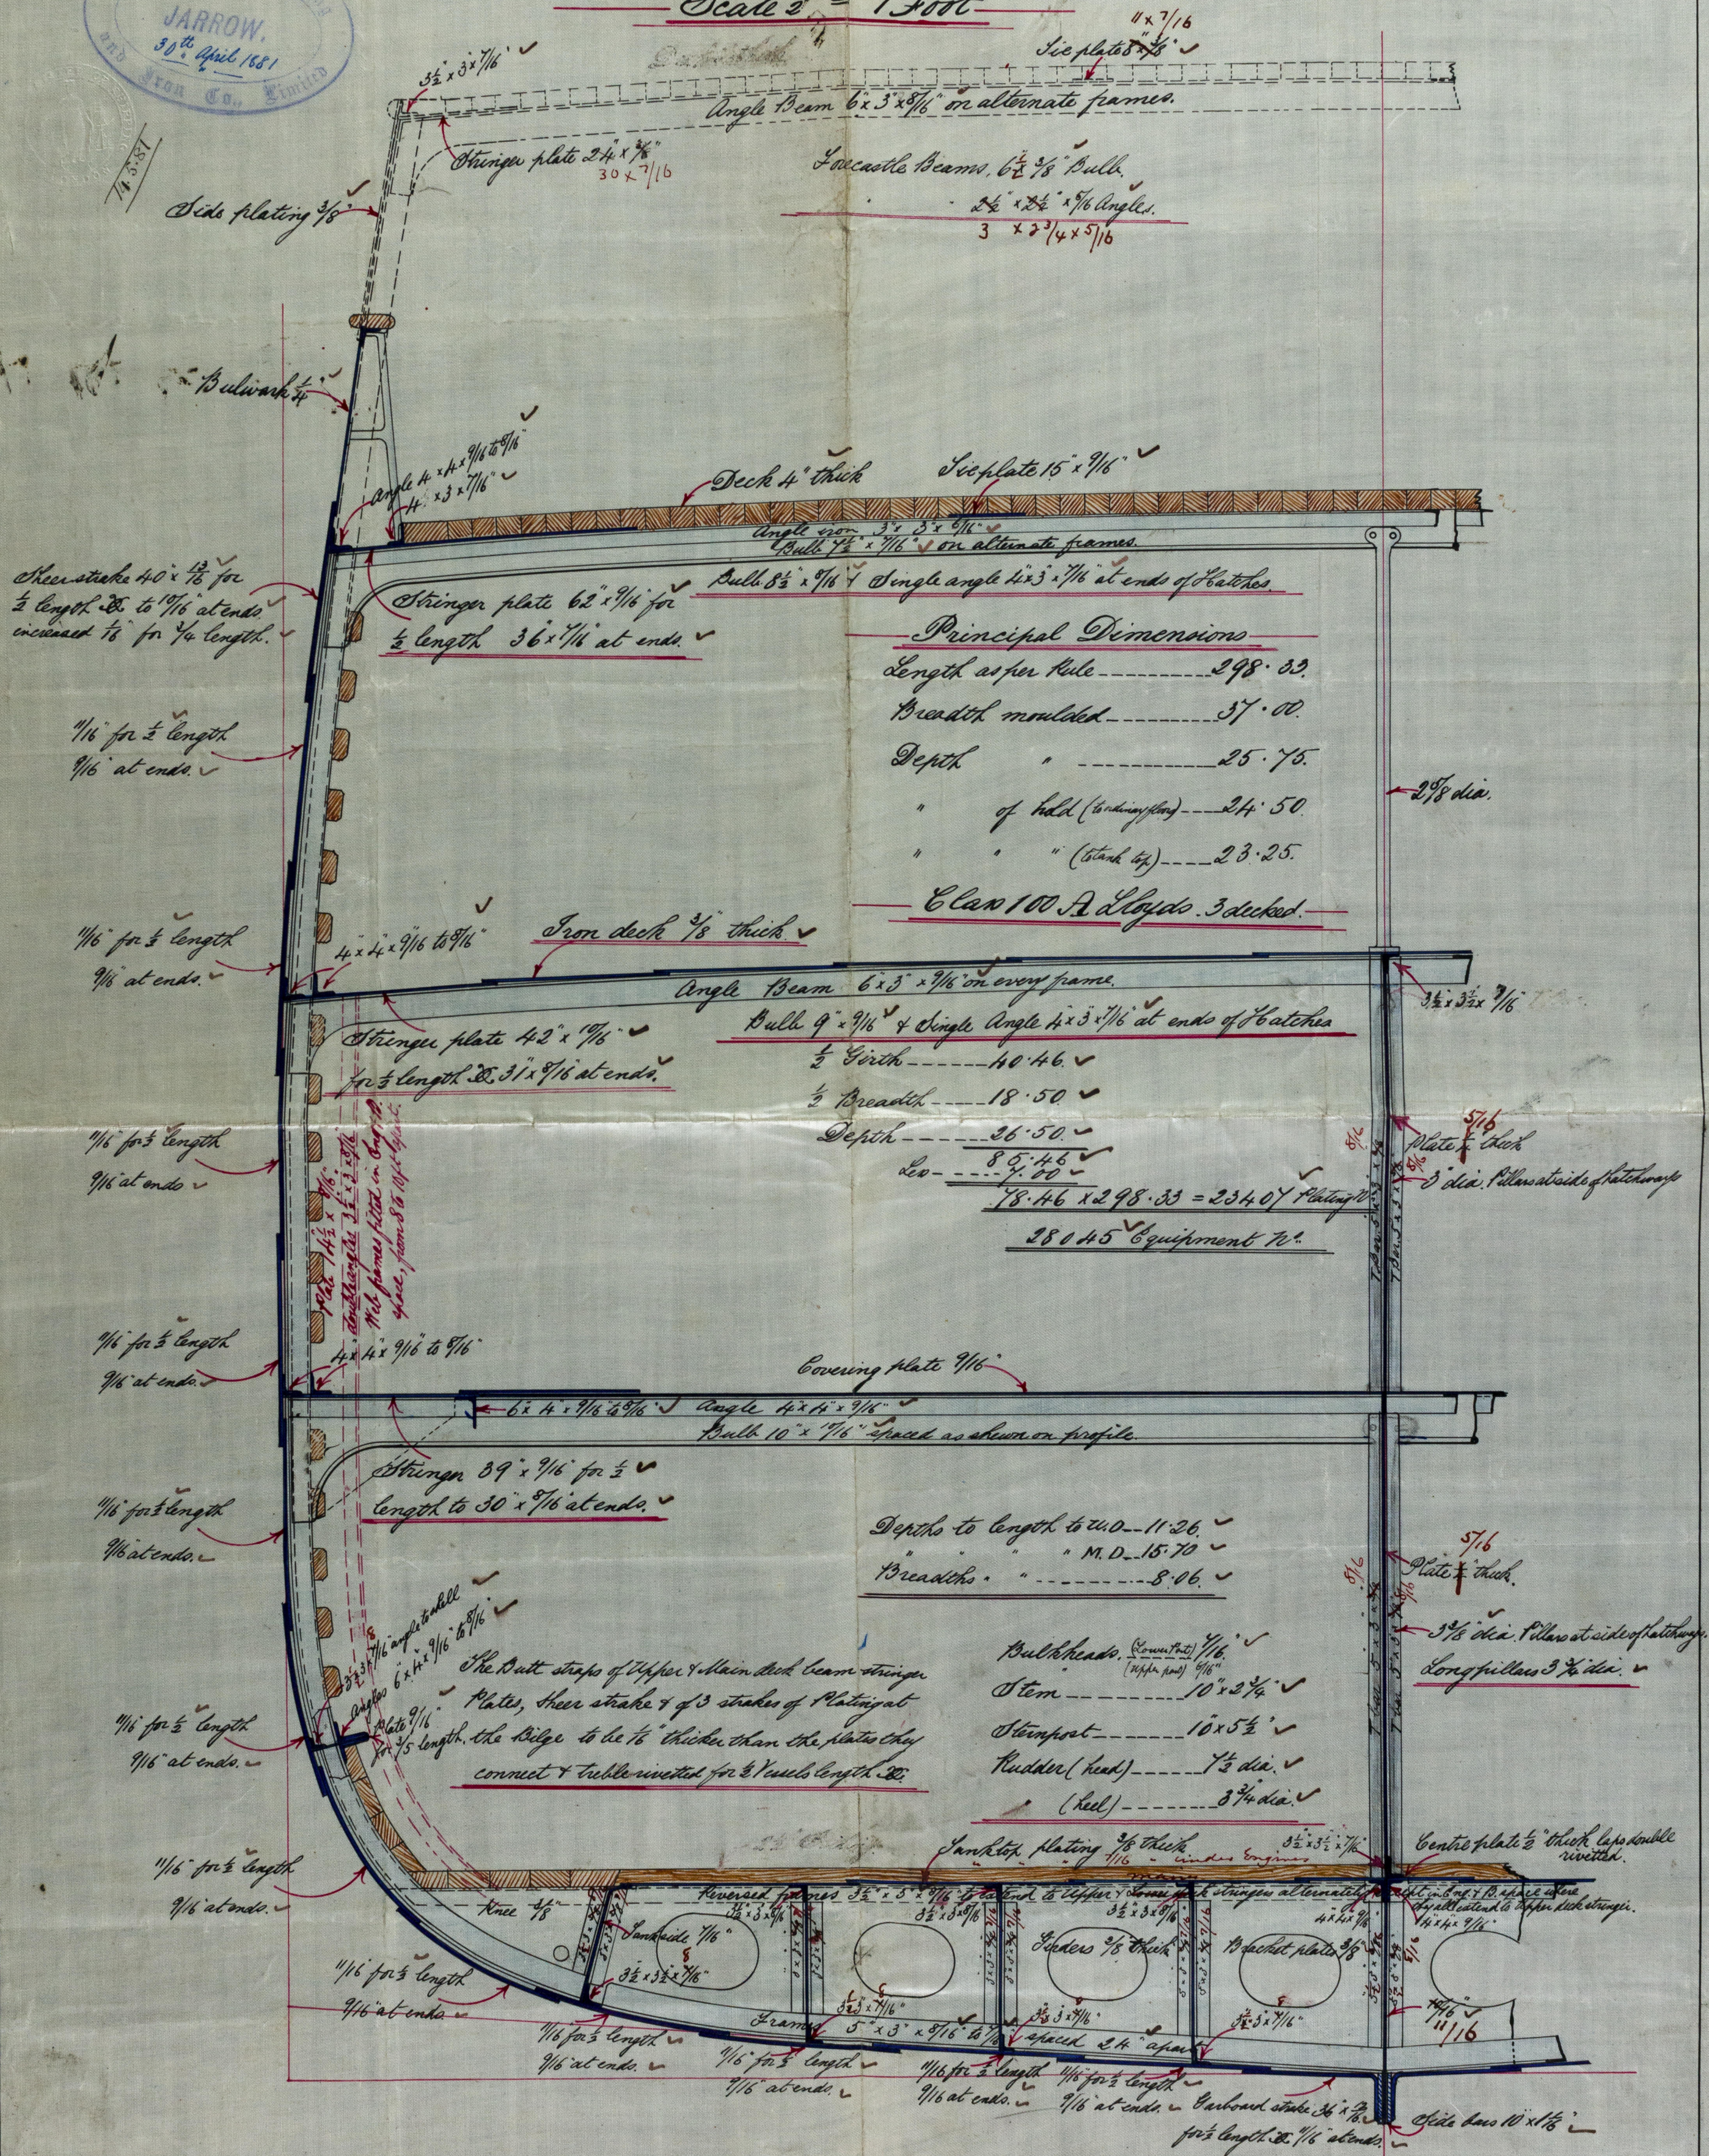

Note. All outside plating (except Garboard stripe) to be reduced.

$\frac{1}{16}$ " in thickness; when  $\frac{10}{16}$  or more, in way of double bottom

14/5/87

12/5/81