

Widship Section

— 35 —


— 36 —

Length ----- 283.5 $\frac{1}{2}$ Girth ----- 39.00
 Breadth ----- 35.79 $\frac{1}{2}$ Breadth ----- 17.99
 Depth to Skin ----- 25.96 Depth ----- 25.96 Equipment
 " of Hoid ----- 24.6 Forelimbs ----- 82.95 + 283.5 = 234.80
 Breadth to Length ----- 7.82 Hind limb 3/4 limb ----- 7.00 add $\frac{1}{2}$ = 23.48
 Depth to Length W.D. ----- 10.92
 " M.D. ----- 14.98
 Class 100 A1
 Length ----- 283.5
 Flank girth ----- 215.54

Grade Numbers $\frac{73}{76}$ & $\frac{18700}{21700}$ Equipment 24220

$$285.0 \times 36.0 \times 24.0$$

2 Boner Anchors	32	0	0	ex Stock
1 Stream	27	1	0	" "
1 Stream	20	2	0	" "
1 Hedge	5	1	0	" "
		2	2	0
270 Tailhorns	1 $\frac{3}{8}$			" "
75	1 $\frac{7}{8}$			" "
				Cable Chain
				Stream

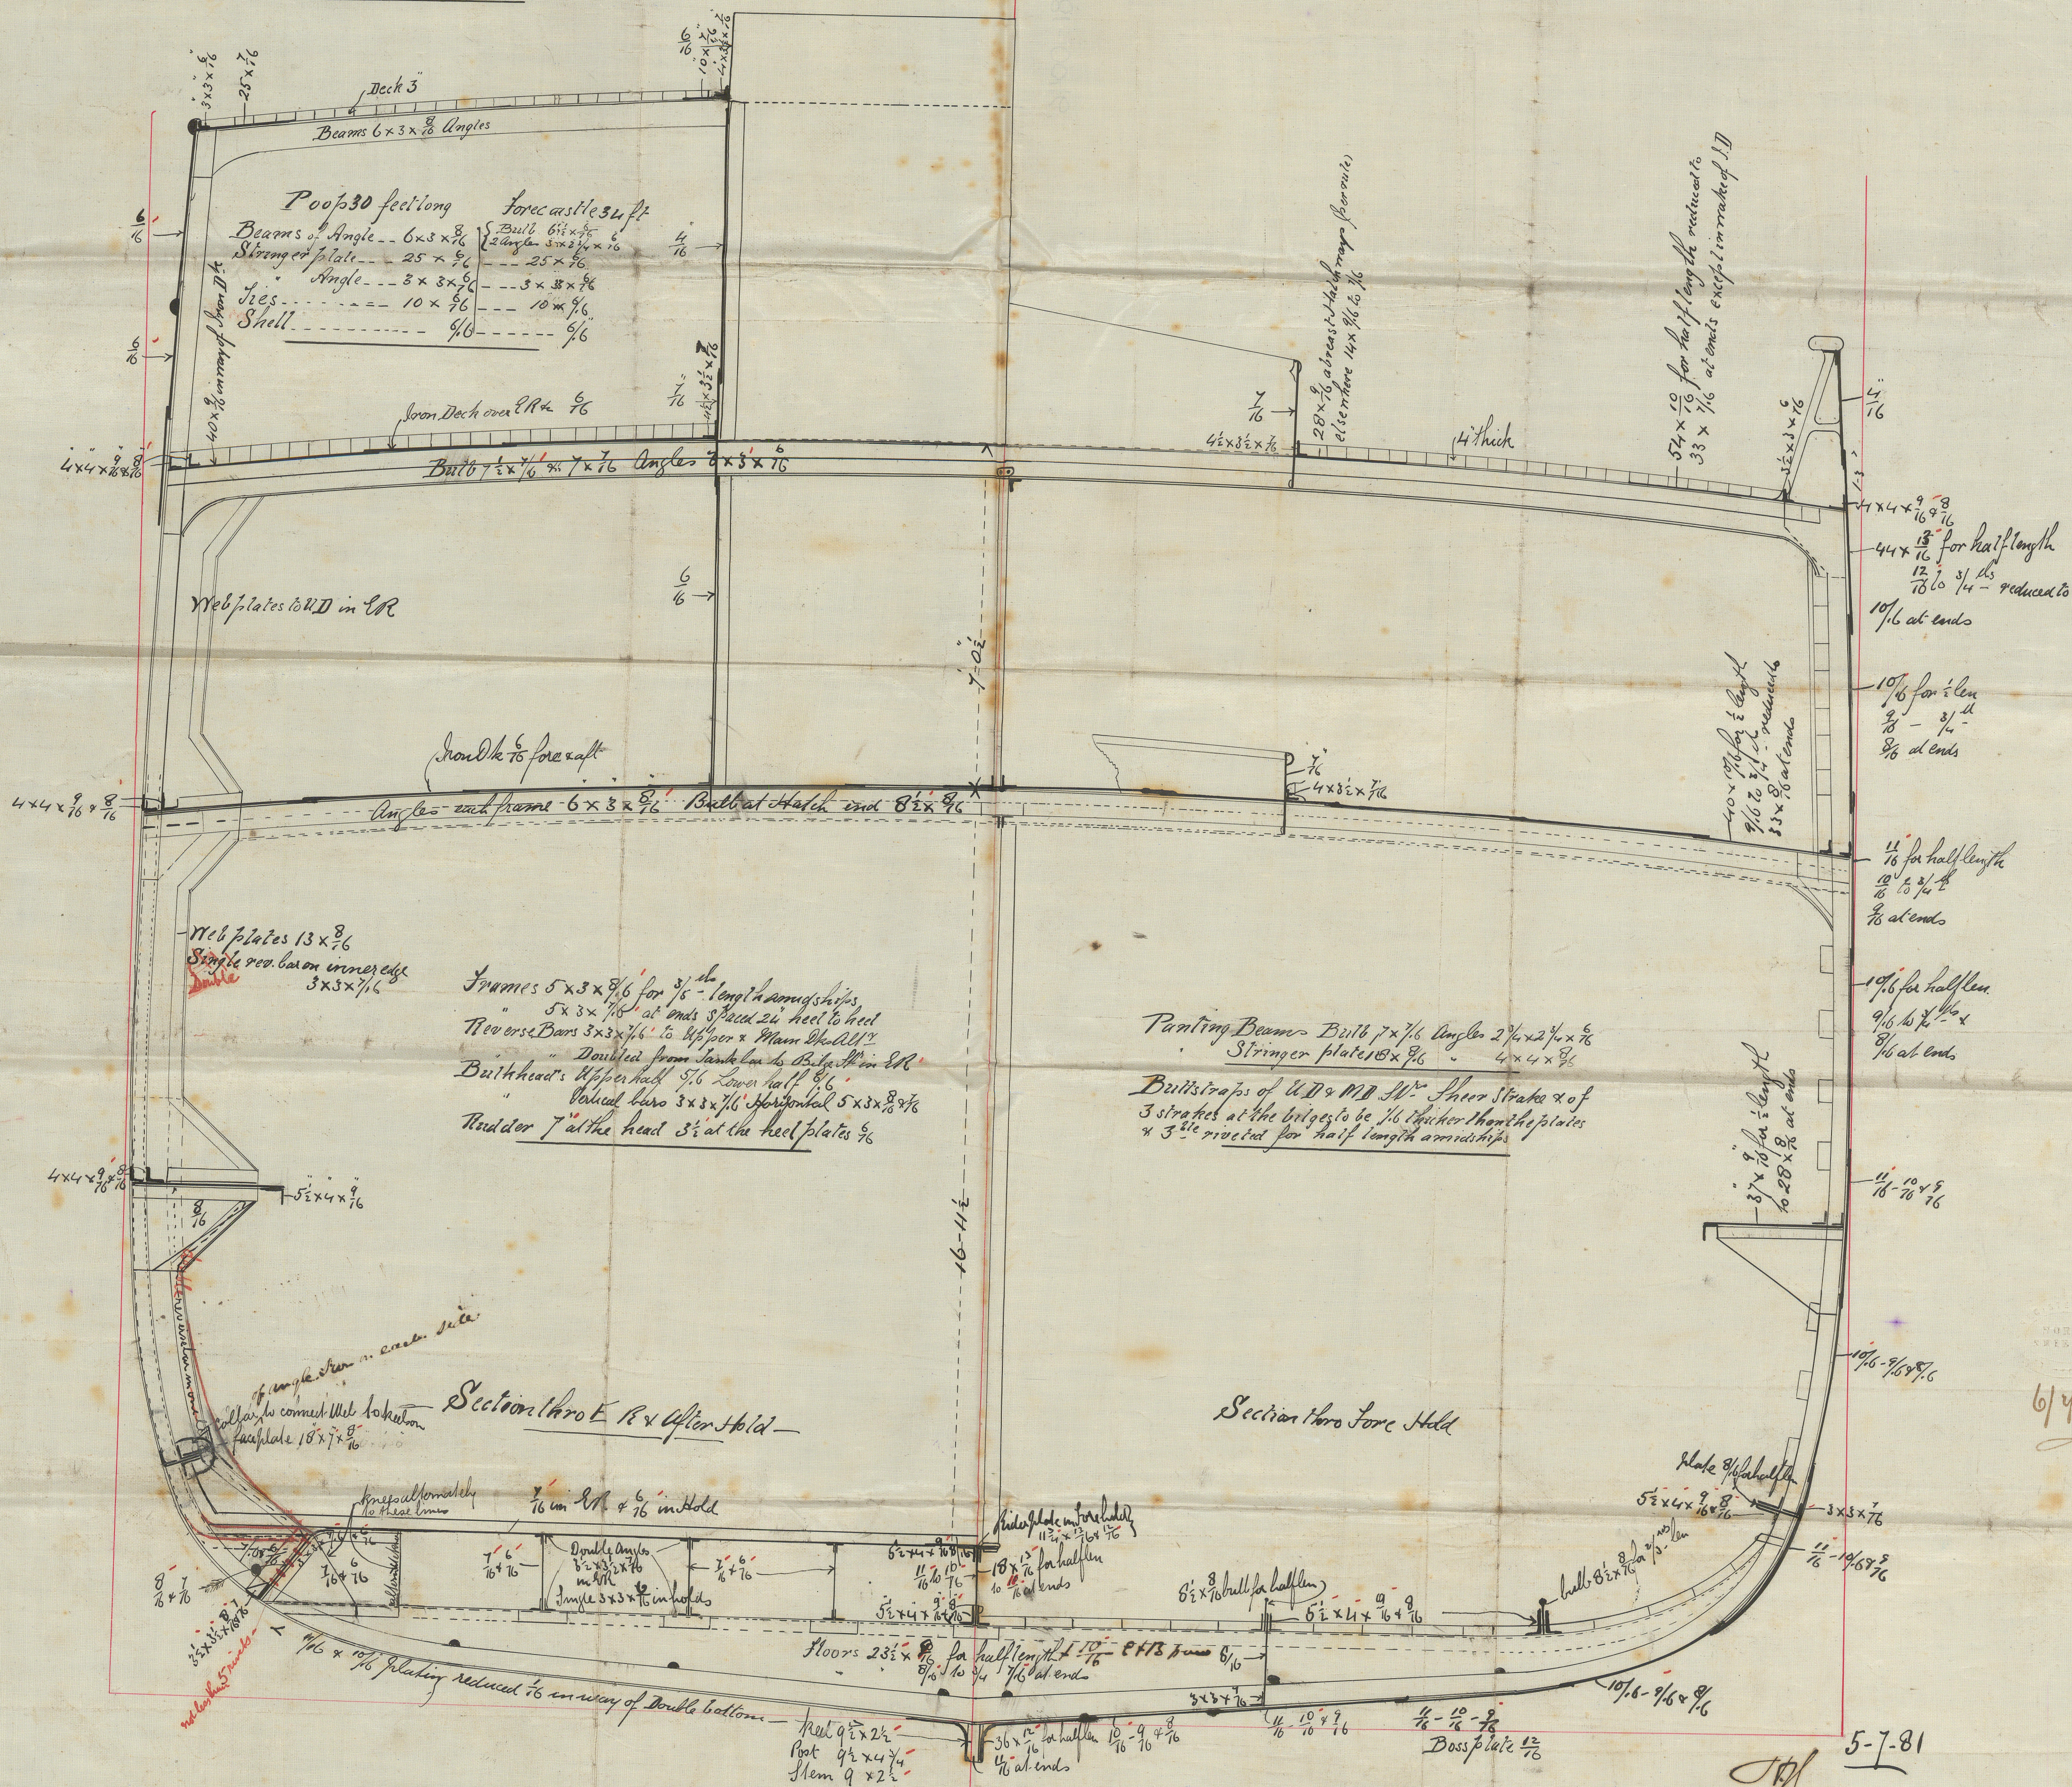

6/4/81

5-7-8

J. P. M.
7/7/87