


	<u>Buildings</u>	<u>Sluicds</u>	<u>½ Girth</u>	
Length B. Perp. ^s -----	256. 0	254. 7	½ Bdl ^h	33. 28.4 ✓
Breadth Extreme -----	35. 0	34. 9½	Depth	17. 39.5 ✓
Depth Moulded -----	19. 3	19. 10		19. 8.40 ✓
W ^{ts} for Frames -----		70. 5		40. 51.9 ✓
" " Plating -----		14. 958 ✓		
" " Equipment -----		19. 754 ✓		
Depths in Length to Main Deck 12. 91 ✓				
Breadths in Length -----		7. 31 ✓		

MIDSHIP SECTION

S. S. N° 68

SCALE $\frac{1}{2}$ INCH TO ONE FOOT.

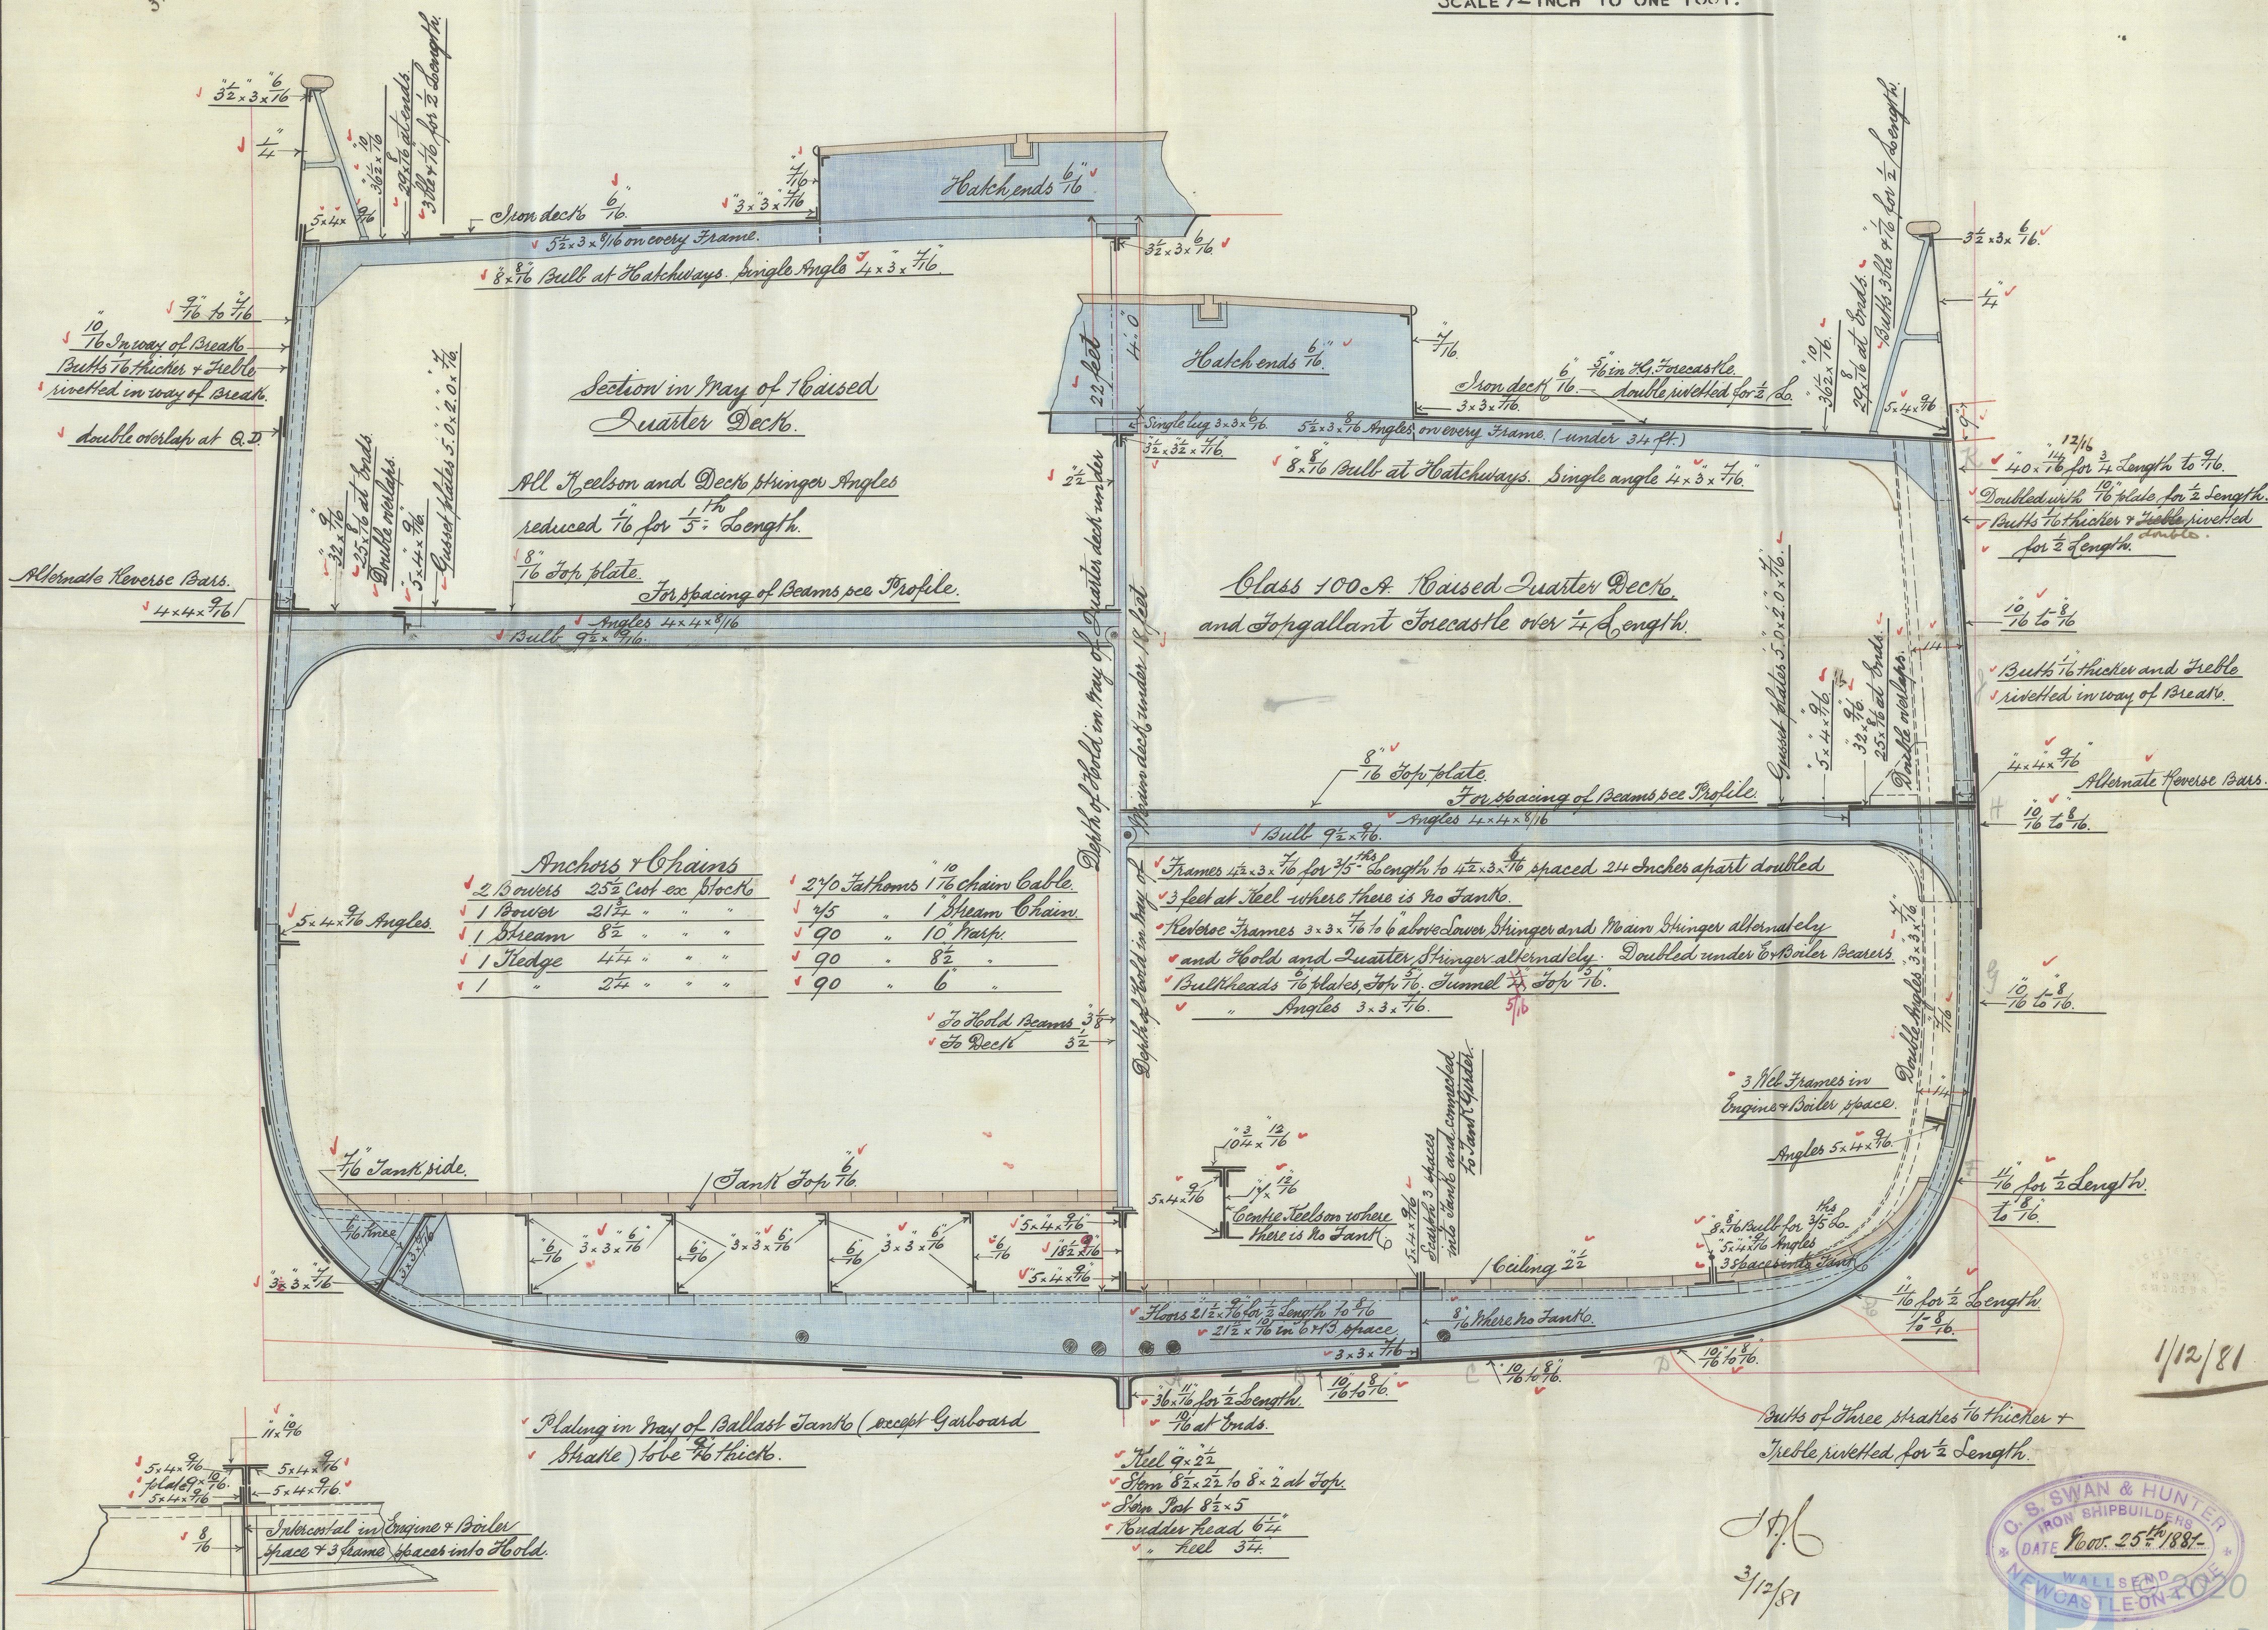

1/12/81

C. S. SWAN & HUNTER
IRON SHIPBUILDERS
DATE Nov. 25th 1881
WALLSEND
NEWCASTLE-ON-TYNE

2010-782-0102