

RECEIVED 21 JUNE 82
DELIVERED 29th JULY, 82.



S.S. "Malek" Uwe. Report No. 16428

S.P. No. 148
Scale of 1/8 inch = 1 foot

7



24/10/82
28/1/82

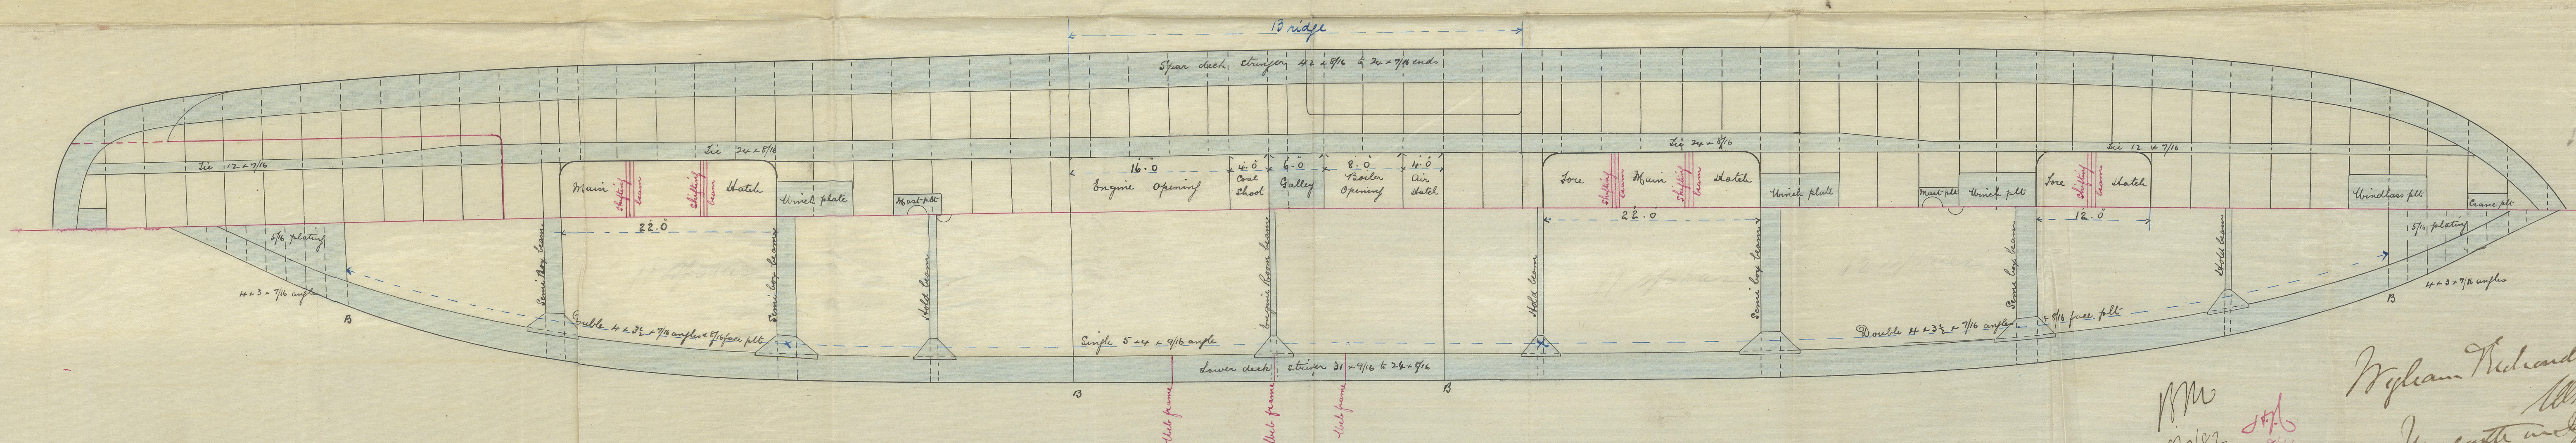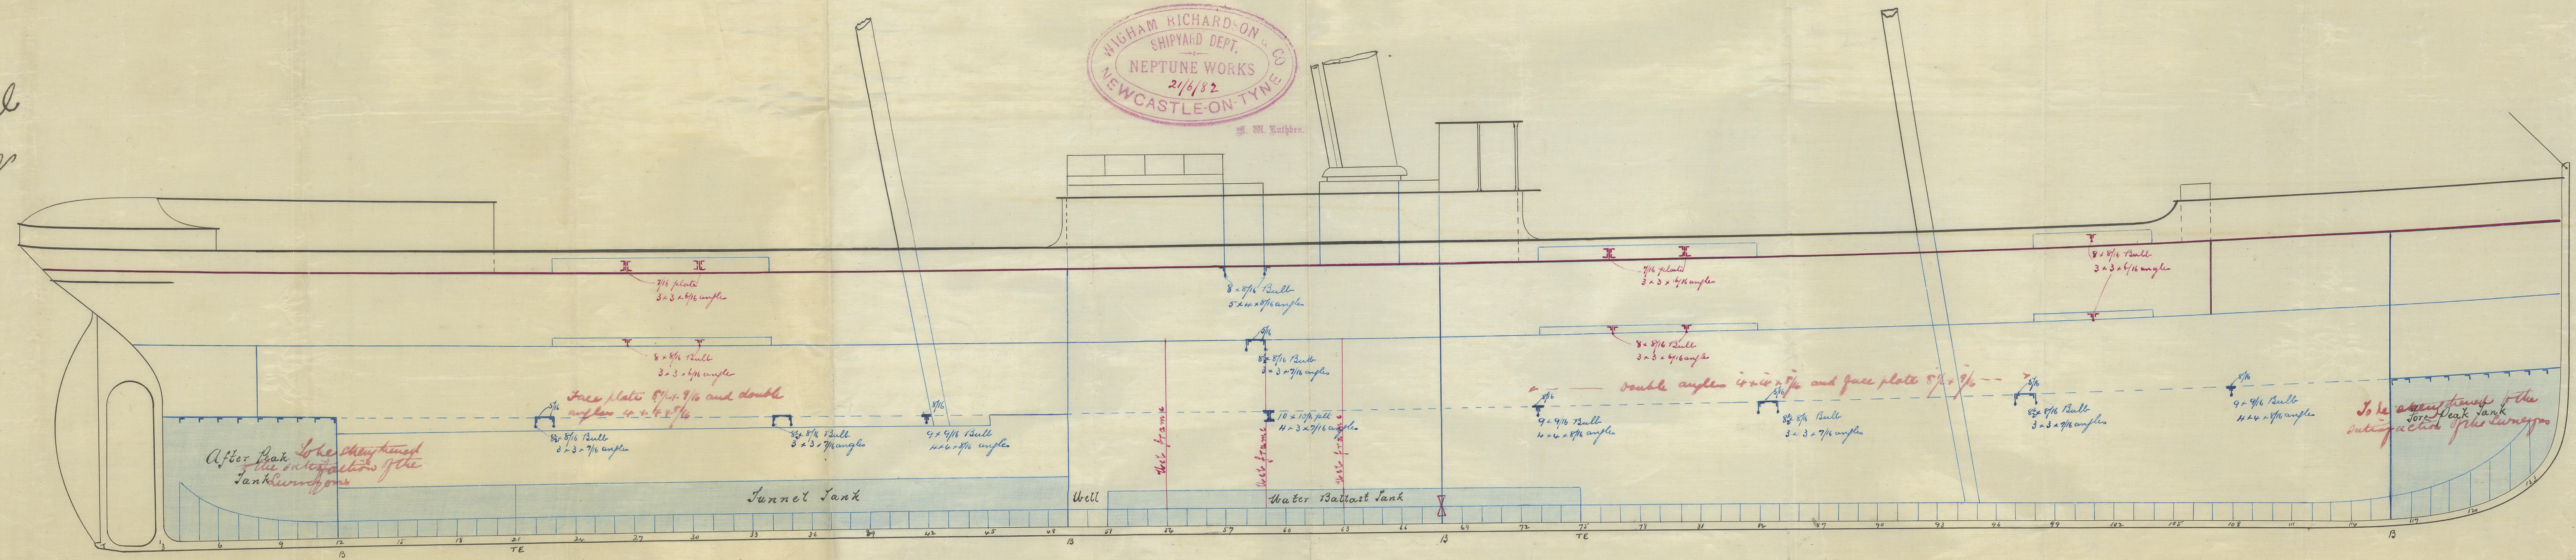

26/6/82

Wm
28/7/82
28/6/82

Wigham Richardson
