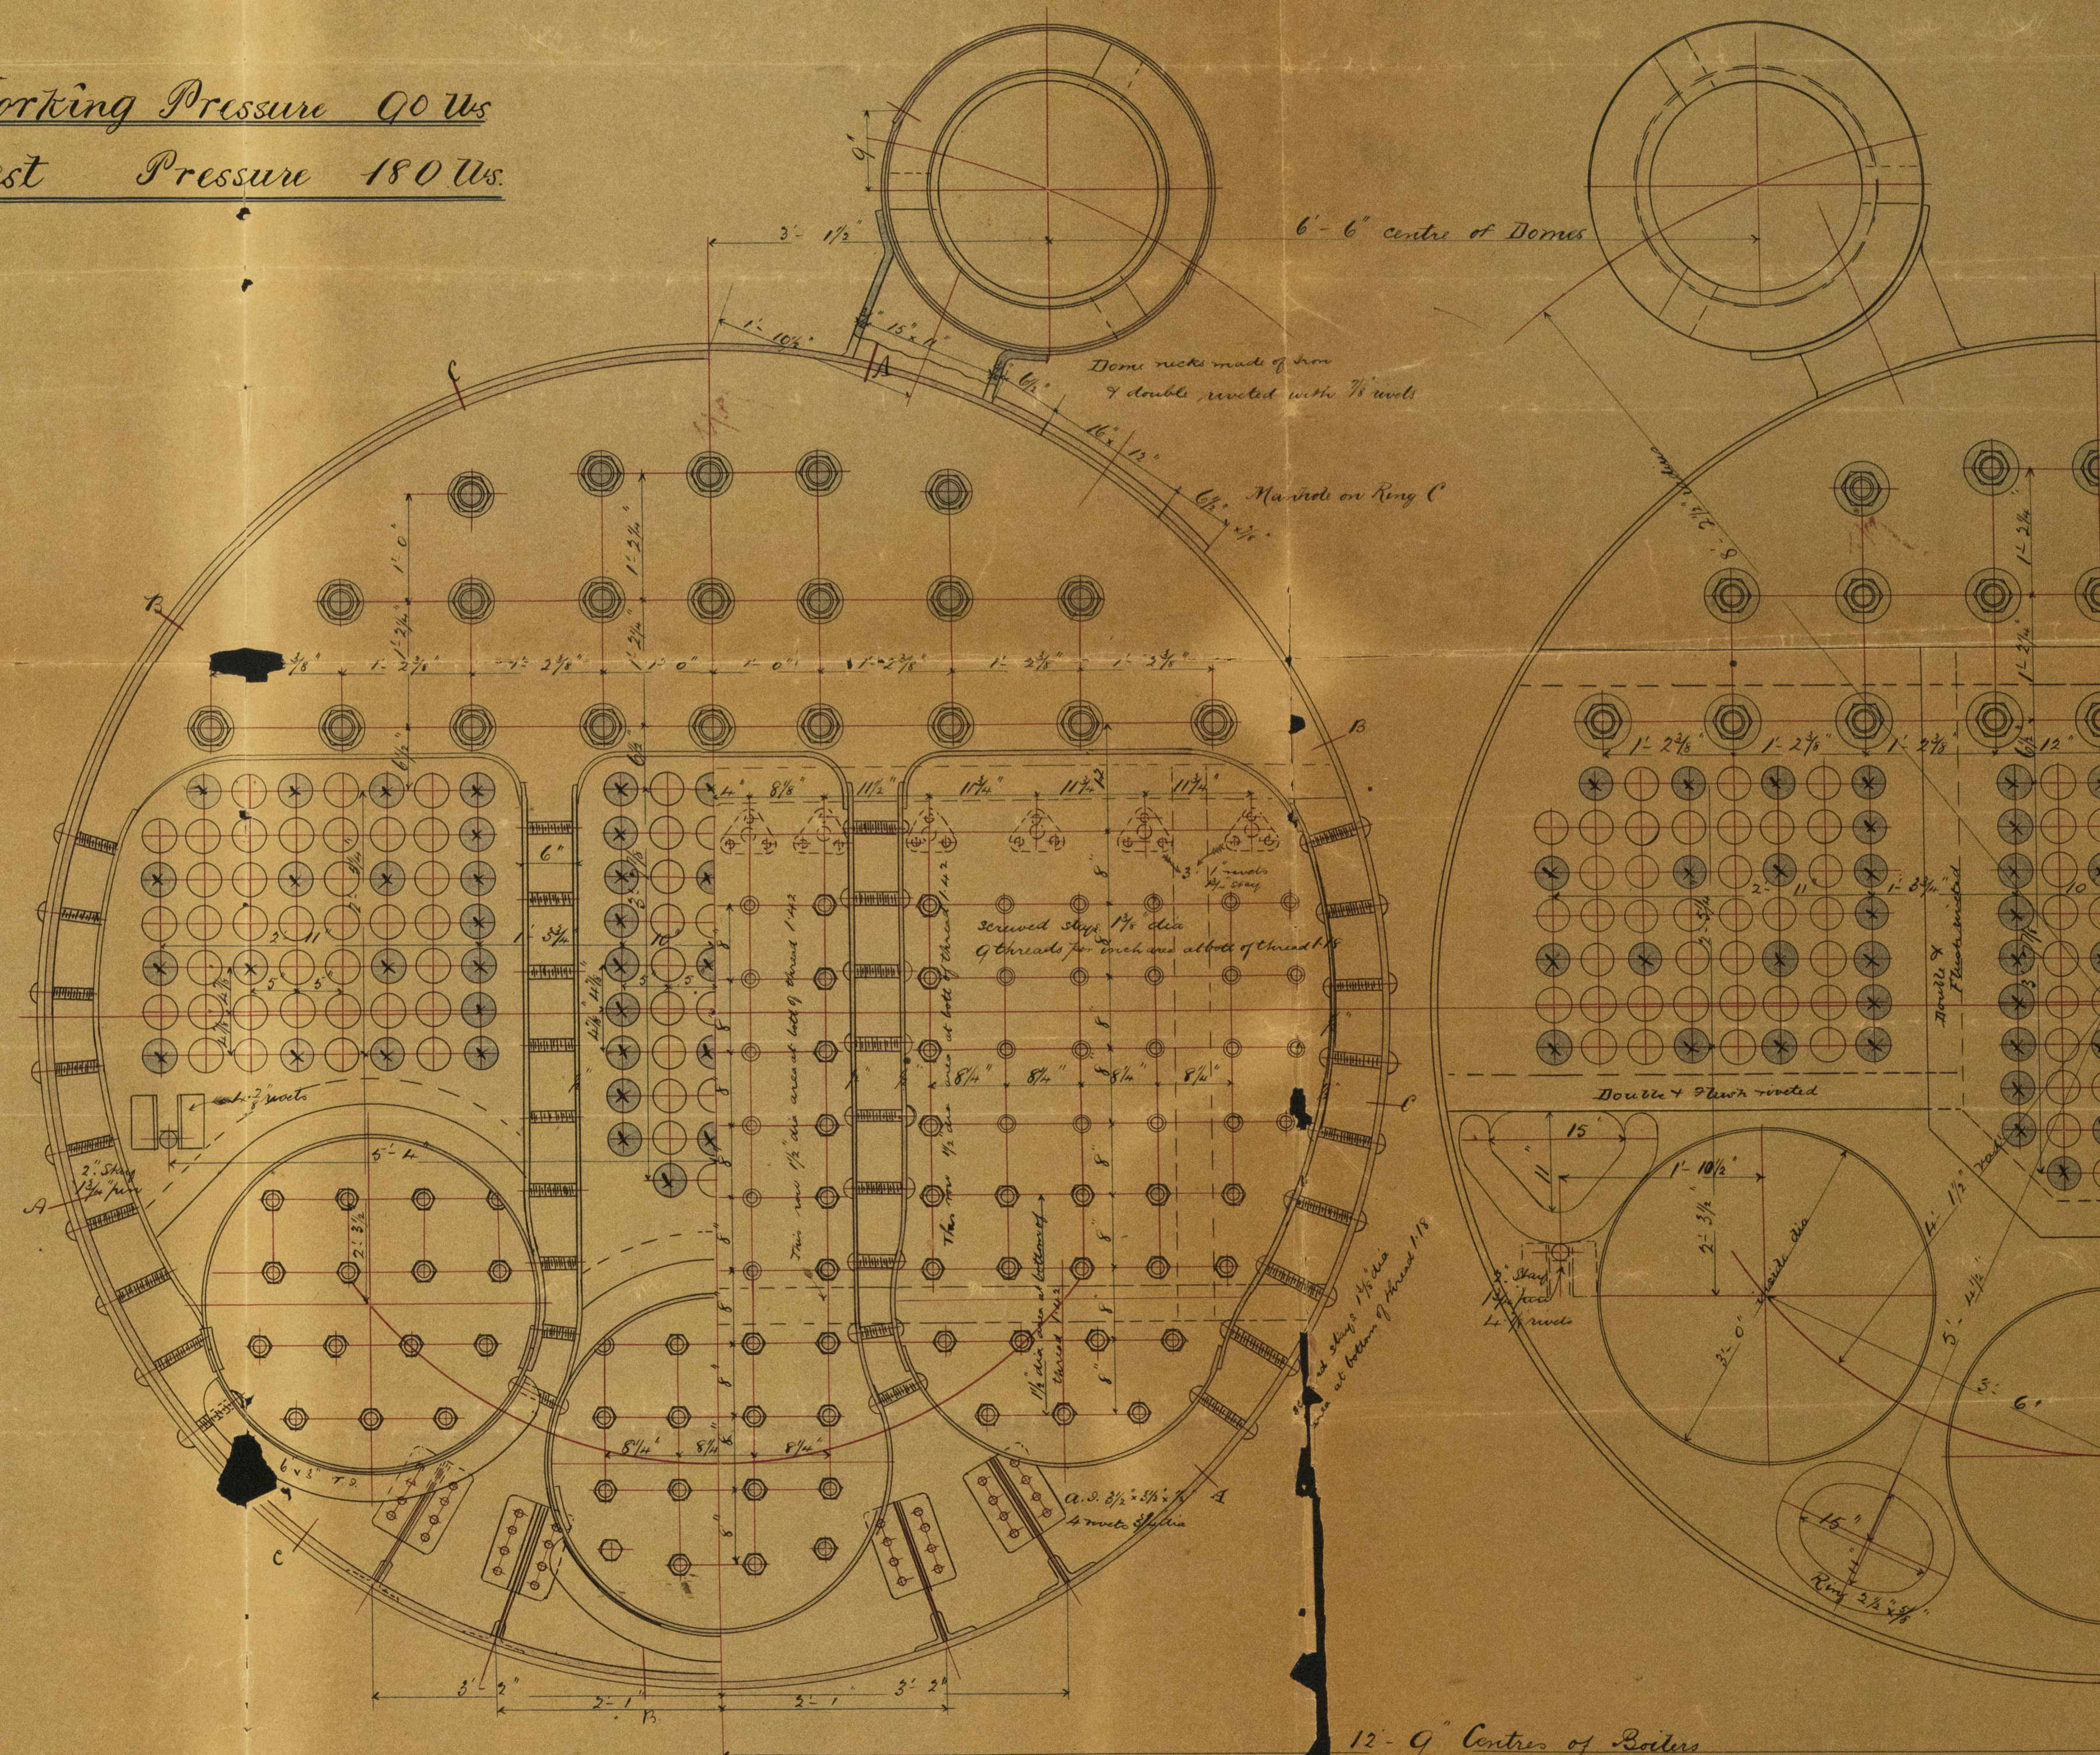
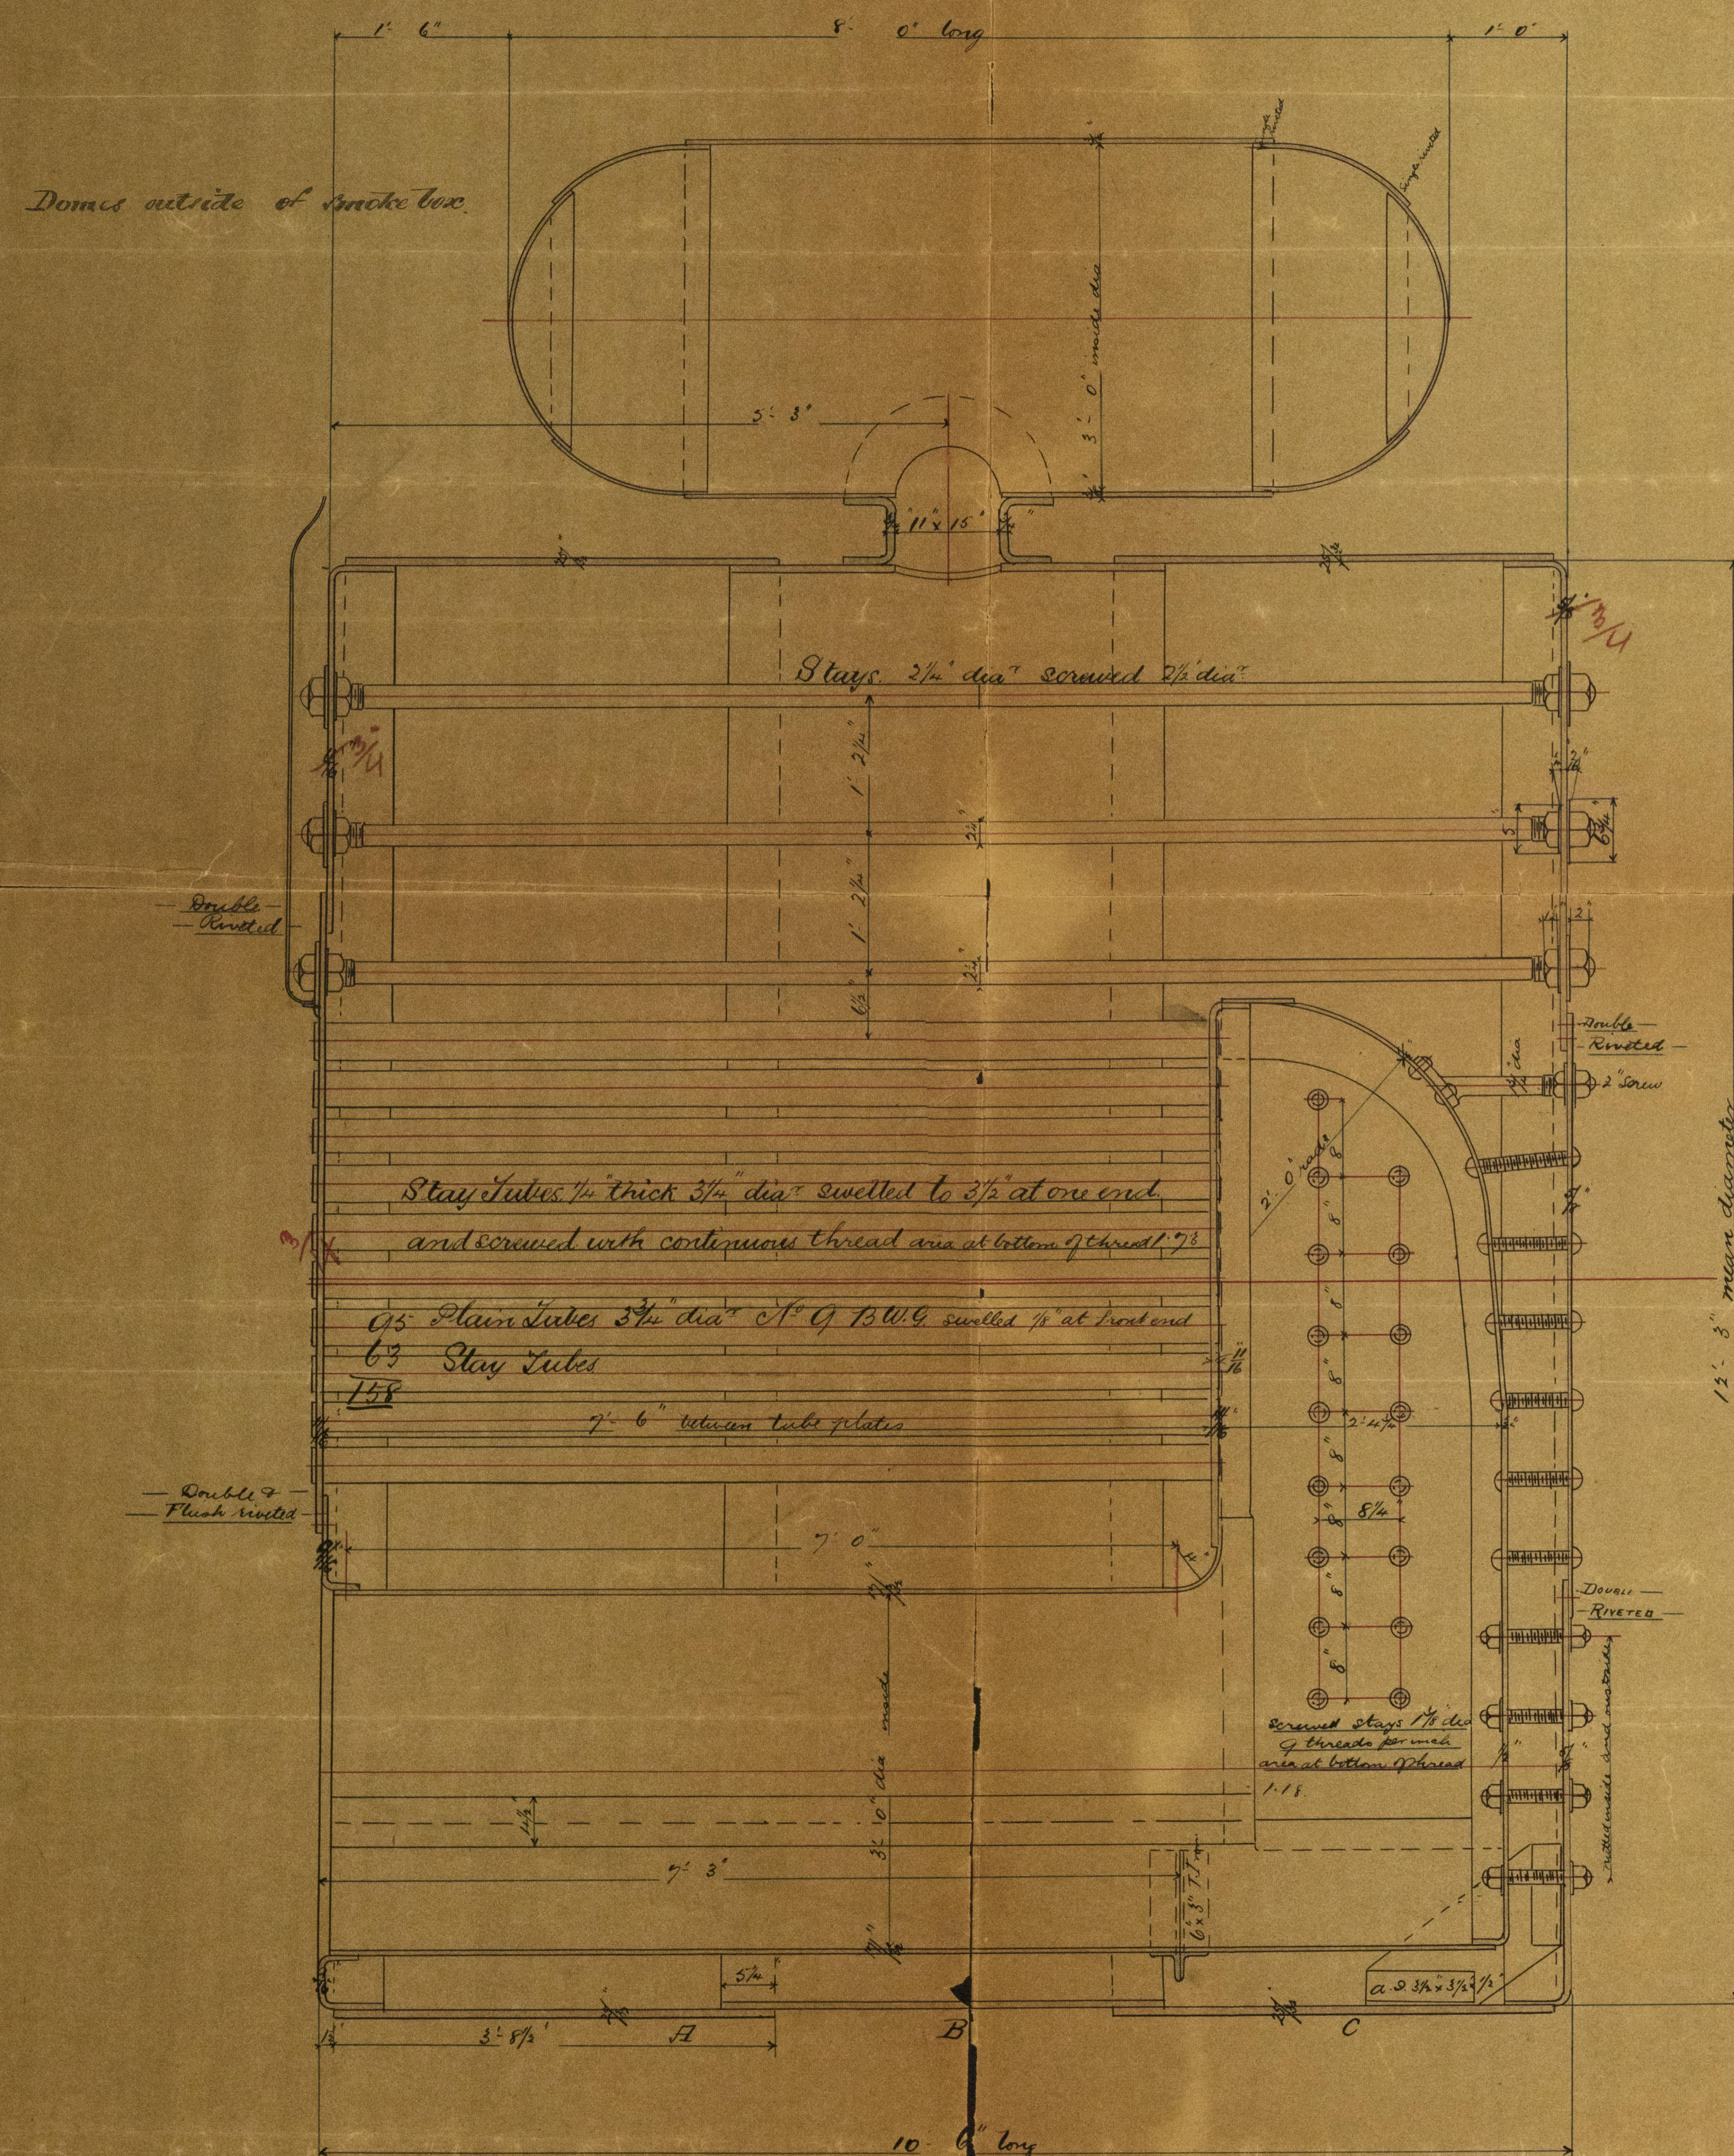


Actual % $\left\{ \begin{array}{l} \text{Dates } 73.1\% \\ \text{Rivets } 91.9\% \text{ reduced} \end{array} \right\} \begin{array}{l} \times \frac{8}{9} = 81.9\% \text{ for Lyons} \\ \times \frac{23}{24} = 77.7\% \text{ Bond of Dredge} \end{array}$

Factor of safety 5.2

Working Pressure 90 lbs
Test Pressure 180 lbs.

BOILERS IN^o 148

SCALE 1 INCH = 1 FOOT

S.S. "Malek"
Nwe. Report No. 16728

This image shows a blank, aged, cream-colored page, likely an endpaper or flyleaf of a book. The paper has a slightly textured appearance with some minor creases and discoloration, characteristic of old paper. The page is set against a dark, possibly black, background.

© 2021
Lloyd's Register
Foundation

Ms. No. 148

Page of 2074

private work