

S. S. "Chollerton" Uwe. Report No. 164140

SCALE $\frac{1}{2} = 1.0$

MIDSHIP SECTION FOR A SPAR DECK STEAMER

- No 239

— PRINCIPAL DIMENSIONS —
LENGTH FOR LLOYDS 314.6
BEAM 36.9
DEPTH TOP OF KEEL TO UNDERSIDE
OF SPAR DECK 29.6
" TO UNDERSIDE OF MAIN DECK 22.0
DEPTH MOULDED 28.6


100 A1

243

244

2. 10. 82

27/2/83.

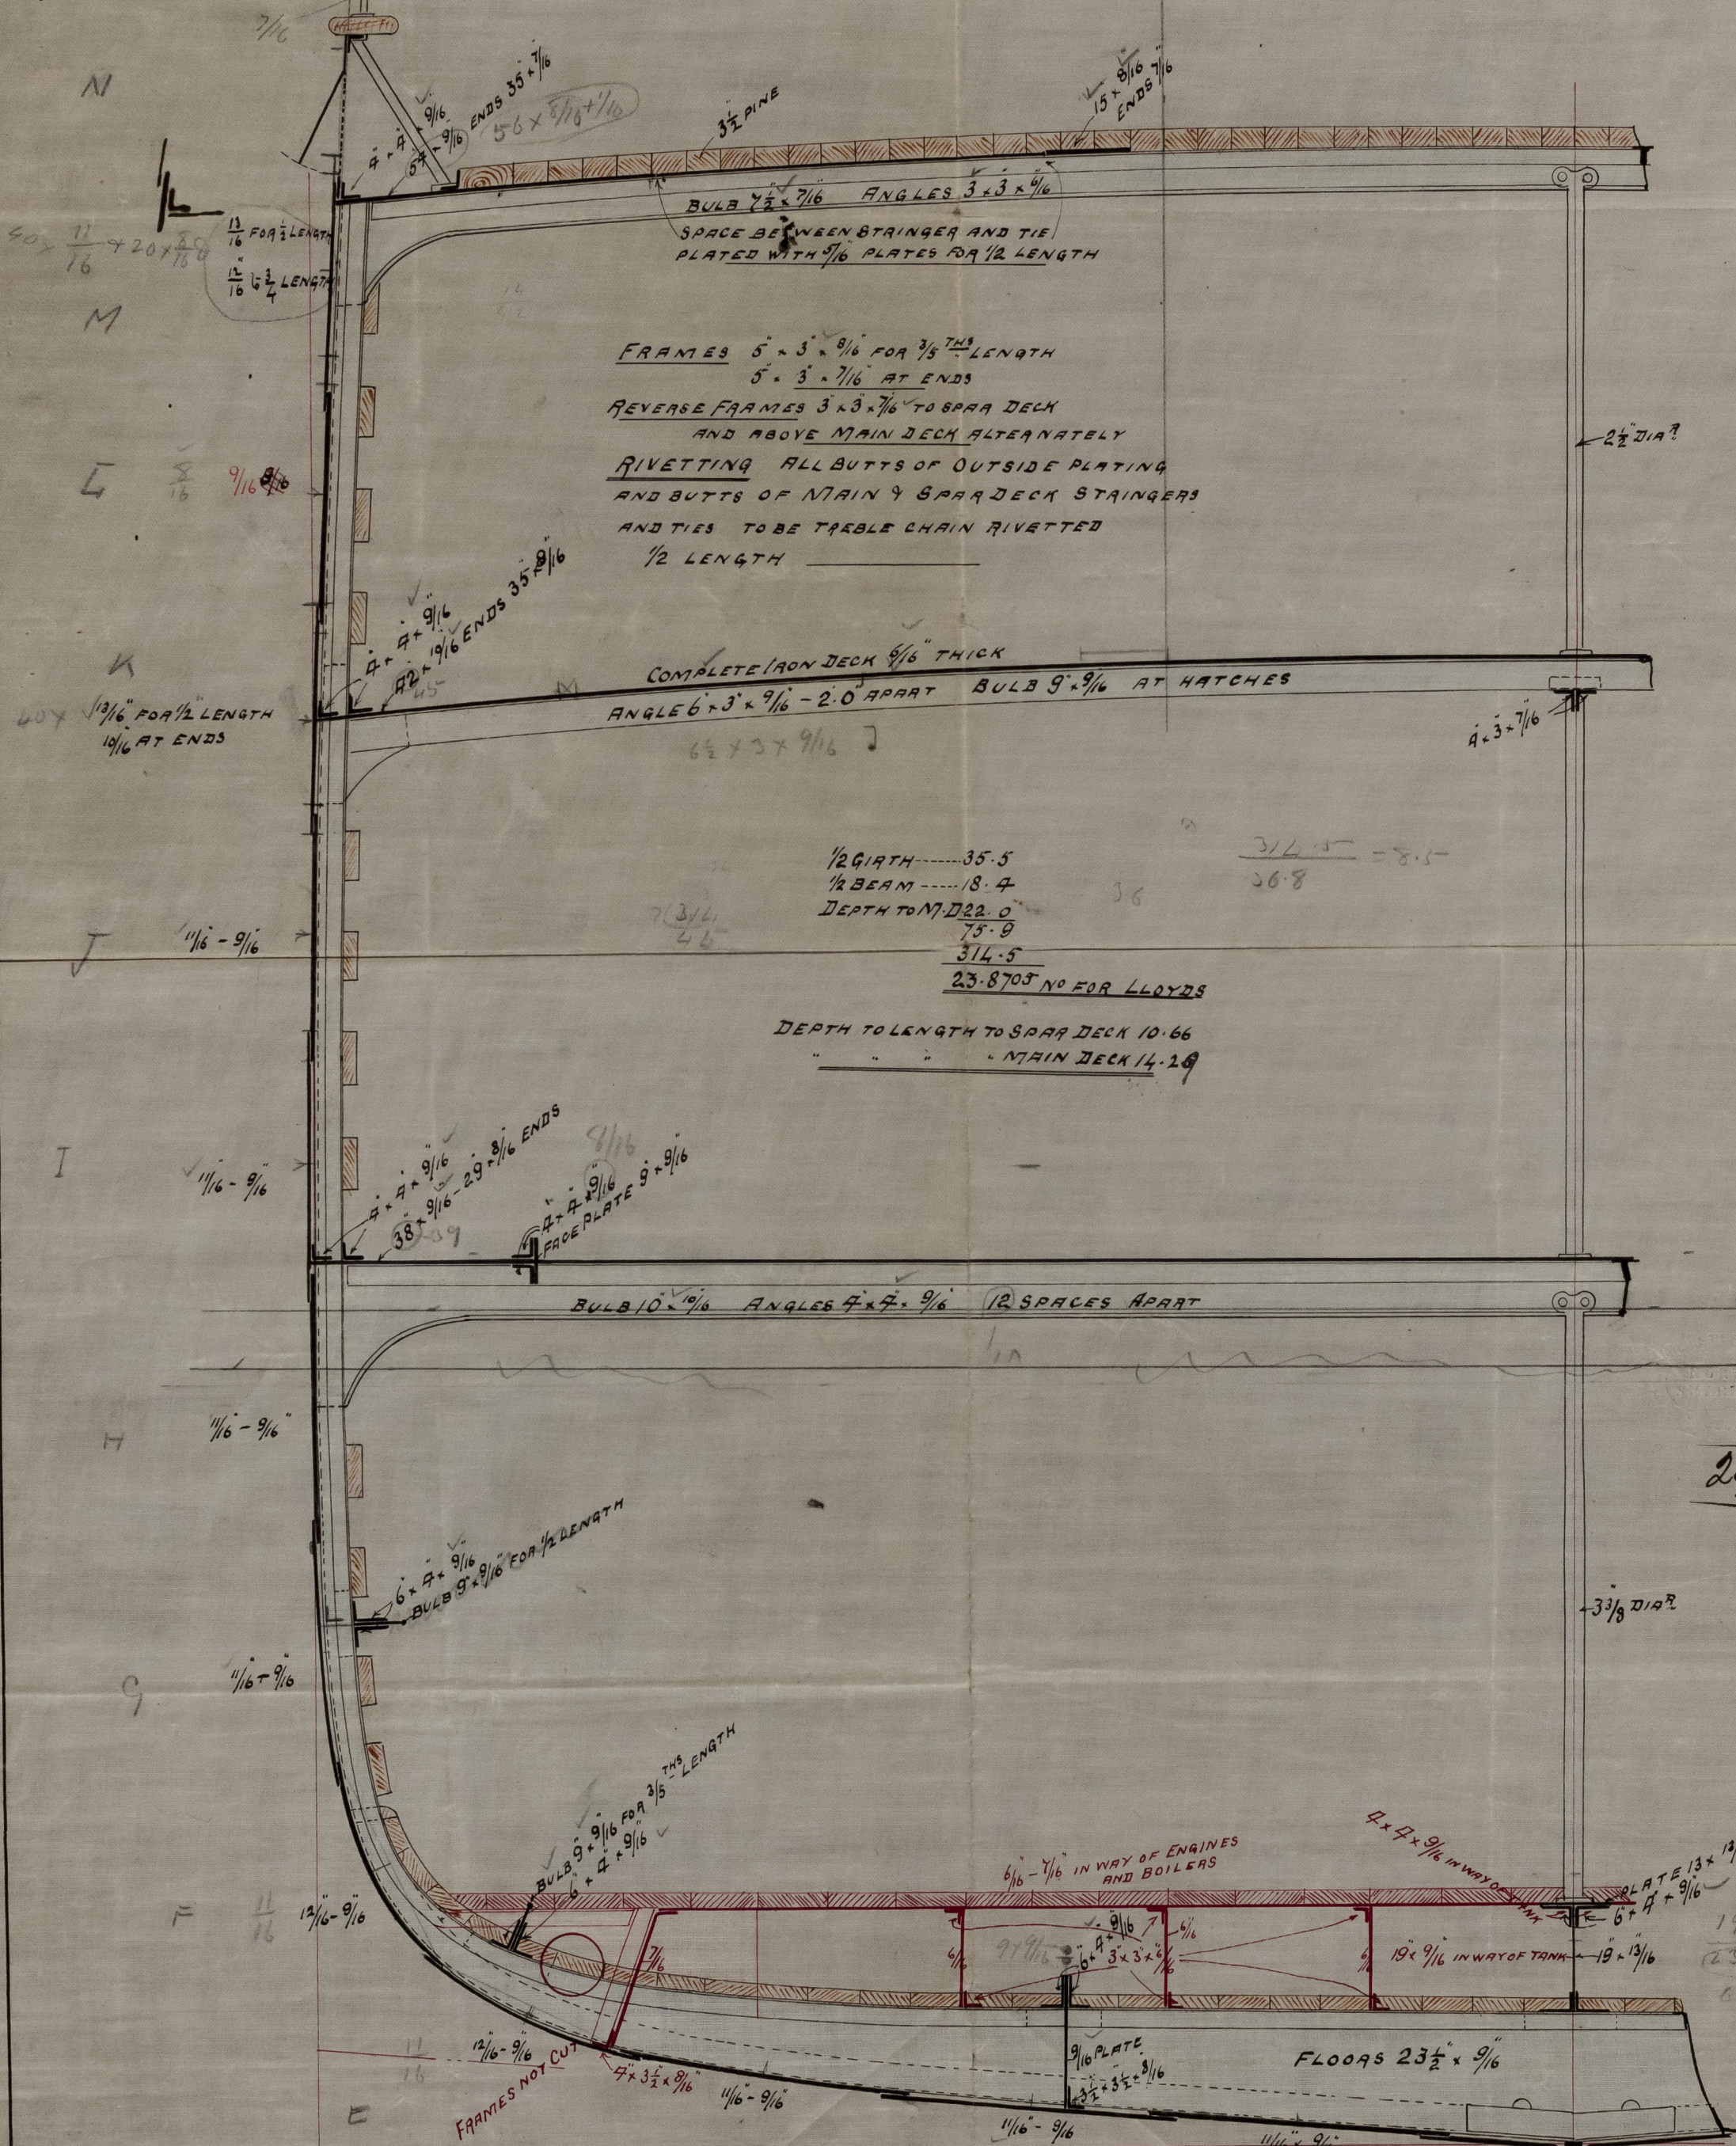

1/2 GIRTH 35.5
1/2 BEAM 18.4
DEPTH TO N. D. 22.0
75.9
314.5
23.8705 NO FOR LLOYDS
DEPTH TO LENGTH TO SPAR DECK 10.66
" " " MAIN DECK 14.29

29/9/82.

30/9/82

RECEIVED FEB 28 1885

DATE 1885 = 10

5.10.85





© 2021

Lloyd's Register
Foundation