


RECEIVED 21st FEB. 83.



S.S. 712 153 S.S. "Beta" Inv. Report No. 16748

Pumping Arrangement.

Scale of 1/8 inch = 1 foot.

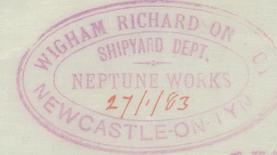

*M. to shell
6/2/83*

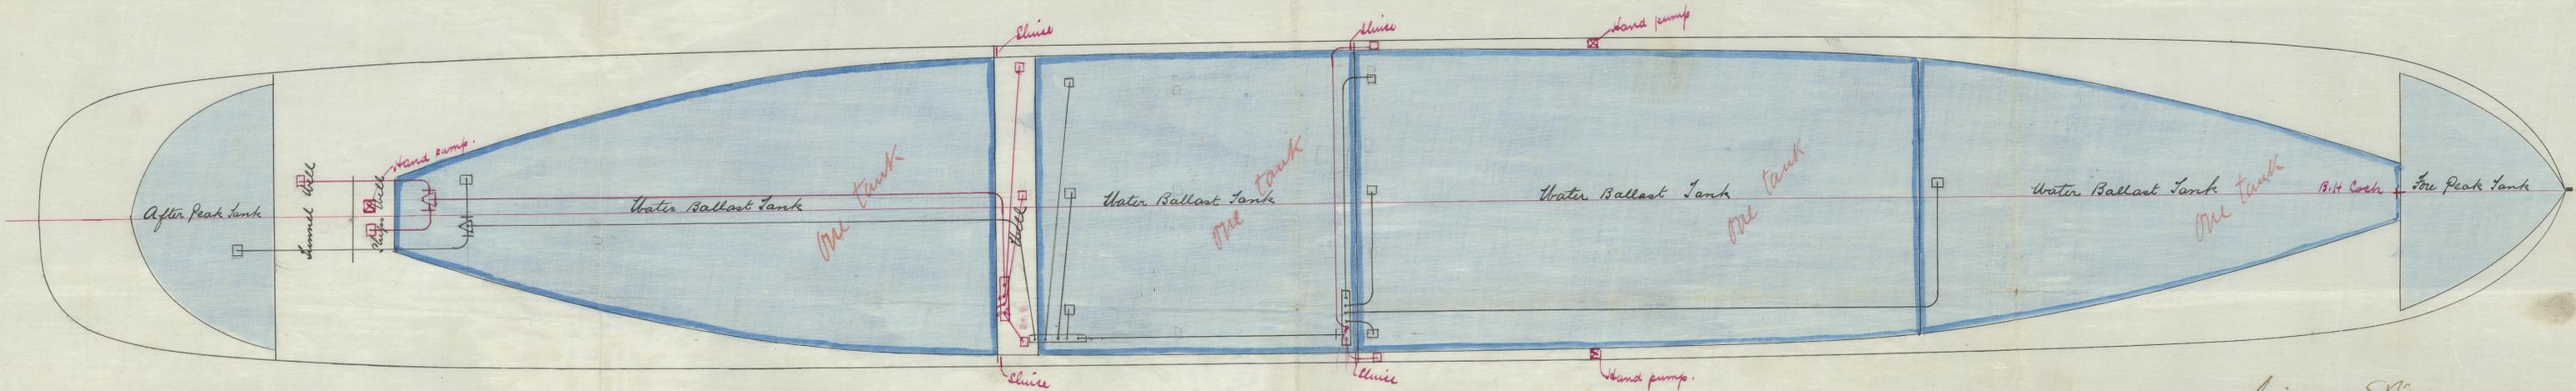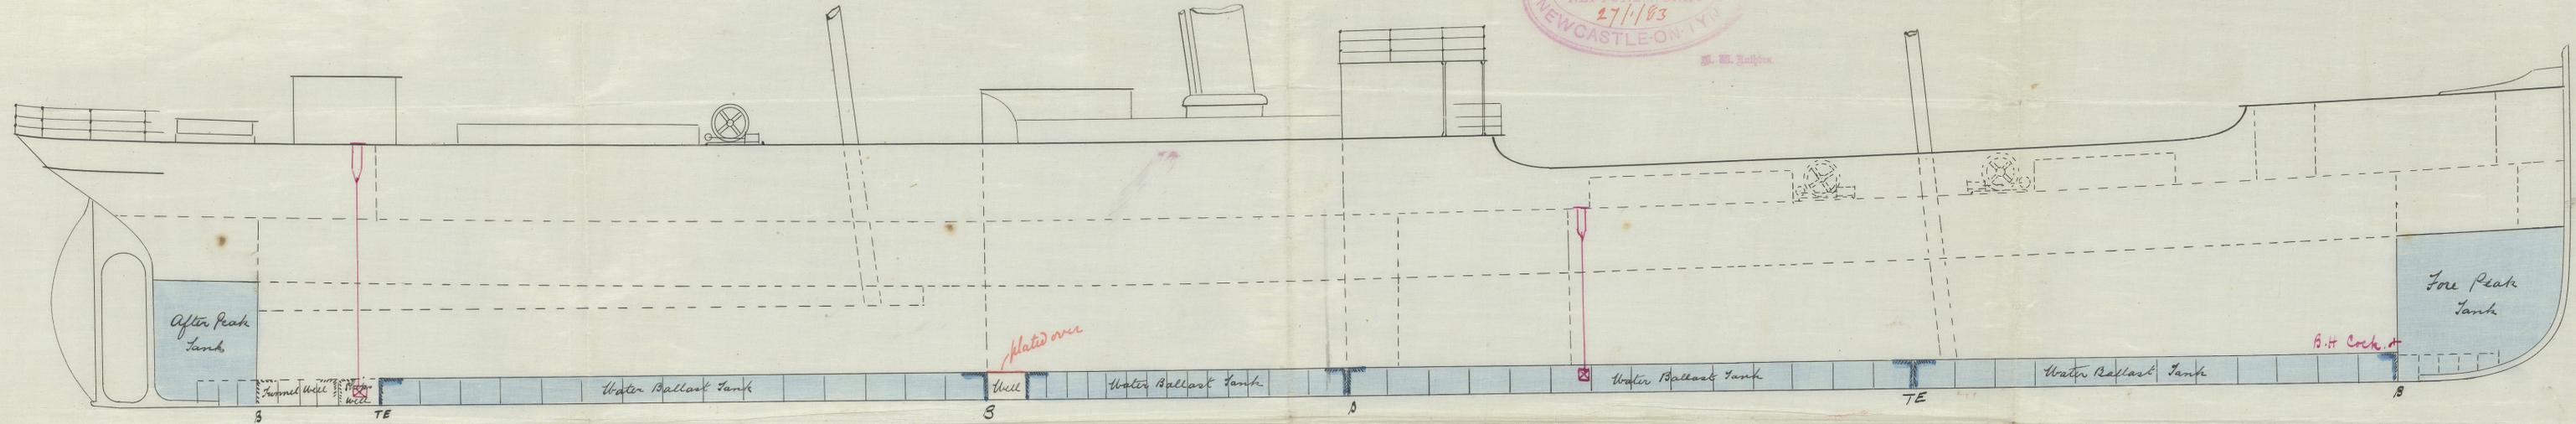

*D.S.
5/2/83*

*Wigham Richardson & Co
Newcastle a Lyne
12th July 1883*

3/2/83