




RECEIVED 11th JULY 1882

Lt. W. Shields
14/7/82

S. S. N^o 153 S.S. "Goeta" Tonnage Report No. 16778

ELEVATION & DECK PLAN

SCALE 1/8 IN = 1 FT.

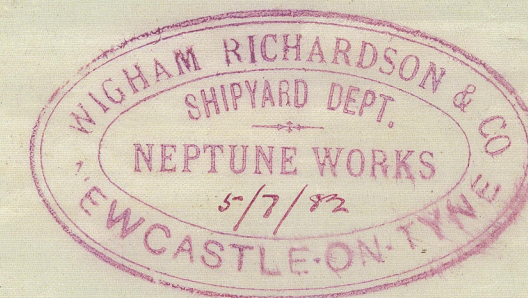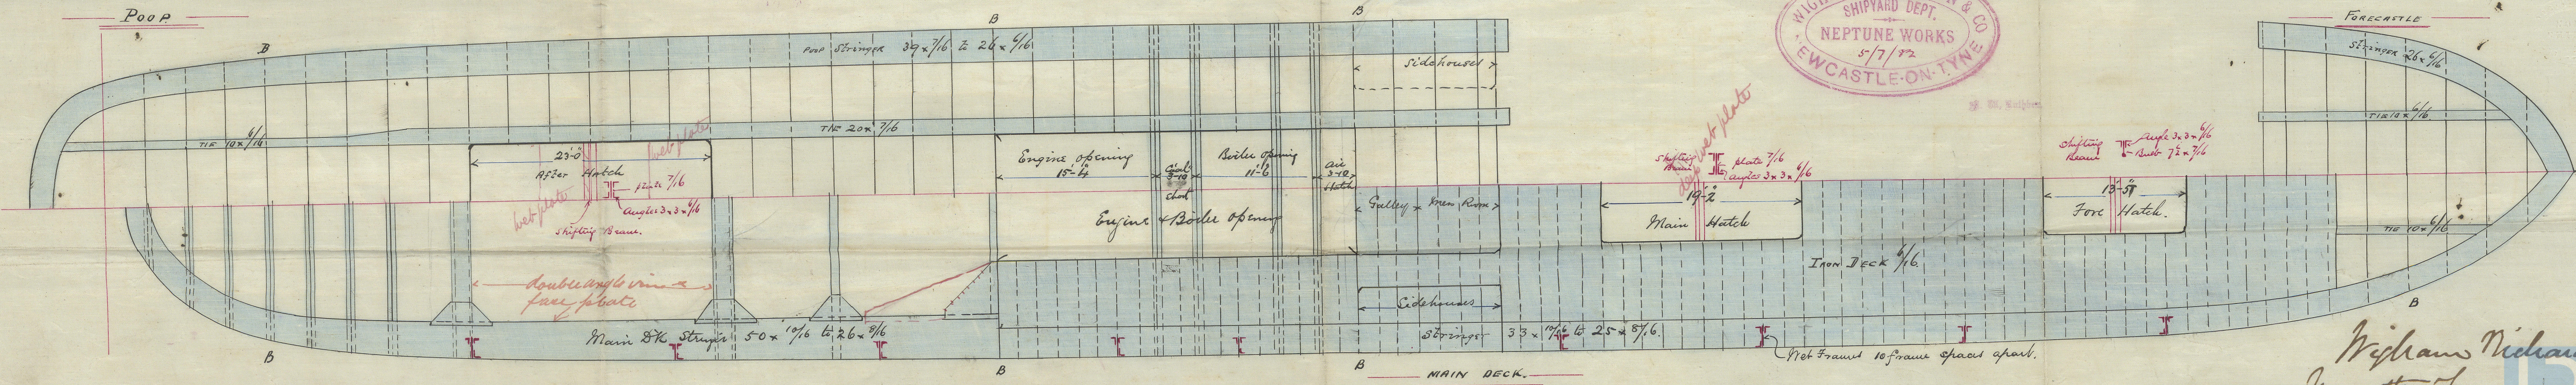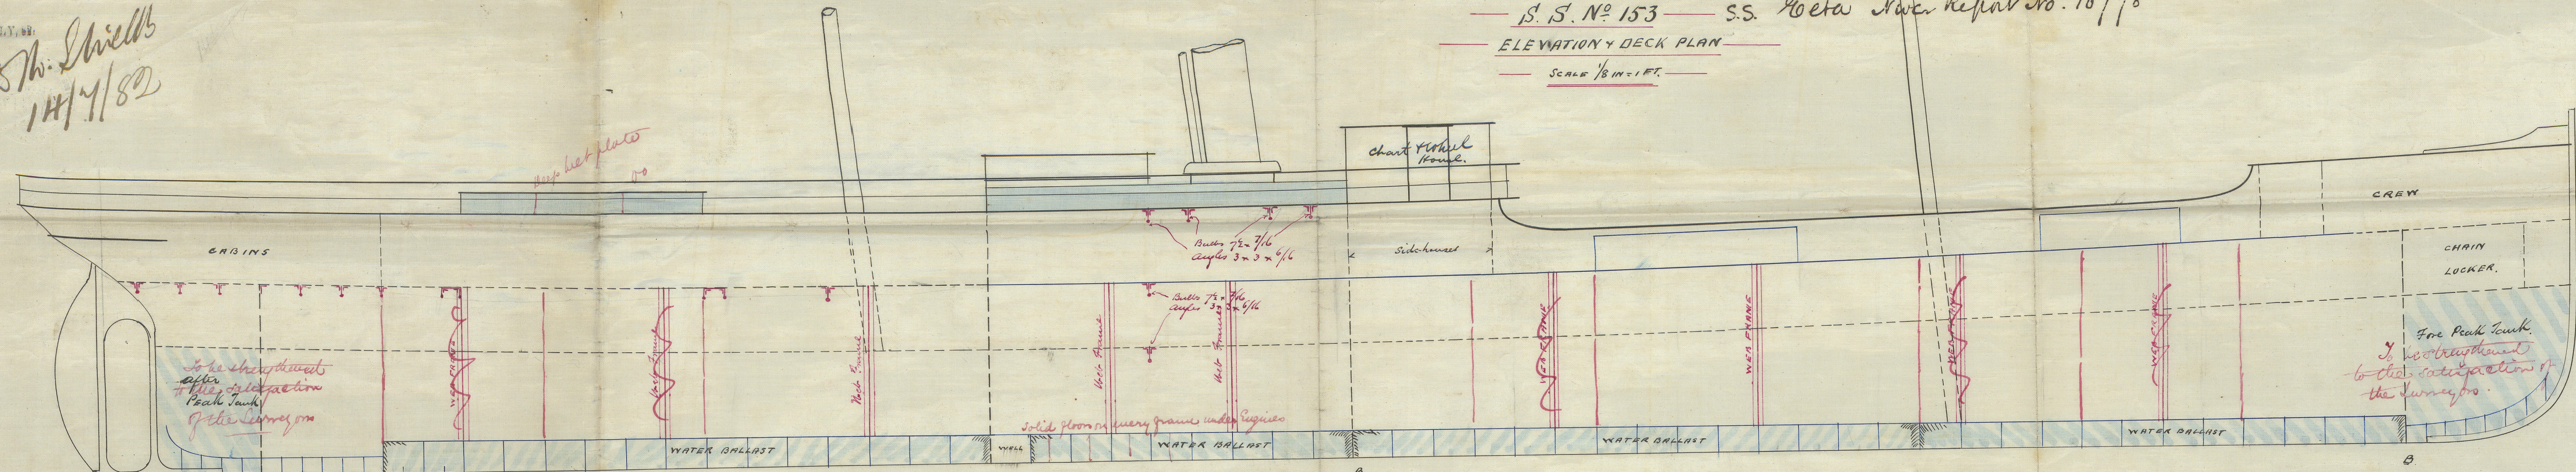

10/7/82

Wigham Richardson & Co.
Newcastle-on-Tyne
July 82

NW785-0069

Lloyd's Register
Foundation