


S.S. "Ketchikan" Wac. Report No. 16778

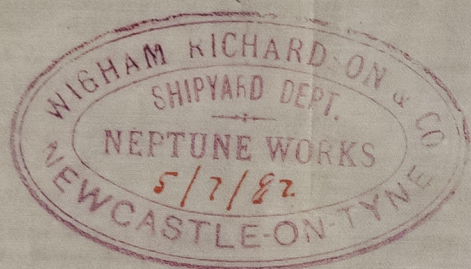


MIDSHIP SECTION.

S. S. № 153.

SCALE $\frac{1}{2}$ INCH = 1. FOOT.

Ltr. to Mr. Lincoln
 14/7/82
 3" x 1/4"

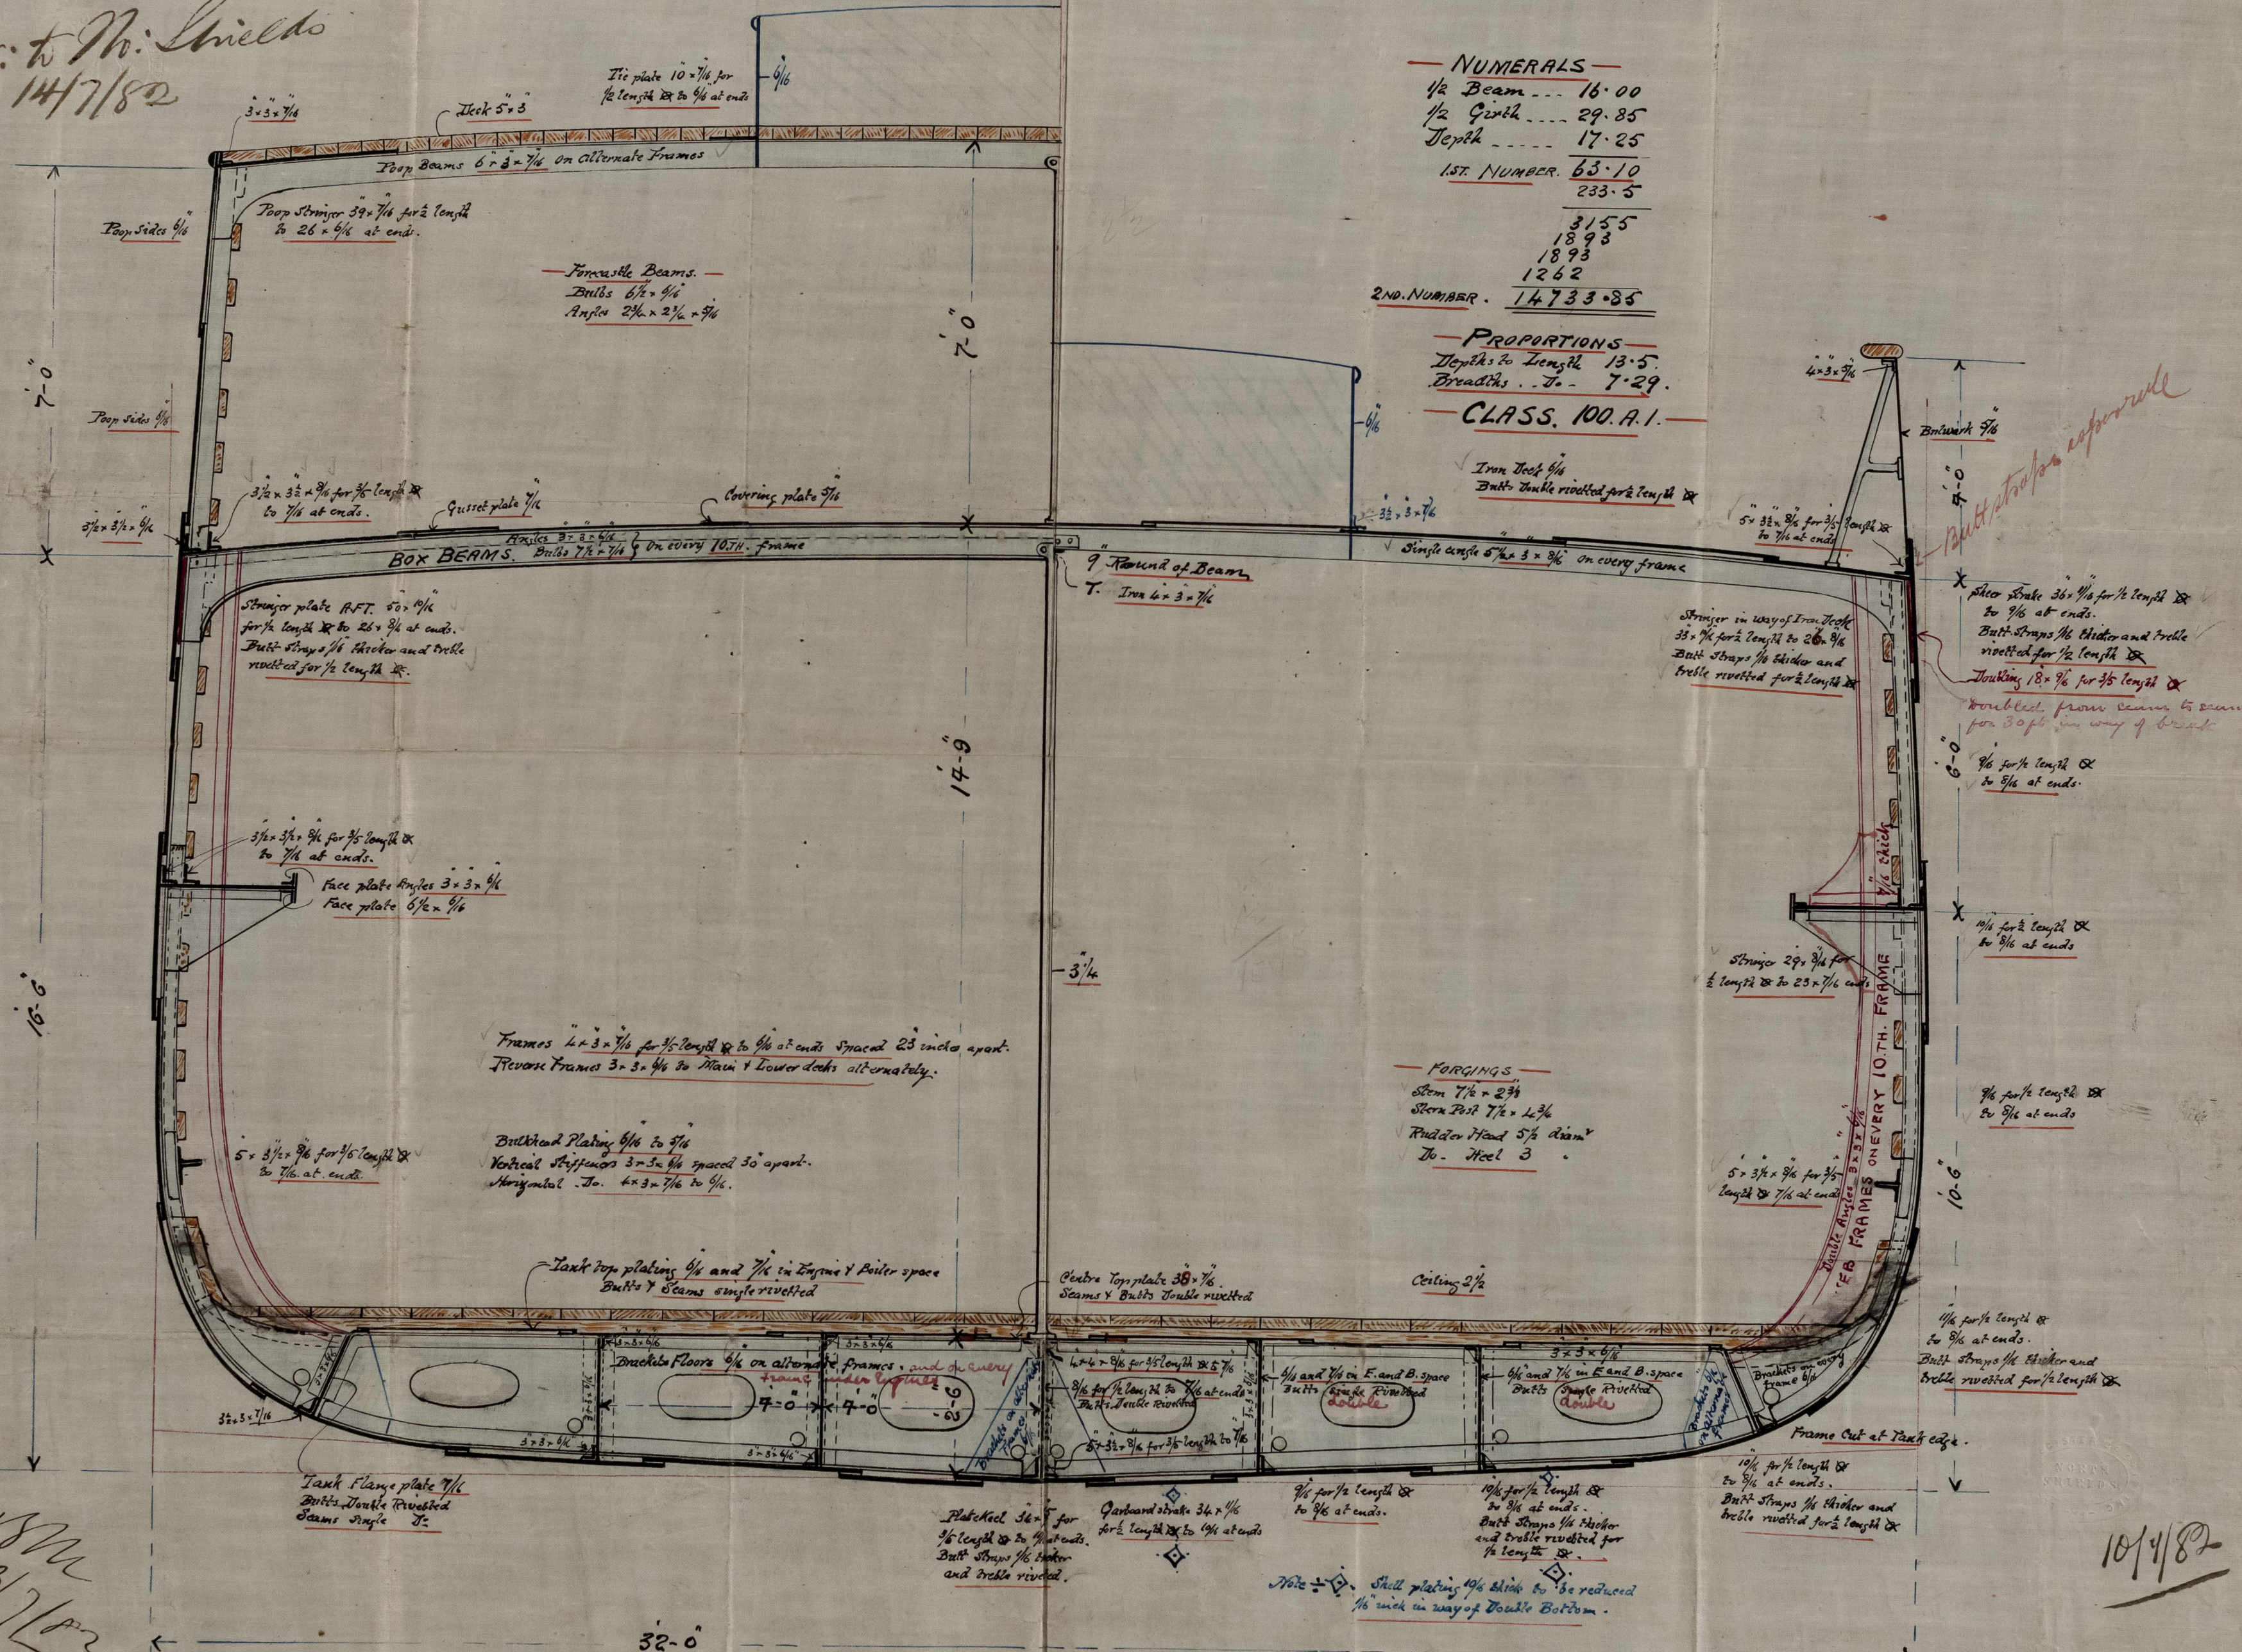

1822
13/7/22

10/4/82