


W. S. S. "Anglo Indian" Ave. Reports 16900
Accommodation Plan.
Scale $\frac{1}{8}$ " = 1 foot

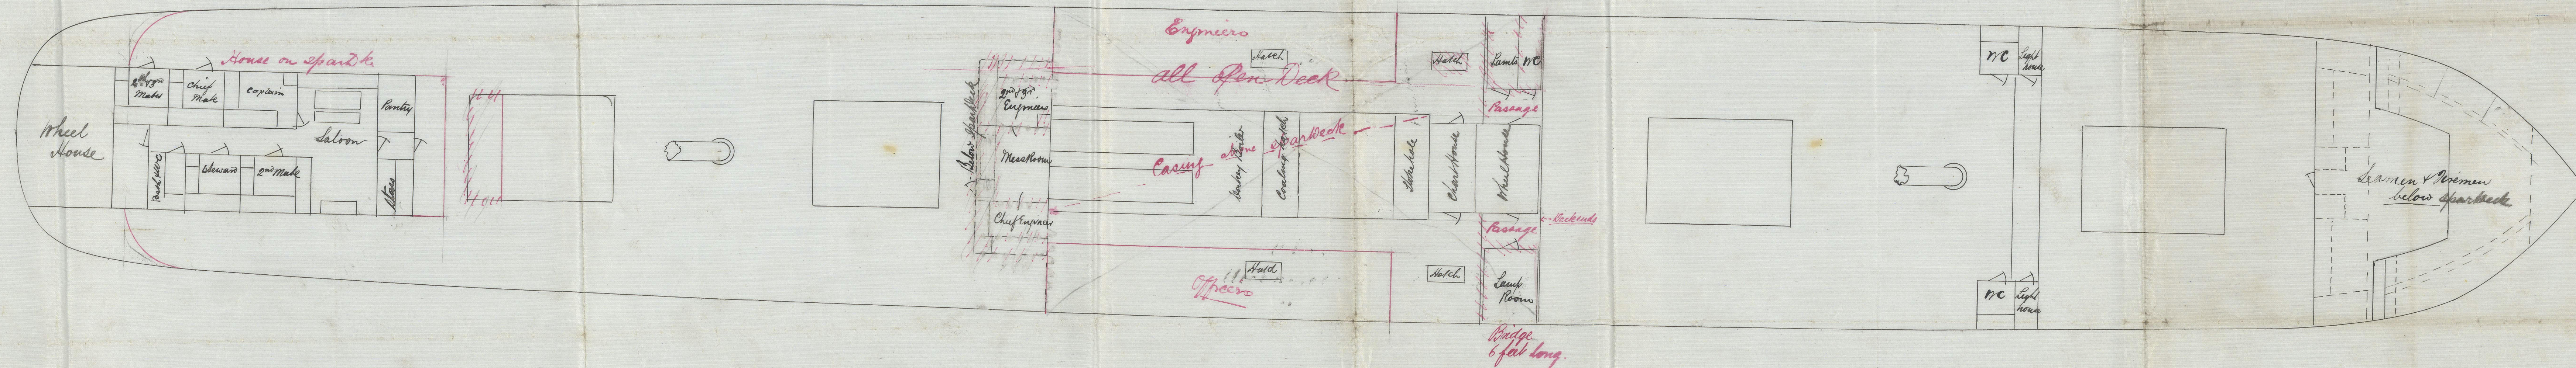

62
30/11/87

9/12/81



© 2021
Lloyd's Register
Foundation