
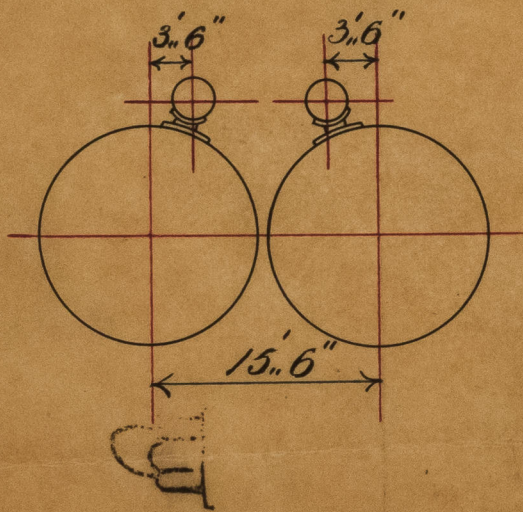


Sketch No 1369
ex to Sh
19/4/83

ext to Sh
1874/83

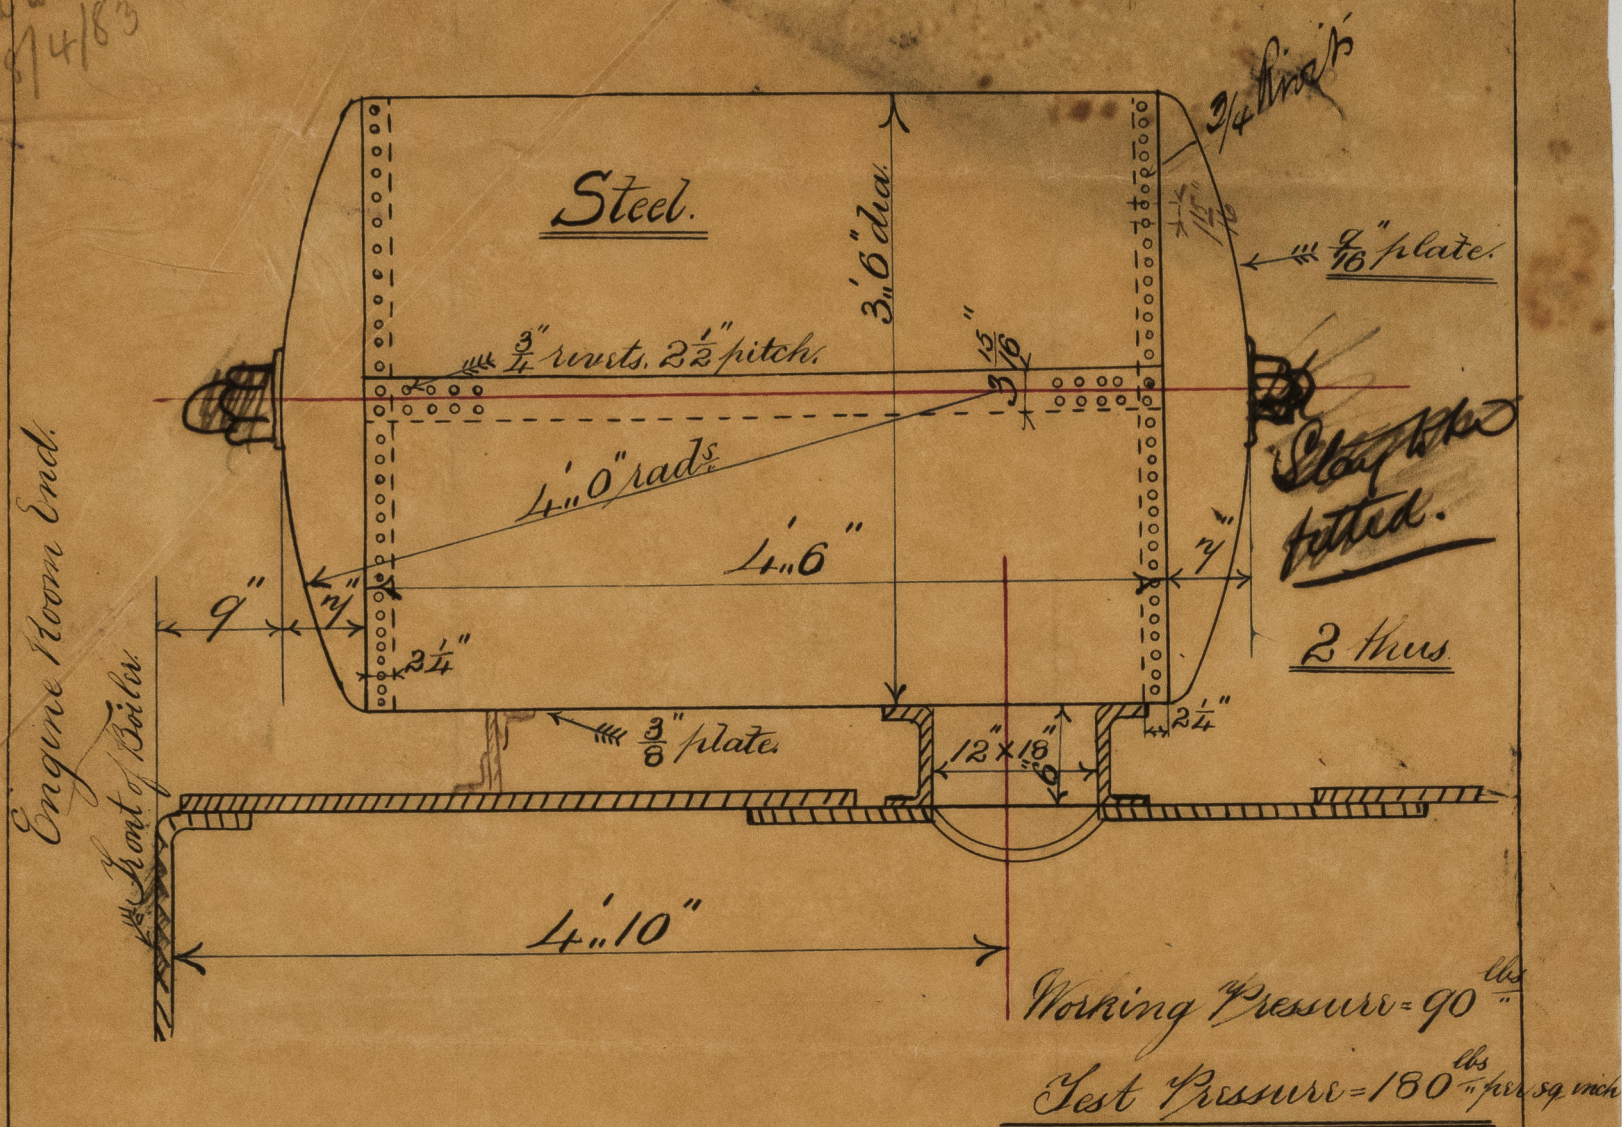

R. & W. HAWTHORN
Engineers,
NEWCASTLE-ON-TYNE

1874/83

Steam Dome.

Engine N^o 1911.

Geo. Wallcut.

Swan & Hunters

© 2021 12/4/83

Lloyd's Register
Foundation

NW 786-0020