

Lloyd's Register of British and Foreign Shipping.

(Received in the London Office, _____.)

F.

No. 385

REPORT ON SHIP FORGINGS.

Sir,

I beg leave to report that the undermentioned Forgings, manufactured by Messrs Carly & Bennett of Newcastle for the Vessel No. 15, being built by Messrs Campbell McIntosh & Bowstead of Scotwood have been inspected by me in course of being forged and smithed, and found to be, so far as can be seen, sound and

efficient

M 5/11/83

Mark on Forging.

Lloyd's

No. 385
5/83 7/83 10/83
266

I am, Sir,

Your Obedient Servant,


H. Cameron.

The Secretary,
London.

Sunderland.

	STERN FRAME.	RUDDER FRAME.	STEM.
Material* - - - -	<u>Scrap Iron</u>	<u>Scrap Iron</u>	<u>Scrap Iron</u>
How made - - - -	<u>Forged</u>	<u>Forged</u>	<u>Forged</u>
Dimensions - - - -	<u>9' x 5 1/2'</u>	<u>4' x 3 1/2'</u>	<u>9' x 2 1/2'</u>
Progress on Inspection -	<u>Forging & Smithing</u>	<u>Forging & Smithing</u>	<u>Forging</u>
Dates when Inspected	<u>July 6-16 20-26-30th</u>	<u>Oct 4-15-19-26th</u>	<u>May 22-30th</u>

SKETCHES OF FRAMES SHEWING POSITION AND DESCRIPTION OF WELDS.

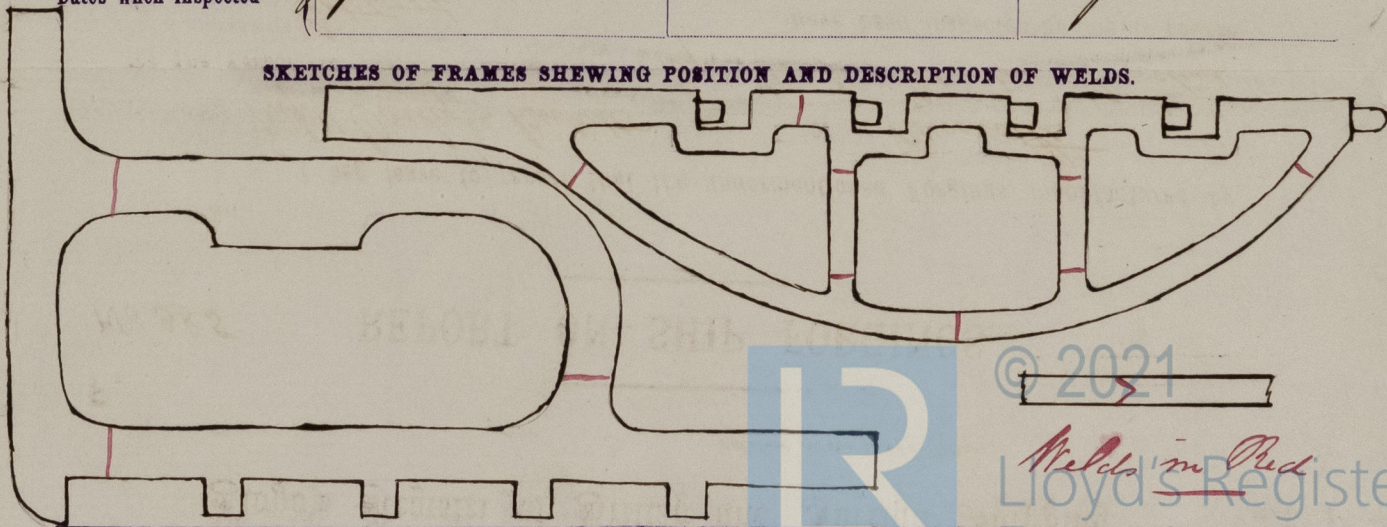

* If of iron, state whether scrap or puddled iron.

Campbells No. ~~247~~
No. 13

S.S. "Saint Asaph"
Proc. Report No. 17433

REPORT ON SHIP FORGINGS.

Register of British and Foreign Shipping.



© 2021

Lloyd's Register
Foundation