


Dr. to Mr. W. C. C.
1843.

— Deck Plan. S. S. No. 200 —

- Dimensions -

Length as per Rule	257.5
Breadth " " "	35.83
Depth " " "	17.5 to M.O.
" " " "	21.5. 2.D.

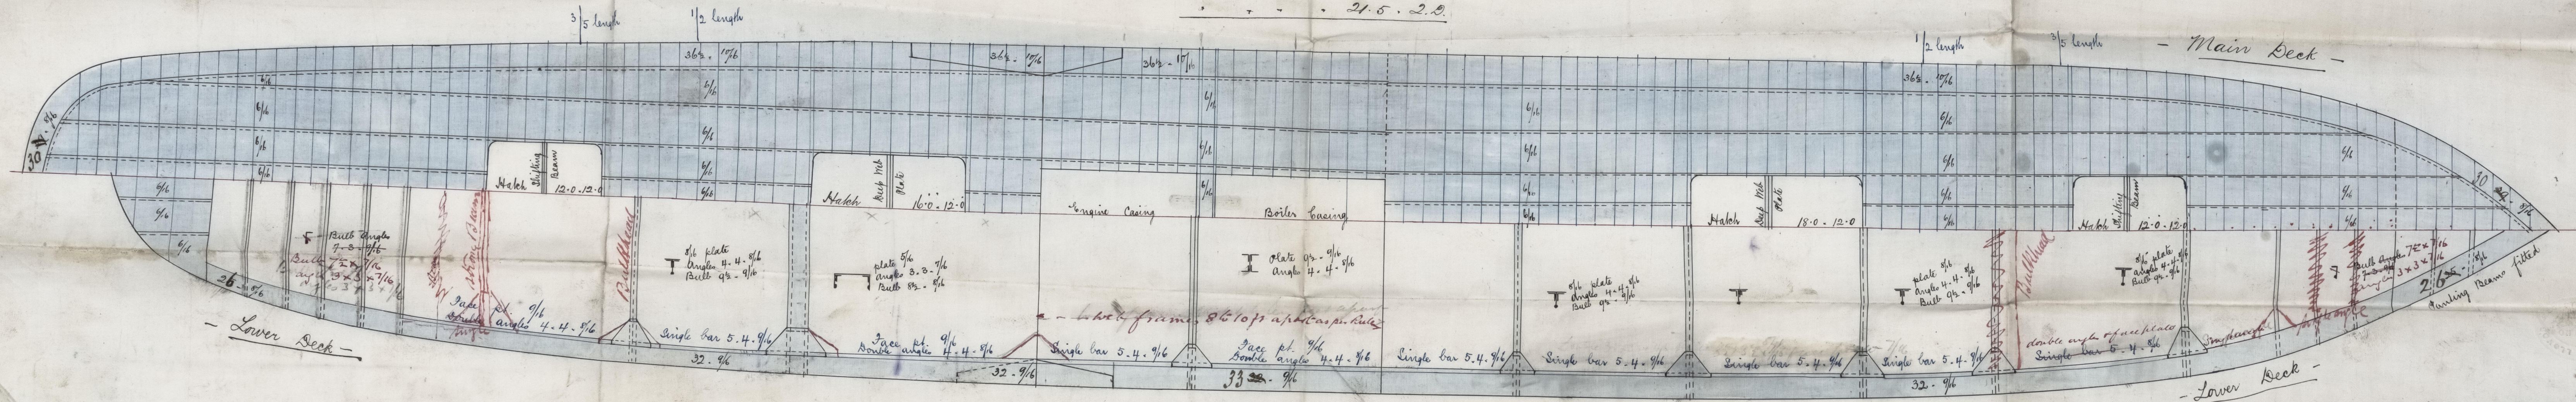

JOHN READHEAD & C
Shipbuilders,
SOUTH SHIELDS

NW6790-0087 © 202

© 2021
Lloyd's Register
Foundation