

# Lloyd's Register of British and Foreign Shipping.

(Report on Vessel No. \_\_\_\_\_ Port \_\_\_\_\_)

No. 339

## SHIP FORGINGS OR CASTINGS.

The words FORGINGS or CASTINGS, IRON or STEEL, should be struck out as may be required.

I have to report that the undermentioned Iron or ~~Steel~~ Forgings or Castings, manufactured by Messrs A Leslie & Co of Woburn for the Vessel No. 249, being built by Messrs A Leslie & Co of Woburn have been inspected by me as set forth below, and found to be, so far as can be seen, sound and efficient.


Mark on Forgings.

Lloyd's  
No. 339  
H.C.


H. Cameron.  
Sunderland.

	STERN FRAME.	RUDDER FRAME.	STEM.
Material* - - - -	<u>Scrap Iron</u>		<u>Scrap Iron</u>
How made - - - -	<u>Forged</u>		<u>Forged</u>
Dimensions - - - -	<u>10' x 6'</u>		<u>10' x 2 3/4'</u>
Progress on Inspection -	<u>Forging &amp; smithing</u>	<u>Not seen</u>	<u>Forged.</u>
Dates when Inspected	<u>May 4-8. 18. 28/31 June 12</u> <u>July 10-30 Aug 2/83</u>		<u>Sept 5/83</u>

SKETCHES OF FRAMES SHEWING POSITION AND DESCRIPTION OF WELDS OF FORGINGS, OR PARTICULARS OF TESTS APPLIED TO CASTINGS.

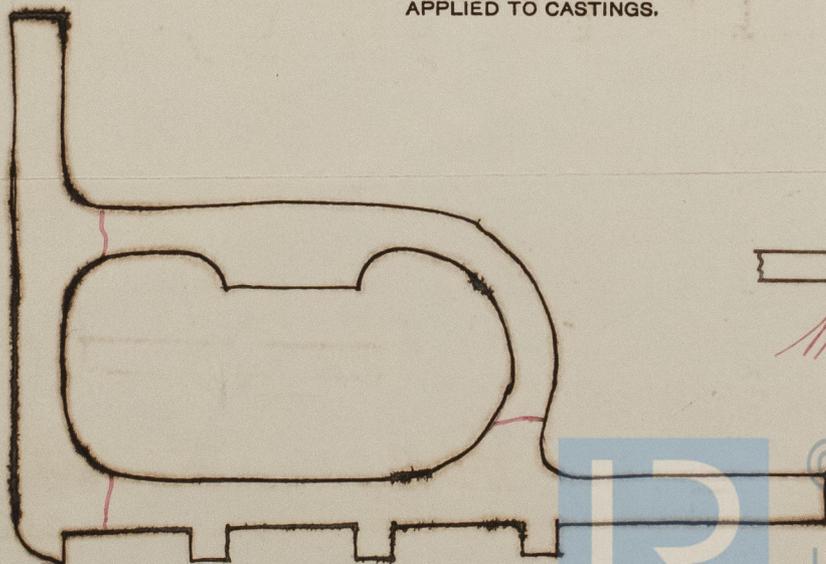

Welds in Red

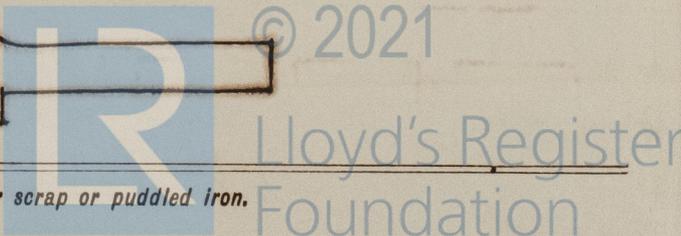

Map. Leshe's No  
249

Proc. Report No. 1755-3



© 2021

Lloyd's Register  
Foundation