RECEIVED 12th APL. 83.

S.S. "Port Darwin" Nwc. Report No. 1755-3

100A MIDSHIP SECTION FOR A SPAR DECK STEAMER. No: 249

Lr: to No: She:
16/4/83.

PRINCIPAL DIMENSIONS

LENGTH BETWEEN PERPS	300·0
BEAM (MOULDED)	37·0
DEPTH (TOP OF KEEL TO UNDERSIDE OF SPAR DECK AMIDSHIPS)	29·4
DEPTH (TO UNDERSIDE OF MAIN DECK)	21·10

SCALE ½" = 1 FOOT

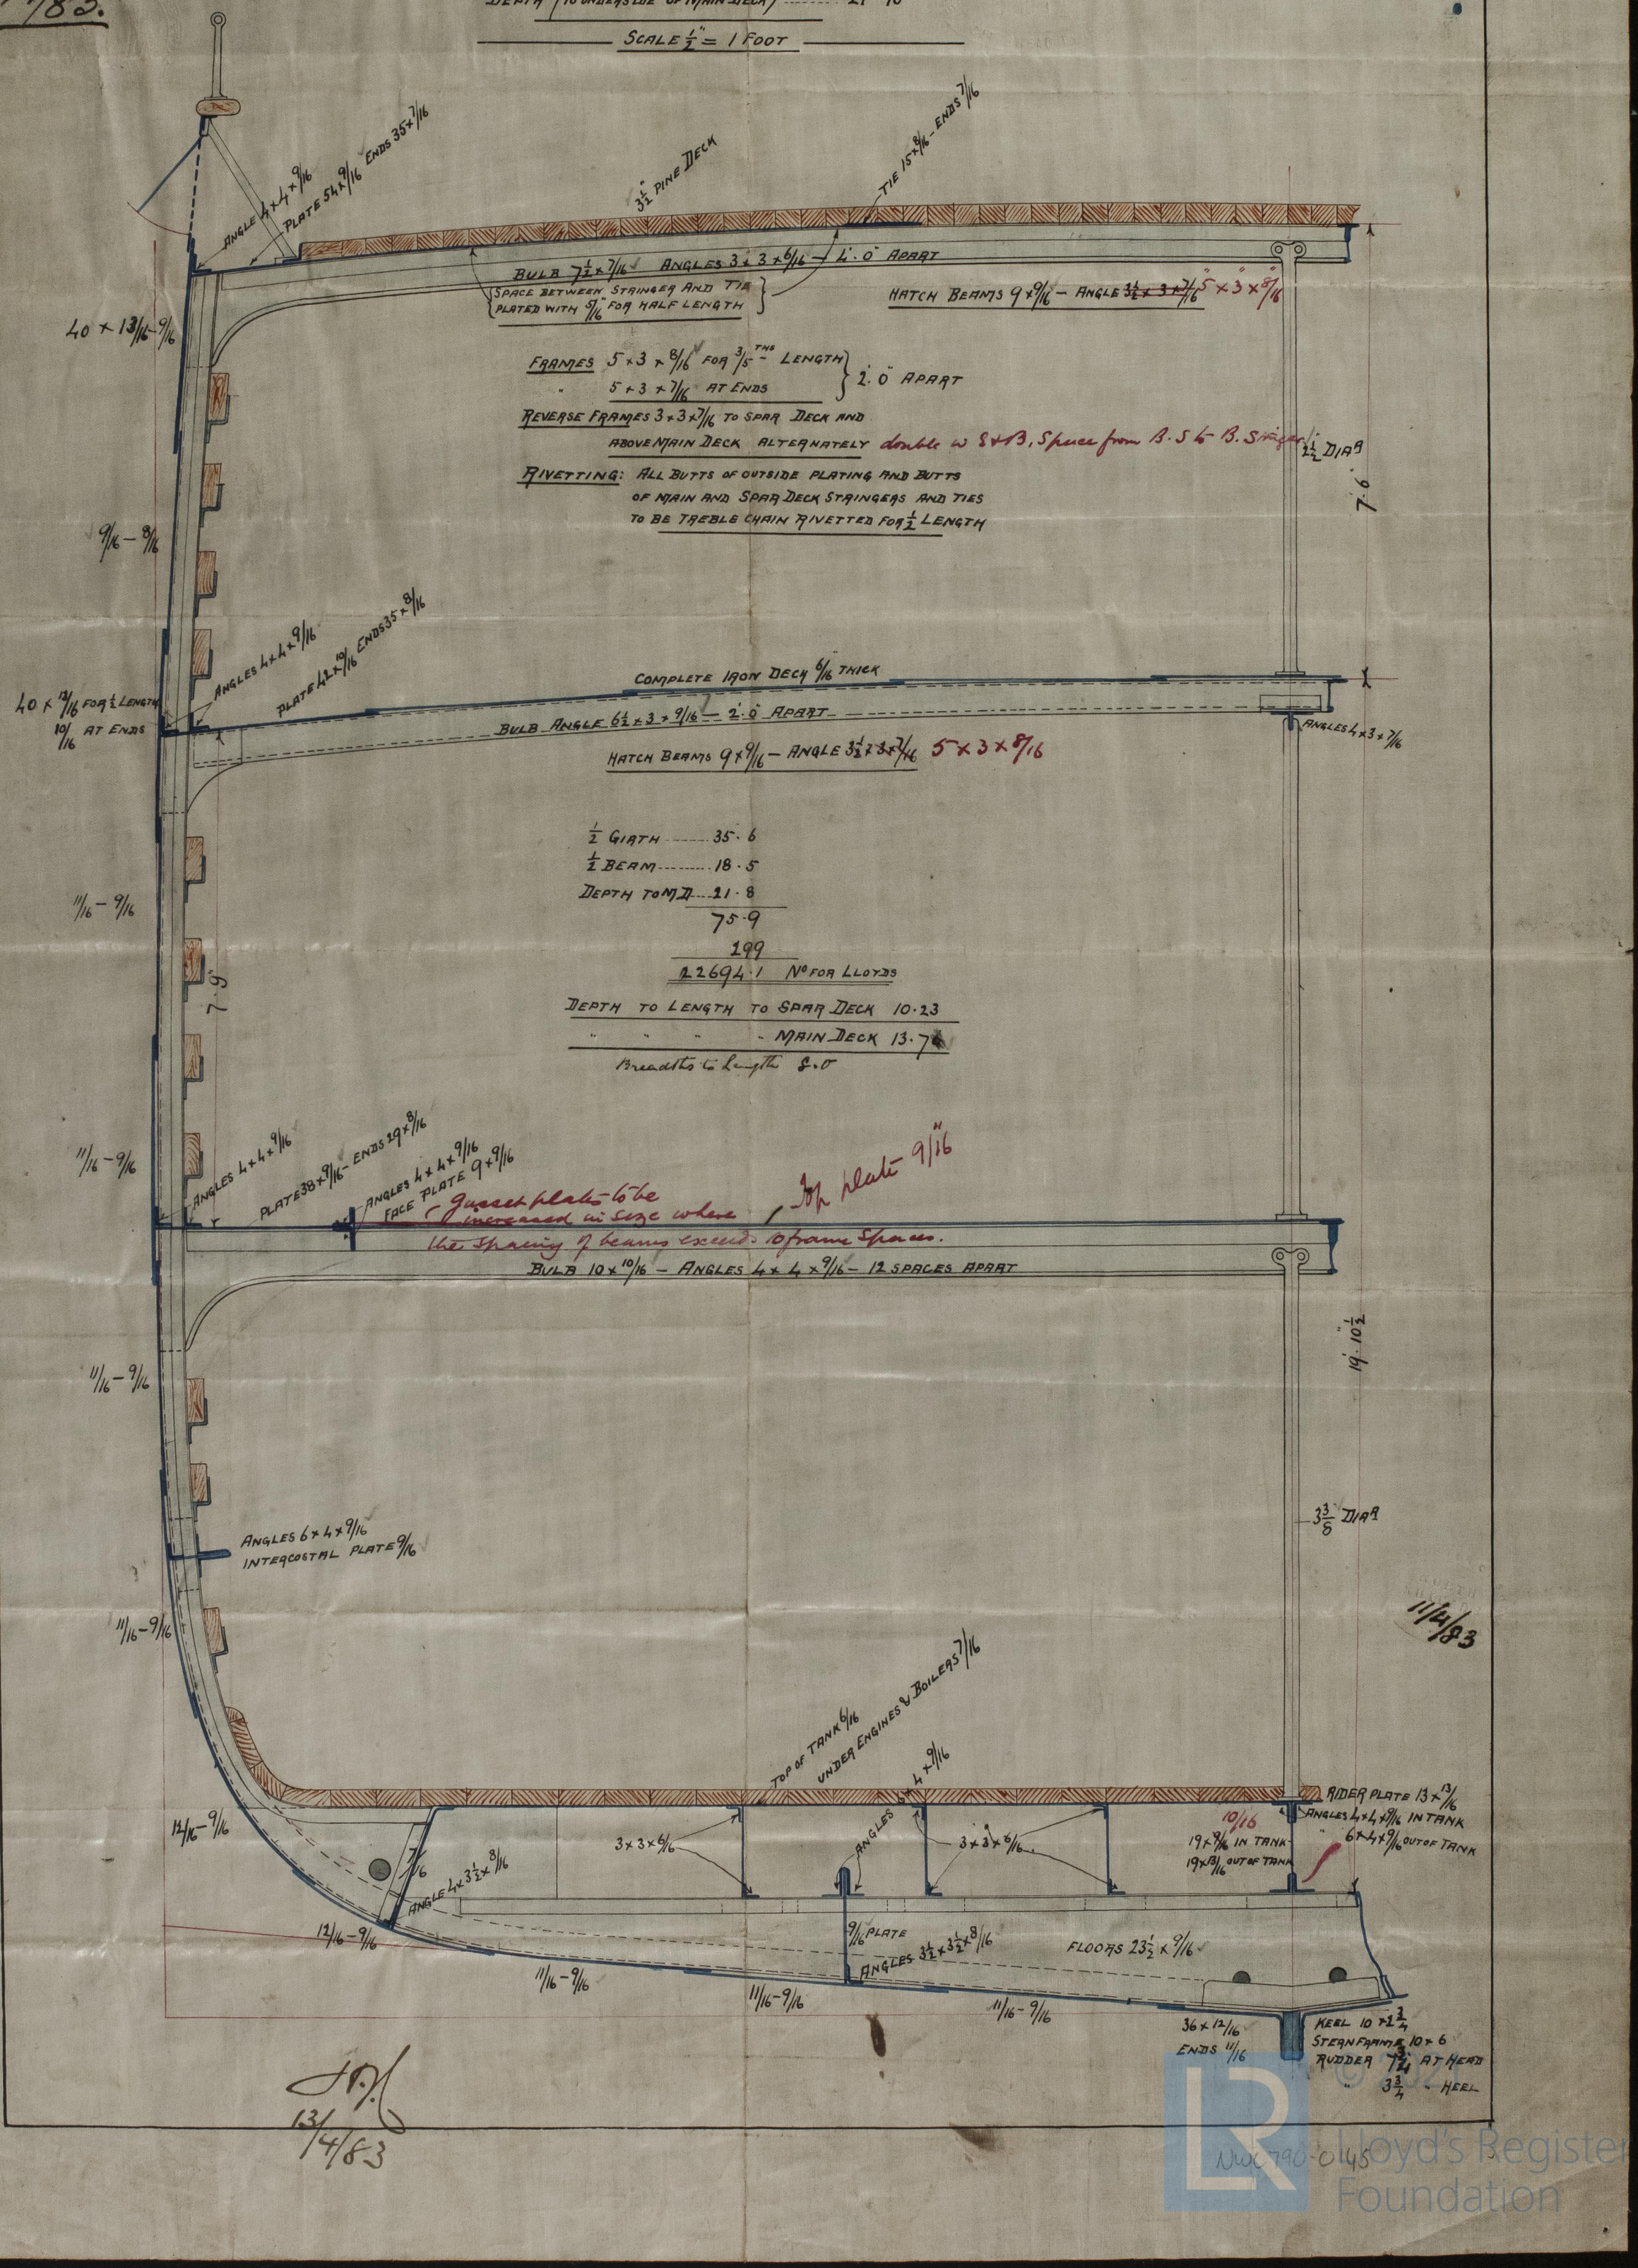

13/4/83

© 2022 Lloyd's Register Foundation
NWC790-0145