

LLOYD'S REGISTER OF SHIPS  
25 JUN. 85  
LONDON

S.S. "Konpareil" No. Report No.

Freeboard Report No. 17517

Midship Section S No 88


To Class 100 A Lloyds.

No 379

At: to No. 30/6/83.

|                    |           |
|--------------------|-----------|
| Half Girth         | 32.2      |
| Breadth            | 11.4      |
| Depth              | 4.3       |
| Length as per Rule | 265.6     |
|                    | 413.4     |
|                    | 344.5     |
|                    | 413.4     |
|                    | 13.78     |
|                    | 18,200.84 |
|                    | 1,822.9   |
|                    | 20,124.7  |

Registered Dimensions  
265.6 DP x 35.0 ft. x 14.5 ft. floors

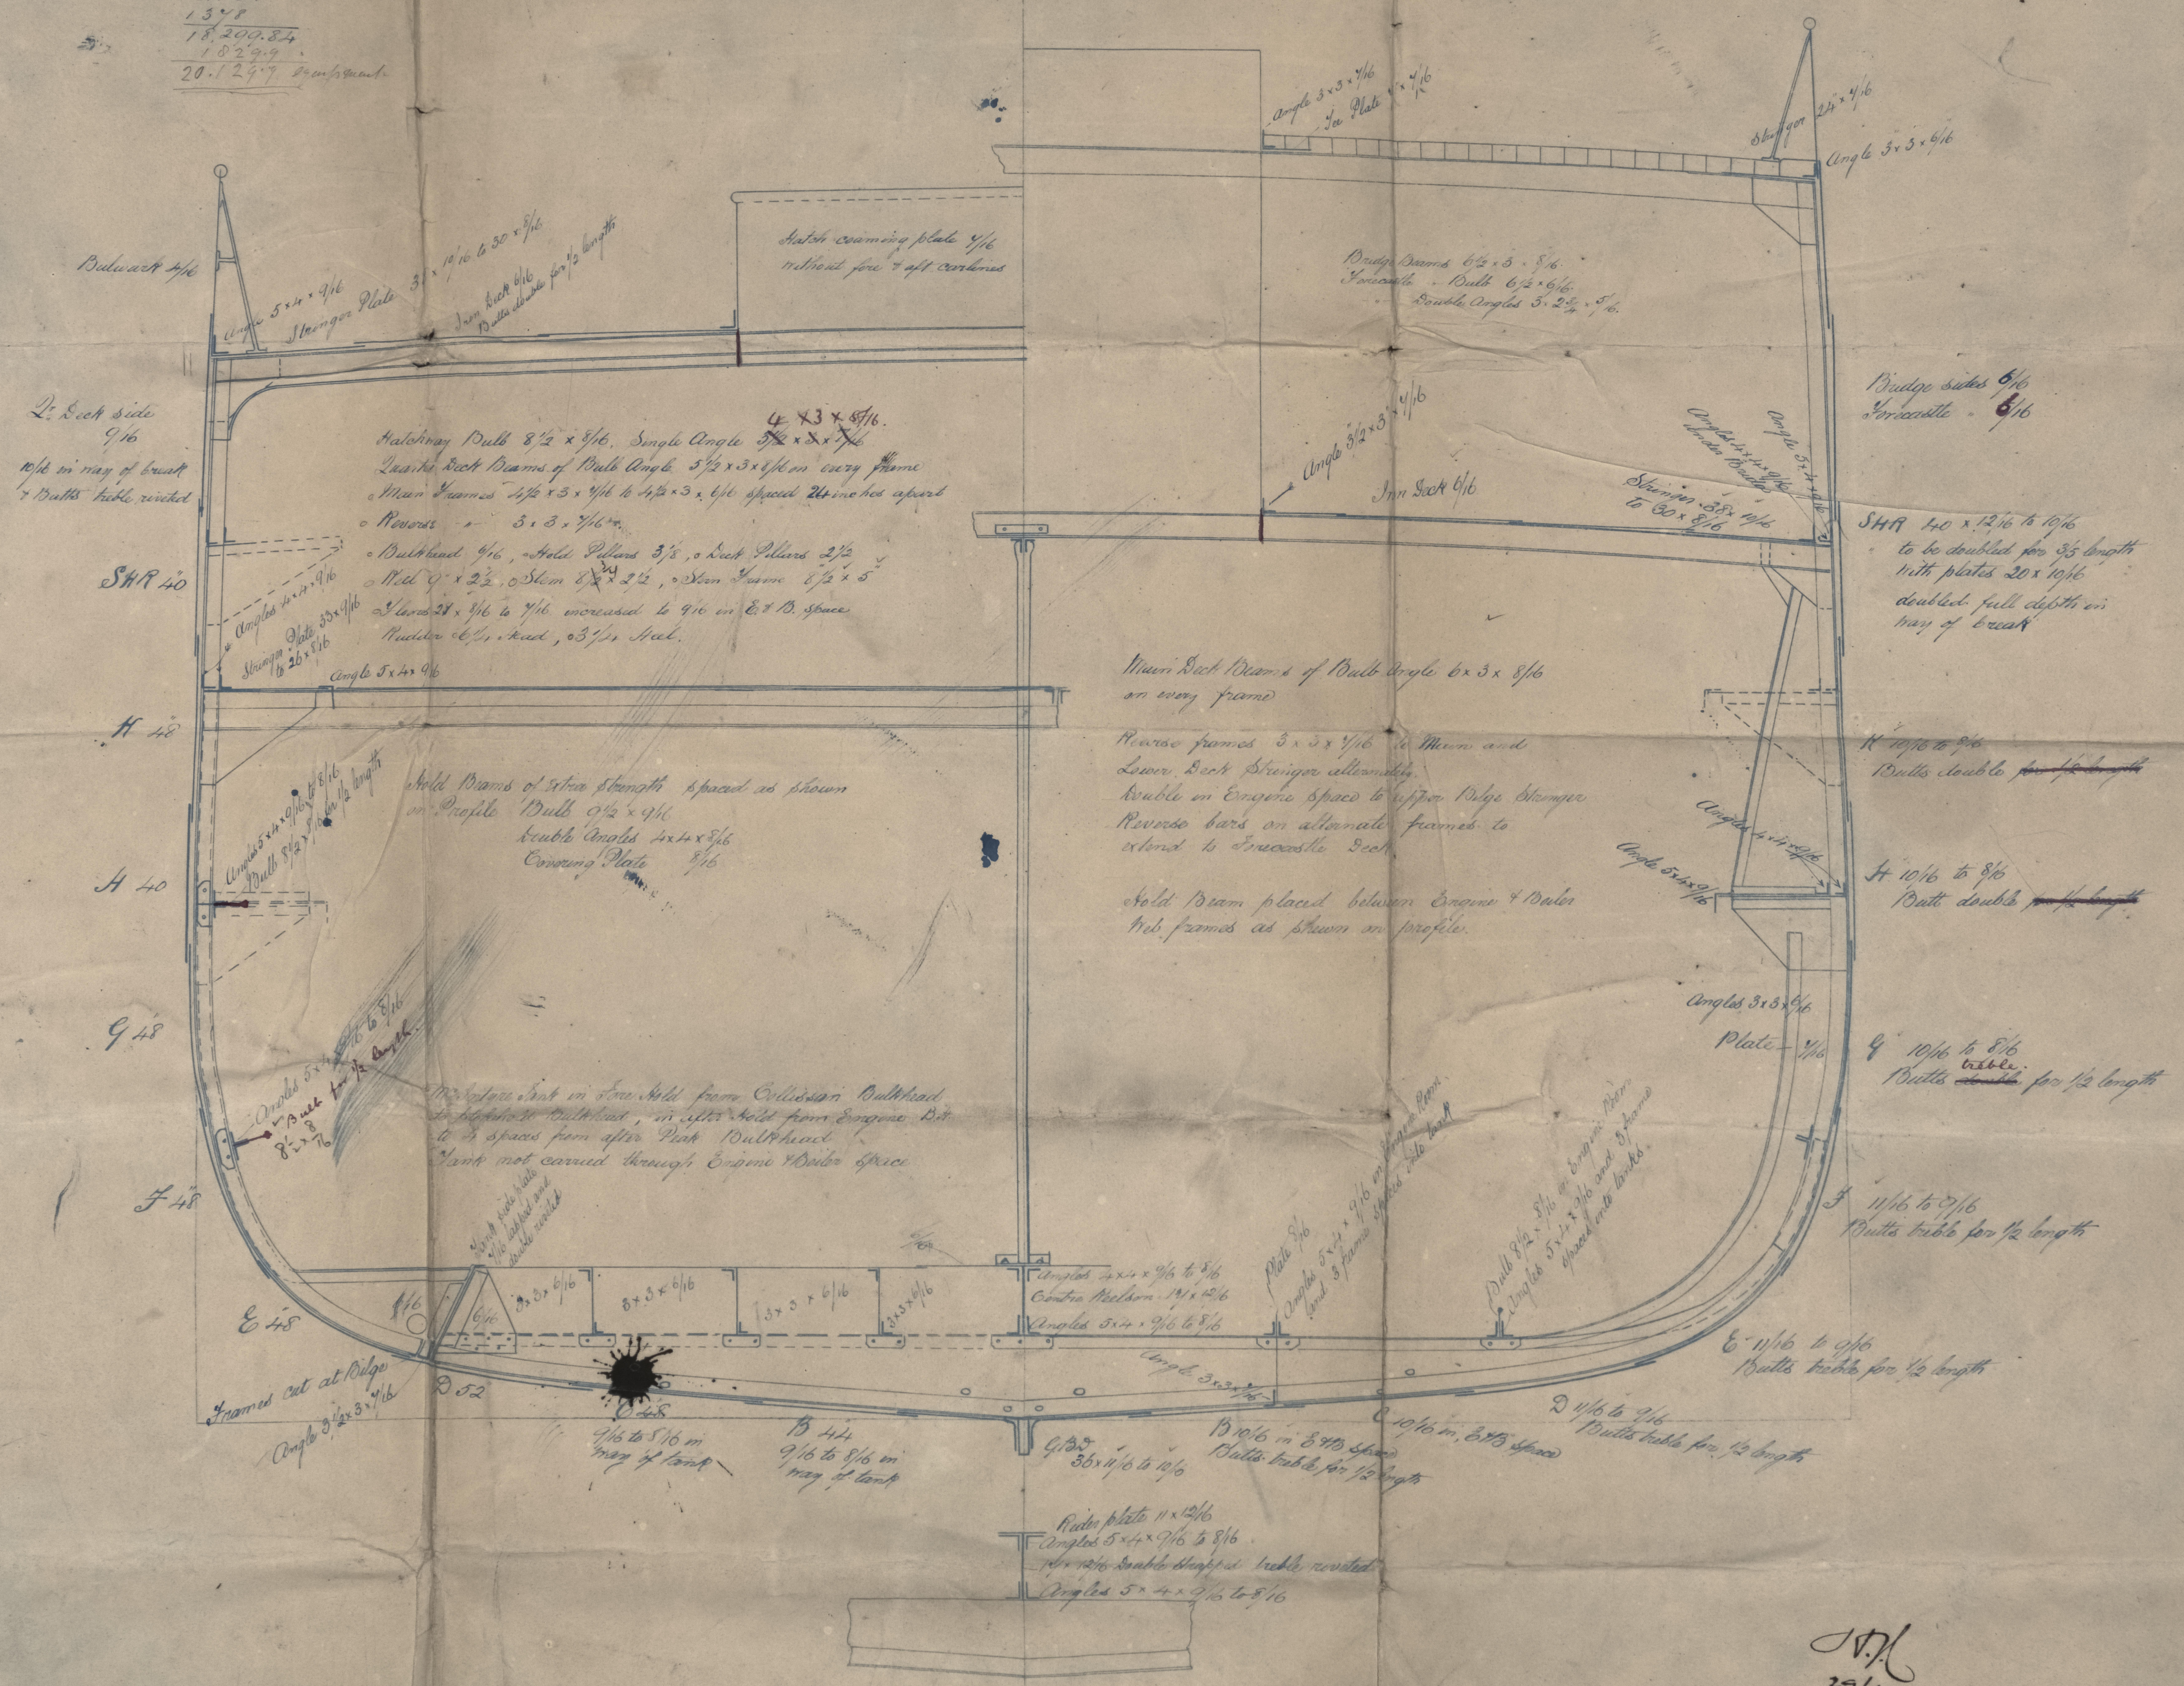

Plan of Middle Line Keelson  
in Engine Space  
Scale 1/2 Inch per foot

27/6/83

28/6/83

NWC790-0775





*Handship Section*

10



5

*4*  
Konpareil 8/s  
Nov. 175-86.



© 2021  
Lloyd's Register  
Foundation

NW6790-0175