


S.S. "Nonpareil" Inc. Report No. 17586


23'-0"

6'-0"

S.S. "Nonpareil"
24/10/83

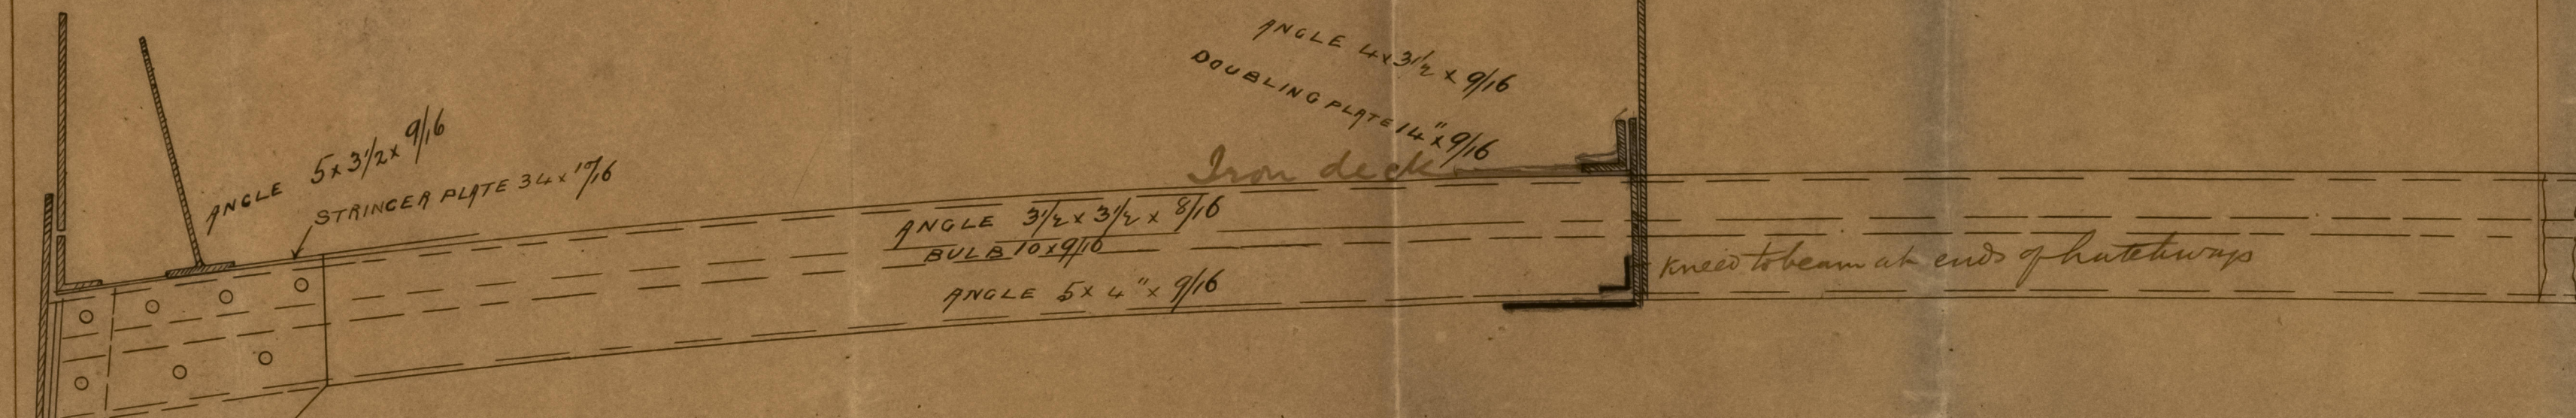

SECTION OF THWAARTSHIP
BEAMS AT HATCH ENDS

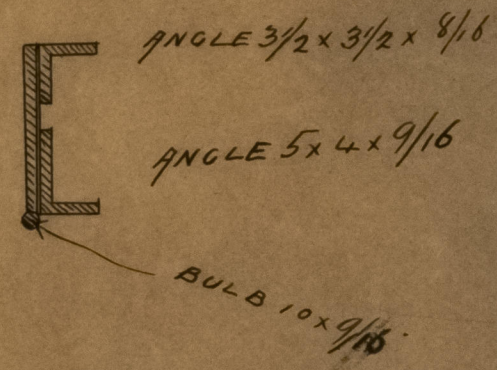


PLAN OF THWAARTSHIP BEAMS AT HATCH ENDS

SCALE INCH PER FOOT.

SS. No 88

PLAN OF HATCHWAY BEAMS

SCALE 1/2" = 1 FOOT

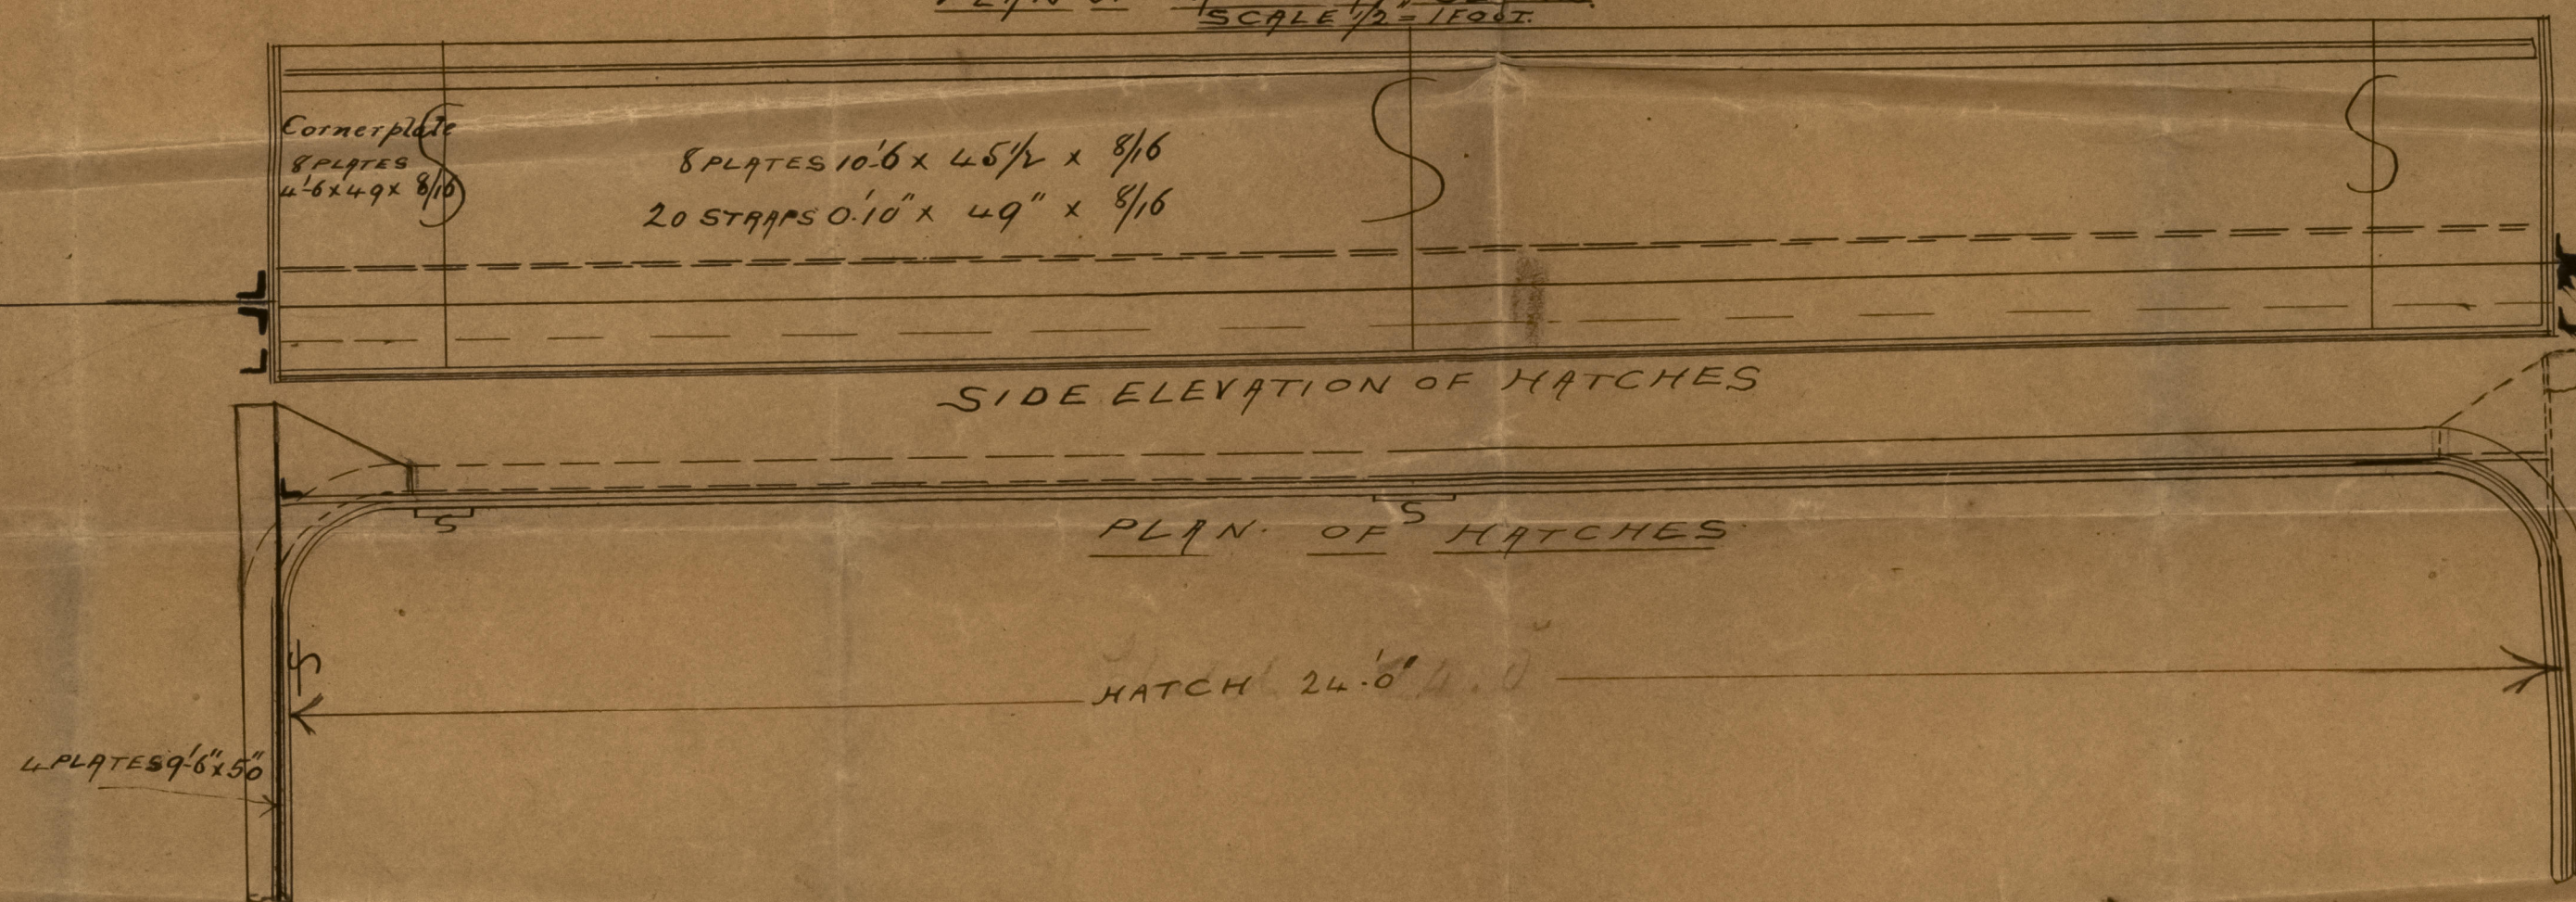


SIDE ELEVATION OF HATCHES

PLAN OF HATCHES


16.4

N. of tracing 565.

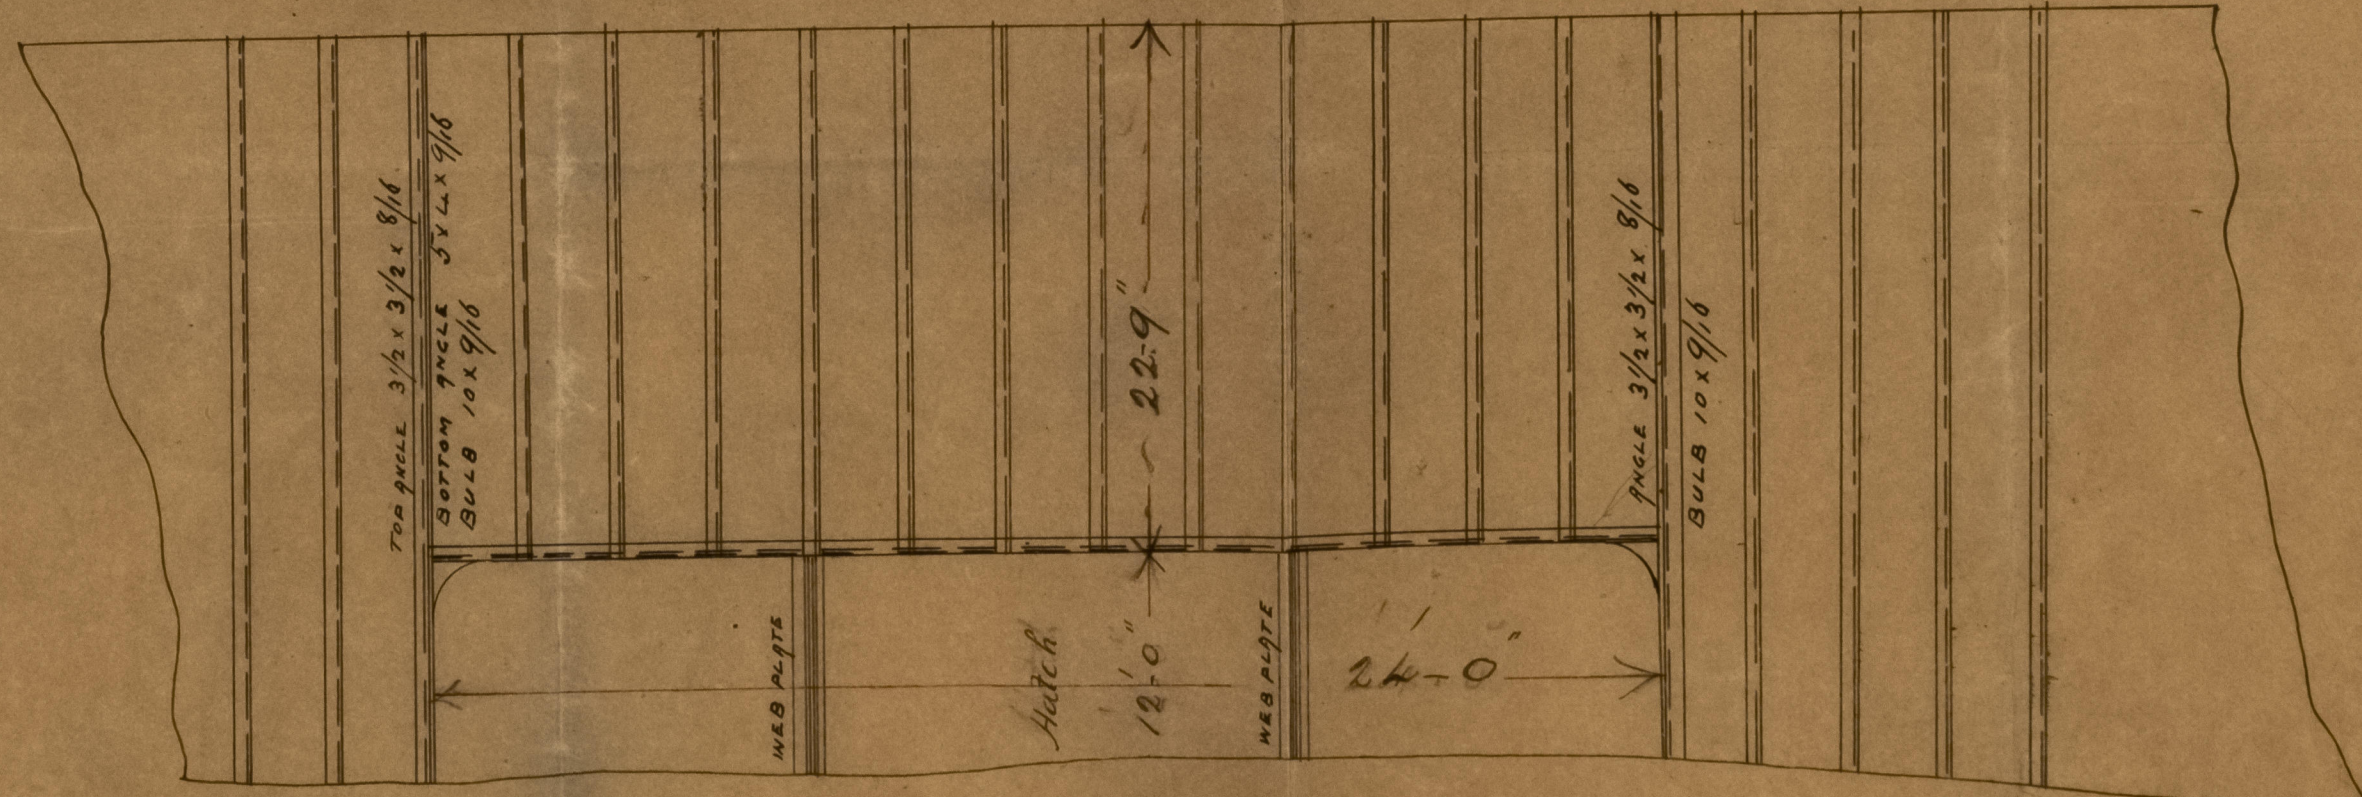

PLAN OF MAIN AND AFTER HATCHES

SCALE 1/4" PER FOOT.

123
7.8
6

12 OCT 83



22/10/83

NW790-016

Lloyd's Register
Foundation