


LLOYD'S REGISTER OF SHIPS
20 JUN. 83
LONDON

At: to flow:
30/6/83.

ss "Nonpareil" Acc. Report No.
Frederick Report No 17517

— Profile and Deck Plan of S.S. 88 —

N 9380

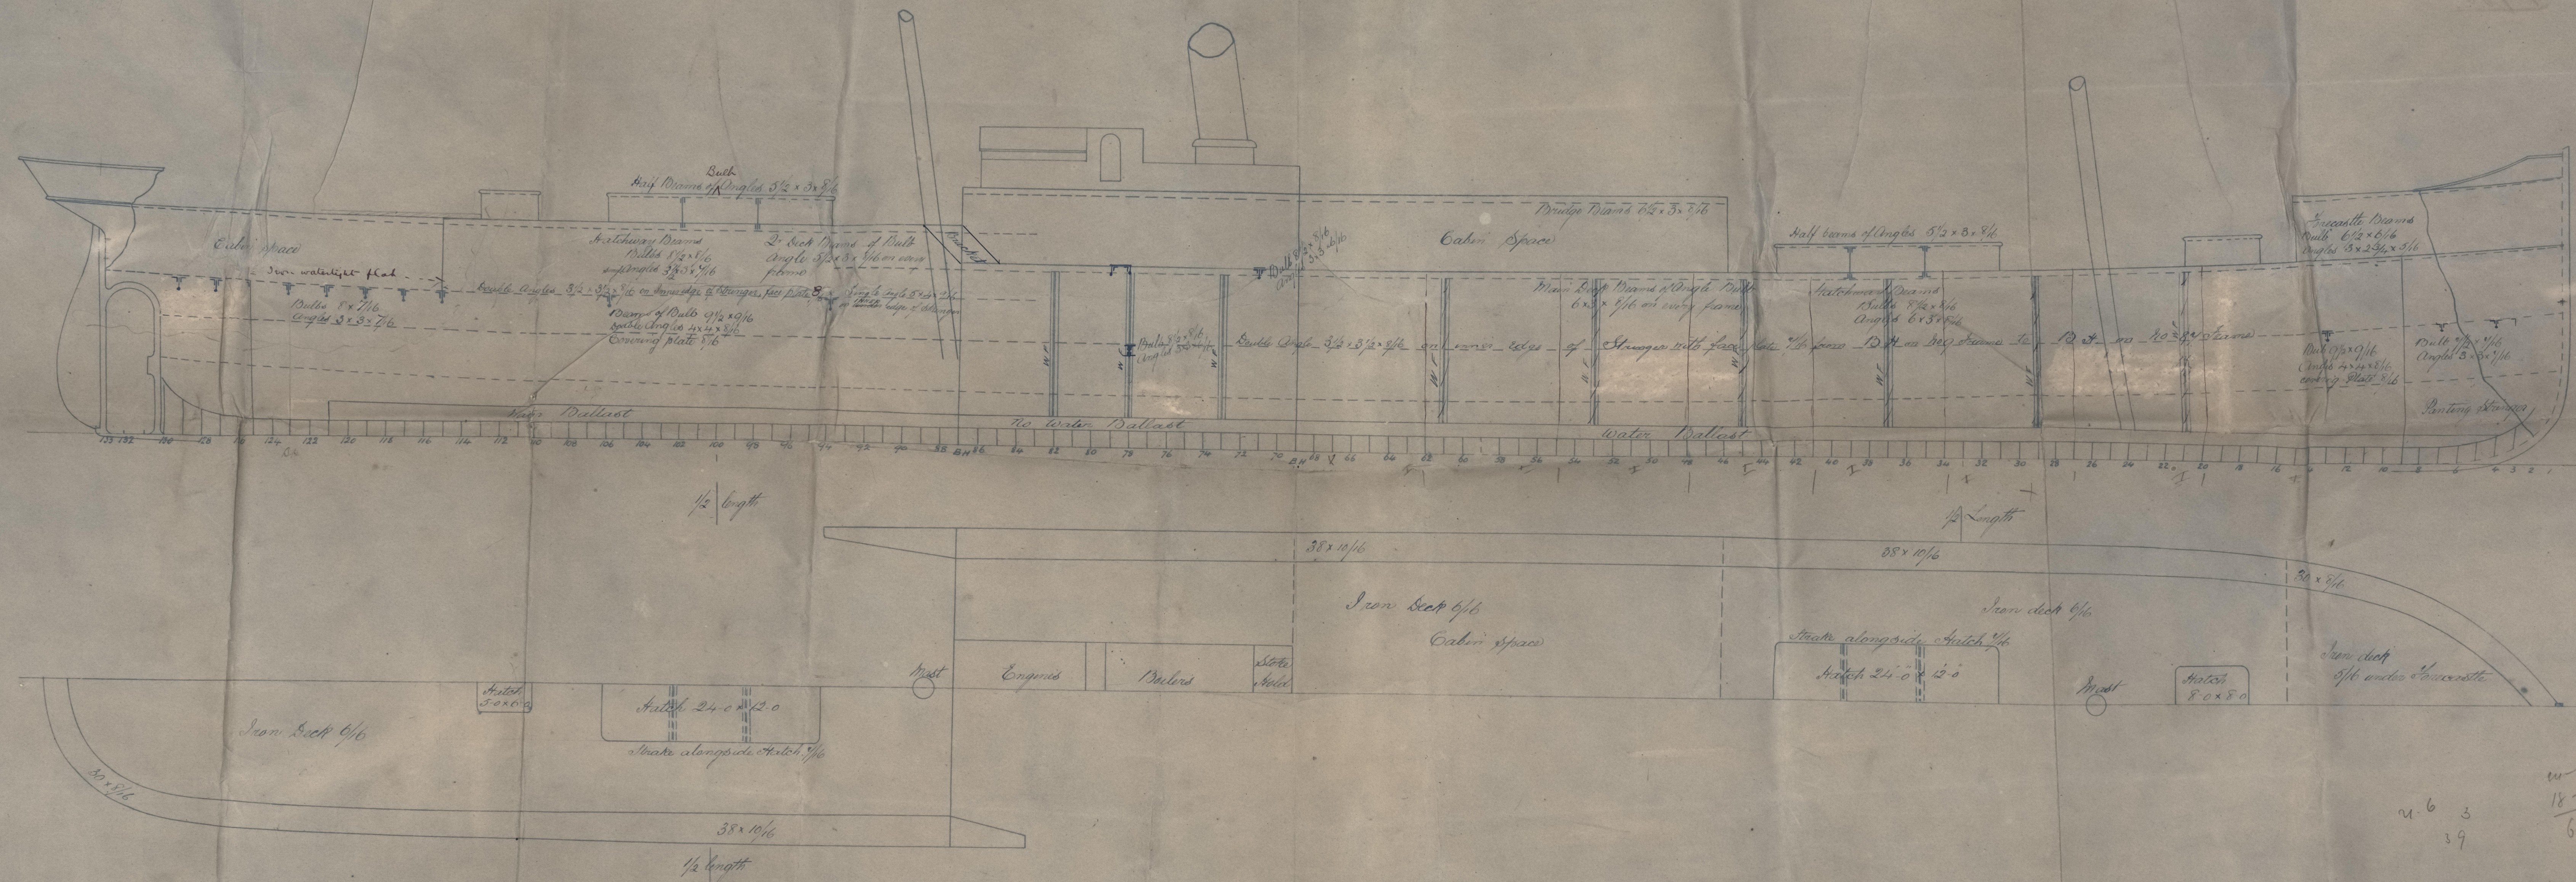

— Scale 1/8 Inch per foot —

u. 6 3
39
u. 6 18-6
6-0

10/6
27/6/83

28/6/83

NWCT90-0179


SS 88

Nonpareil S/B

No. 17586

NWCT90-0179

10

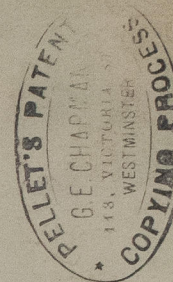

5

