

Lloyd's Register of British and Foreign Shipping.

(Received in the London Office,

25 OCT 83

F.

No. 530

REPORT ON SHIP FORGINGS.

Sir,

I beg leave to report that the undermentioned Forgings, manufactured by
Wm. The Lye Forge Co of *Sunderland*
 for the Vessel No. *88*, being built by *Wm. J. & W. Smith*
 of *North Shields* have been inspected by me in course
 of being forged and smithed, and found to be, so far as can be seen, *sound and*
efficient

Mark on Forging.

Lloyd's

No. 530

10/83

26/10

I am, Sir,

Your Obedient Servant,

J. Cameron.


The Secretary,
 London.

Sunderland.

D.F.
26/10/83

	STERN FRAME.	RUDDER FRAME.	STEM.
Material* - - - -	<i>Scrap Iron</i>	<i>Scrap Iron</i>	
How made - - - -	<i>Forged</i>	<i>Forged</i>	
Dimensions - - - -	<i>8 3/8" x 11 1/8"</i>	<i>6 1/4" x 3 1/4"</i>	
Progress on Inspection -	<i>finished</i>	<i>smithing</i>	<i>Not seen</i>
Dates when Inspected	<i>Sept 12 Oct 10th</i>	<i>Sept 12. 24 Oct 1-10th</i>	

SKETCHES OF FRAMES SHEWING POSITION AND DESCRIPTION OF WELDS.

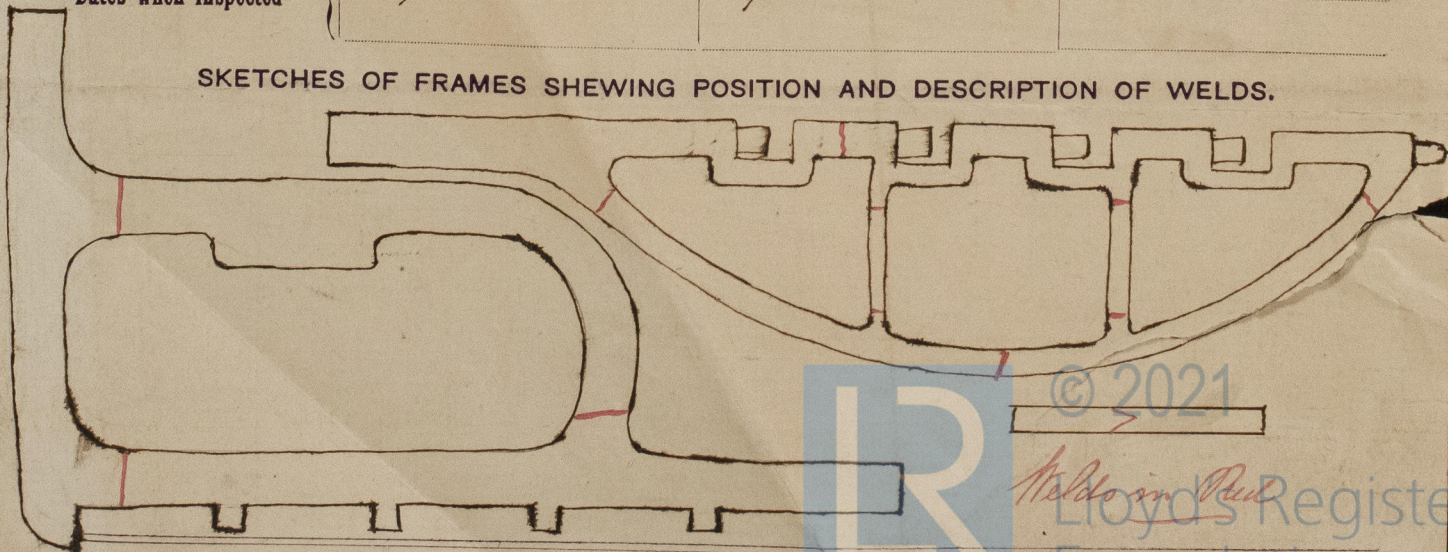

Y W. Smith No. 88
S.S. "Nonpareil"
Proc. Report No. 145-86



© 2021

Lloyd's Register
Foundation