


— Amended —  
Longitudinal Section  
 — of —  
N<sup>o</sup> 467 & 8  
 S.S. "Yamashiro Maru" Suez Report No. 17549  
 — 6<sup>th</sup> March Suez Report 1965H

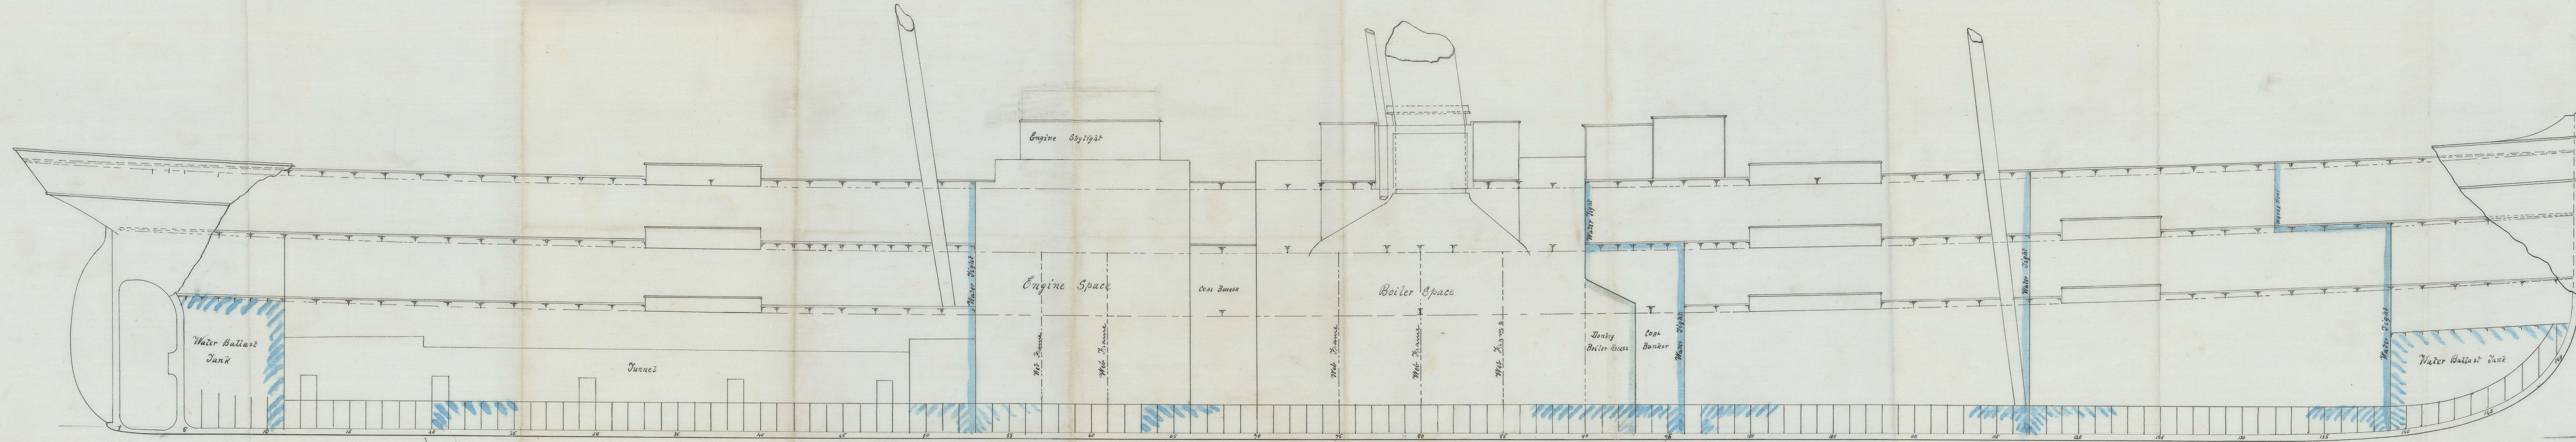

W. G. ARMSTRONG, MITCHELL & CO. LIMITED,  
 NEWCASTLE-UPON-TYNE.  
 NO 1381 DATE May. 1. 1884.  
 SHIPBUILDING DEPARTMENT.