LLOYD'S REGISTER OF SHIPPING
6 JUN. 83
LONDON

LLOYD'S REGISTER OF SHIPPING
20 SEP. 83
LONDON

LLOYD'S REGISTER OF SHIPPING
RECEIVED
12 DEC. 83
LONDON

Lr. to N.W.C.:
11/6/83.
21/9/83.
8/10/83.
17:12:83.

S.S. "Yamashiro Maru" N.W.C. Report No. 17549

~~"Emi Maru" N.W.C. No. 17454~~

Midship Section of Spar decked Steamer

300 pp x 37.0 mld x 30.0 mld

Scale ½ = 1 Foot.

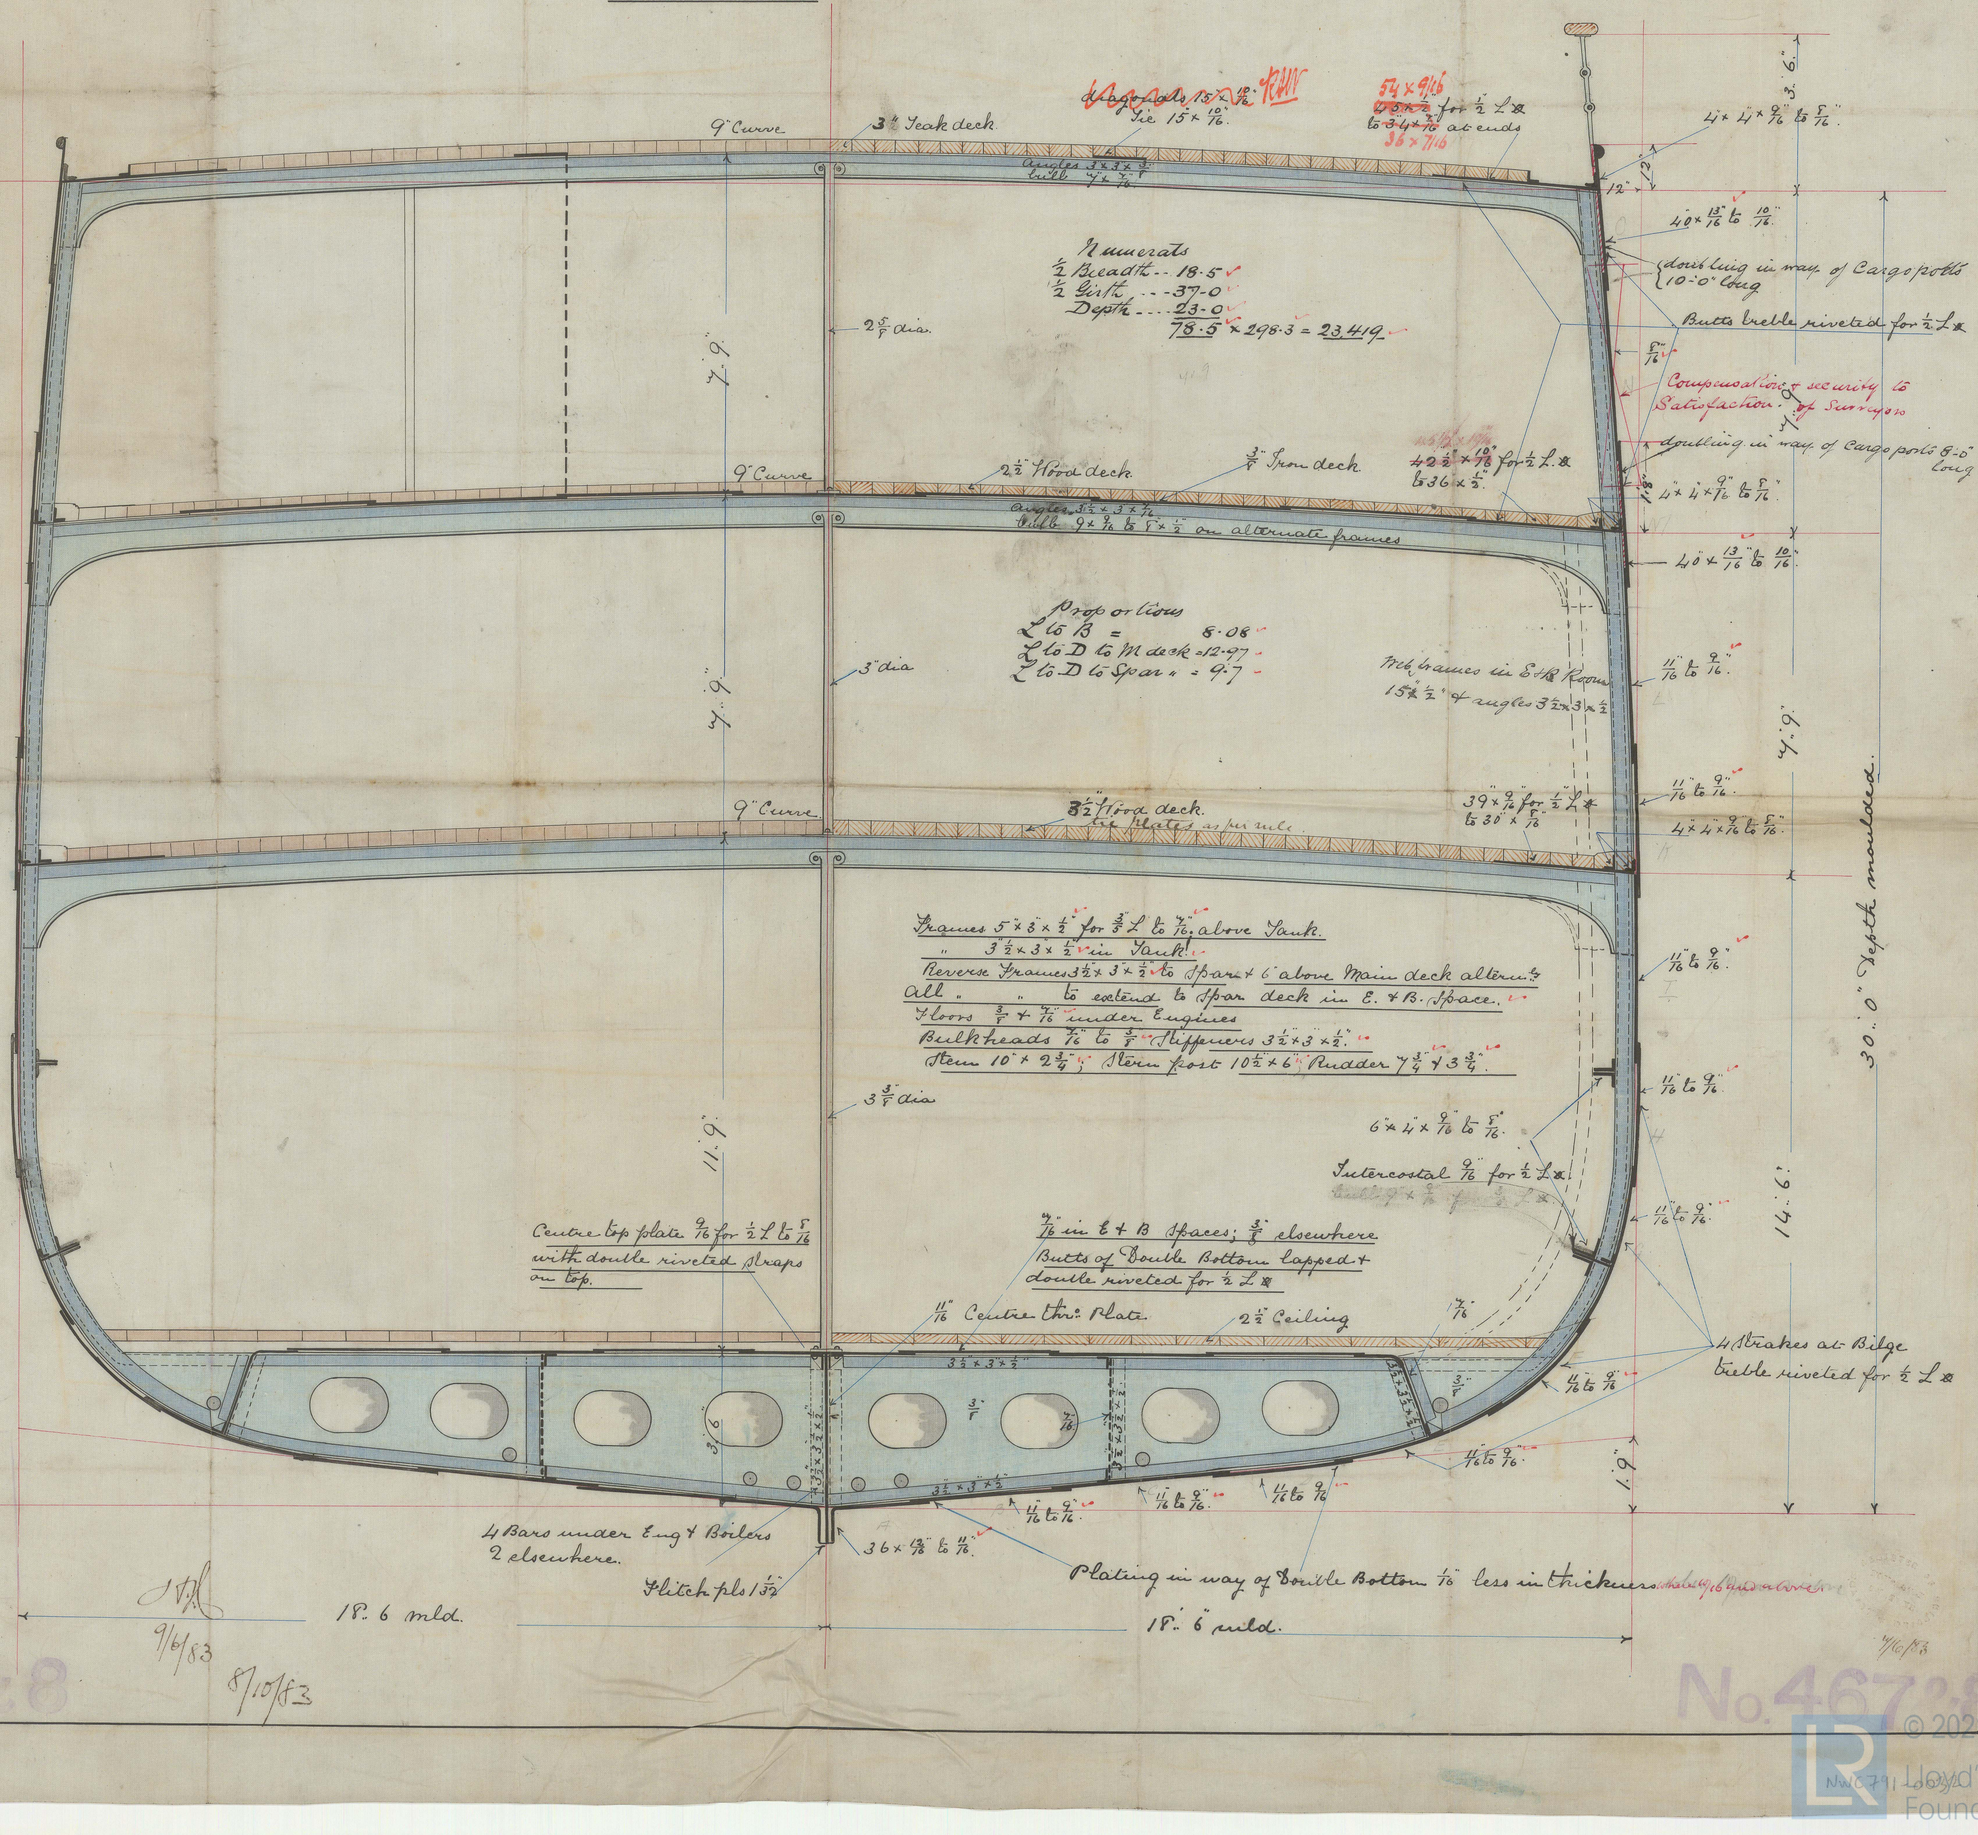

LLOYD'S REGISTER OF SHIPPING
17 AUG. 83
LONDON

W. G. ARMSTRONG, MITCHELL & Co. LIMITED.
NEWCASTLE upon TYNE.
No. 489 DATE 30/5/1883
SHIPBUILDING DEPARTMENT.

9/6/83
8/10/83

No. 467 & 8

No. 467 & 8

© 2021 Lloyd's Register Foundation
NWC791_26632