

Lloyd's Register of British and Foreign Shipping.

(Report on Vessel No. _____ Port _____)

No. 406

SHIP FORGINGS OR CASTINGS.

I have to report that the undermentioned Iron or ~~Steel~~ Forgings or Castings, manufactured by Wm & John March & Co. of Durston for the Vessel No. 468, being built by Sir H G Armstrong Mitchell & Co. of Lowthall have been inspected by me as set forth below, and found to be, so far as can be seen, Sound and efficient.

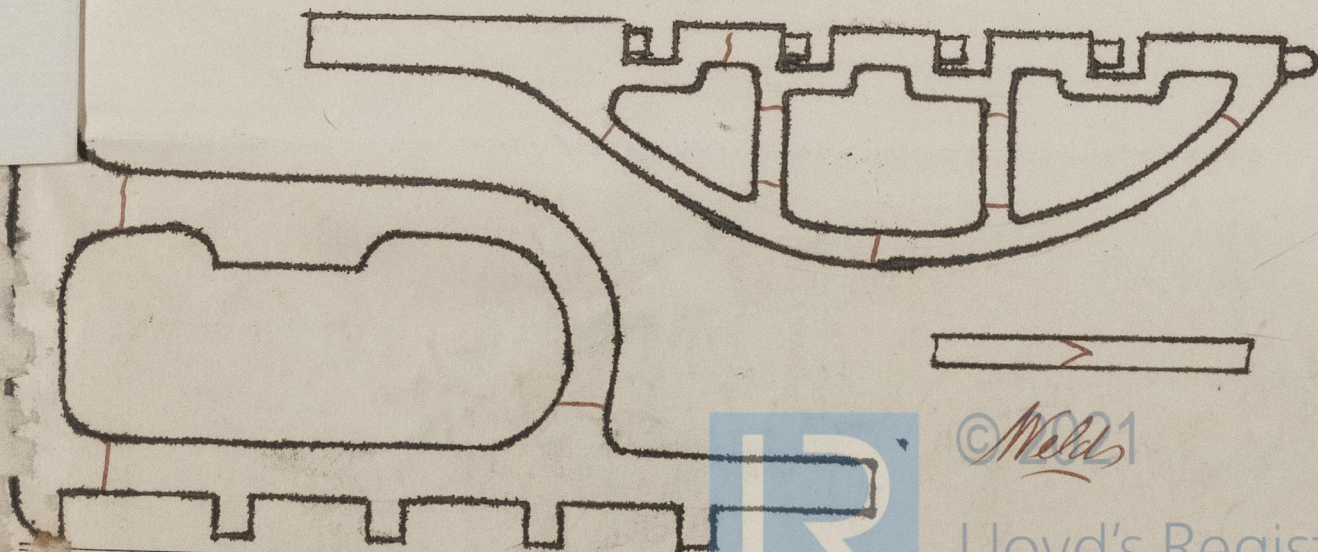
Mark on Forgings.

Lloyd's

No. 406W. & J. M.J. B. Cameron.Sunderland.

	STERN FRAME.	RUDDER FRAME.	STEM.
Material*	<u>Scrap Iron</u>	<u>Scrap Iron</u>	<u>Scrap Iron</u>
made	<u>Forged</u>	<u>Forged</u>	<u>Forged</u>
Dimensions	<u>10 x 6"</u>	<u>8 7/8" x 4 1/4"</u>	<u>10 x 2 3/4"</u>
Process on Inspection	<u>Forging & smithing</u>	<u>Smithing</u>	<u>Forged.</u>
When Inspected	<u>June 14-8-14-16 July 12</u> <u>Aug 2-7-12-24/83</u>	<u>Dec 28 Aug 10.30</u> <u>July 11/84</u>	<u>Aug 7/83</u>

ETCHES OF FRAMES SHEWING POSITION AND DESCRIPTION OF WELDS OF FORGINGS, OR PARTICULARS OF TESTS APPLIED TO CASTINGS.

© M. & J.

Lloyd's Register
Foundation

No. 468
S.S. "Omni Maru"
Proc. Report No. 17654



© 2021

Lloyd's Register
Foundation