

Lloyd's Register of British and Foreign Shipping.

(Report on Vessel No. _____ Port _____)

No. 34, A.

SHIP FORGINGS OR CASTINGS.

I have to report that the undermentioned Iron or Steel Forgings or Castings, manufactured by Messrs The Palmer, S.B. Co. of Janow for the Vessel No. 538, being built by Messrs The Palmer, S.B. Co. of Janow have been inspected by me as set forth below, and found to be, so far as can be seen, sound and efficient.

Mark on Forgings.

Lloyd's

No. 34, A.


S.B. Co.

H. Cameron.

Sunderland.

	STERN FRAME.	RUDDER FRAME.	STEM.
Material* - - - -	<u>Scrap Iron</u>	<u>Scrap Iron</u>	<u>Scrap Iron</u>
How made - - - -	<u>Forged</u>	<u>Forged</u>	<u>Forged</u>
Dimensions - - - -	<u>10" x 6"</u>	<u>7 3/4" x 14"</u>	<u>9" x 3"</u>
Progress on Inspection -	<u>Smithed</u>	<u>Forged & Smithed</u>	<u>Forged</u>
Dates when Inspected	<u>Feb'y 1-12-20 March 3/84</u>	<u>March 3.10-26 April 7 24/84</u>	<u>Feb'y 12/84</u>

SKETCHES OF FRAMES SHEWING POSITION AND DESCRIPTION OF WELDS OF FORGINGS, OR PARTICULARS OF TESTS APPLIED TO CASTINGS.

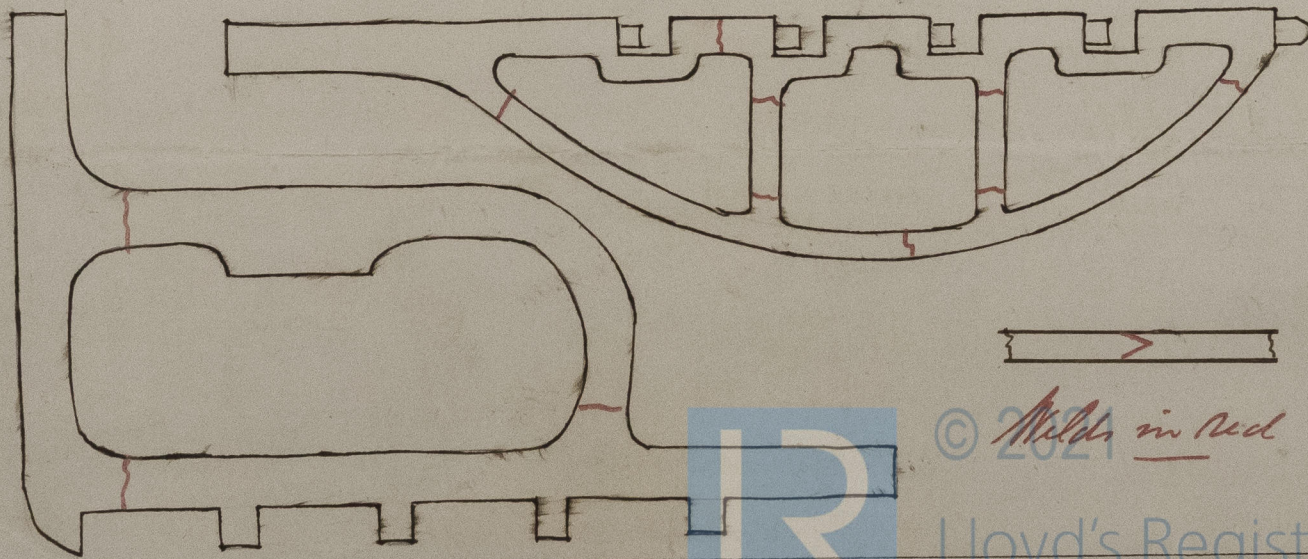

© 2021 Welds in Red

Lloyd's Register
Foundation

NWC 791-0102

Palmer's No. 538
S.S. "Gledenslie"
Nwc. Report No. 14675-



© 2021

Lloyd's Register
Foundation