


Dr. to have
41 3/184
February 23/18

Scale $\frac{1}{4}$ " = One foot

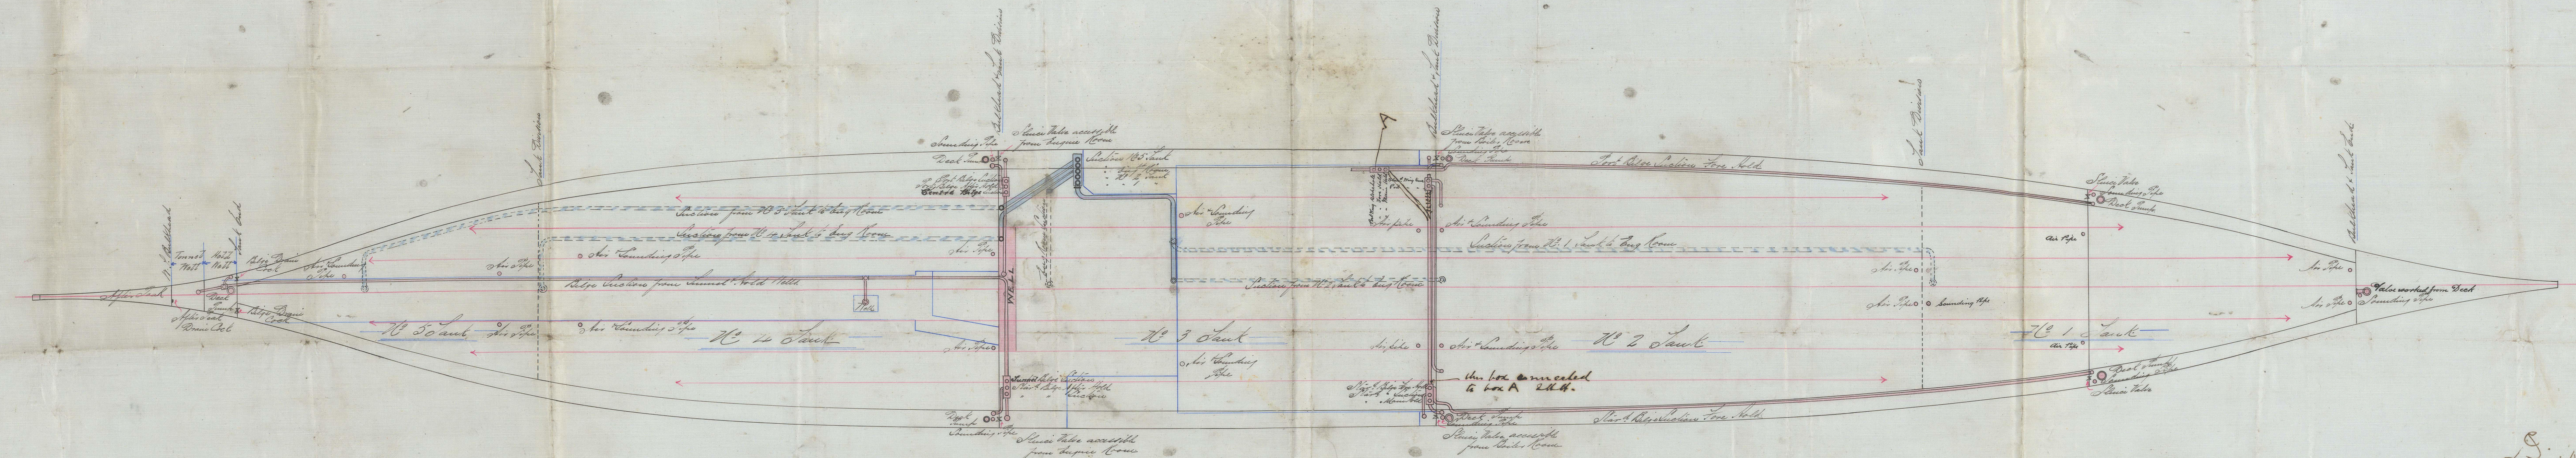

D. J.
4/3/84

Pipe arrangement no 538
for Mr Hecker

Wm. A. H.
18



© 2021

Lloyd's Register
Foundation

NWC791-0105