
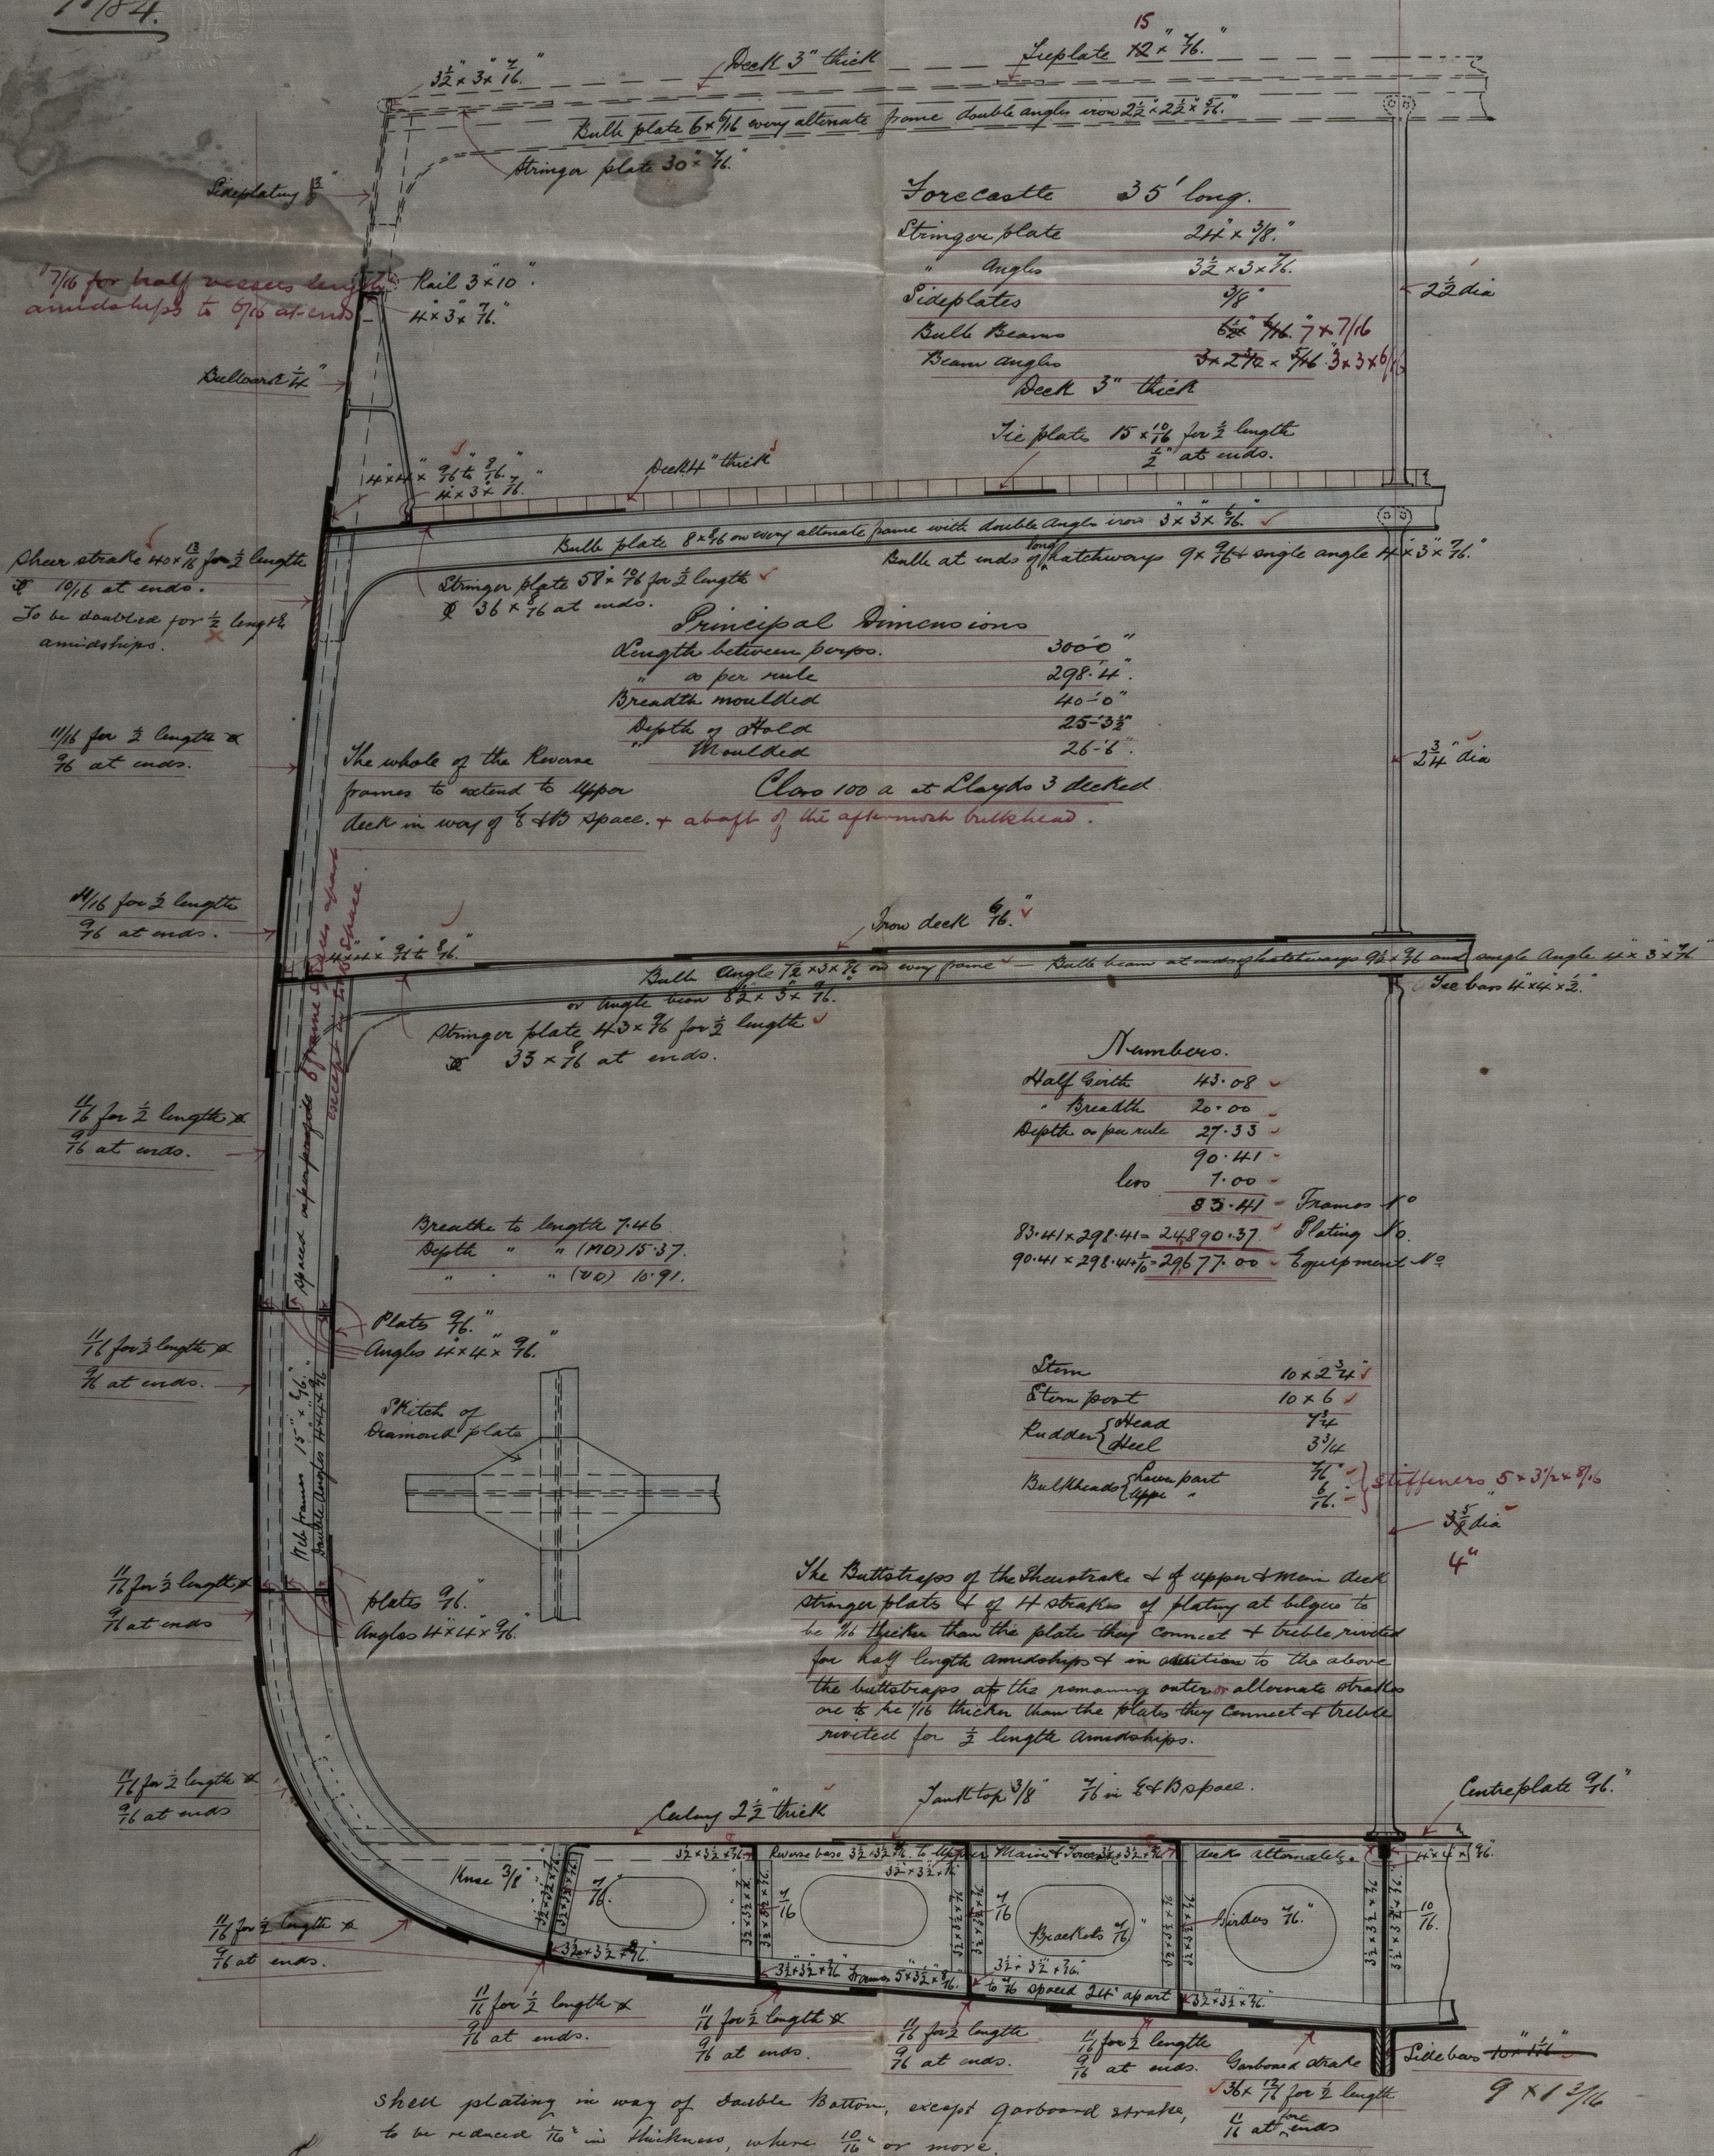


Midship Section S.S. No. 538.

Scale $\frac{1}{2}$ " = One Foot.

Dr. & No.
12/1/84.

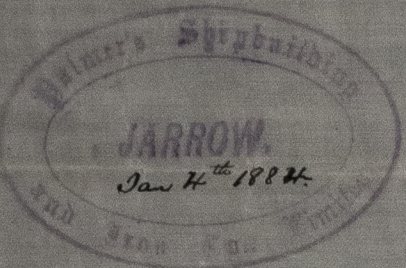

11/1/84