


S.S. "Sagami Maru" Newcastle Report No 14424  
Nwc. Freeboard Report No. 14688  
LONGITUDINAL SECTION ETC FOR A SPAR DECKED STEAMER

SCALE 1/8" INCH TO A FOOT

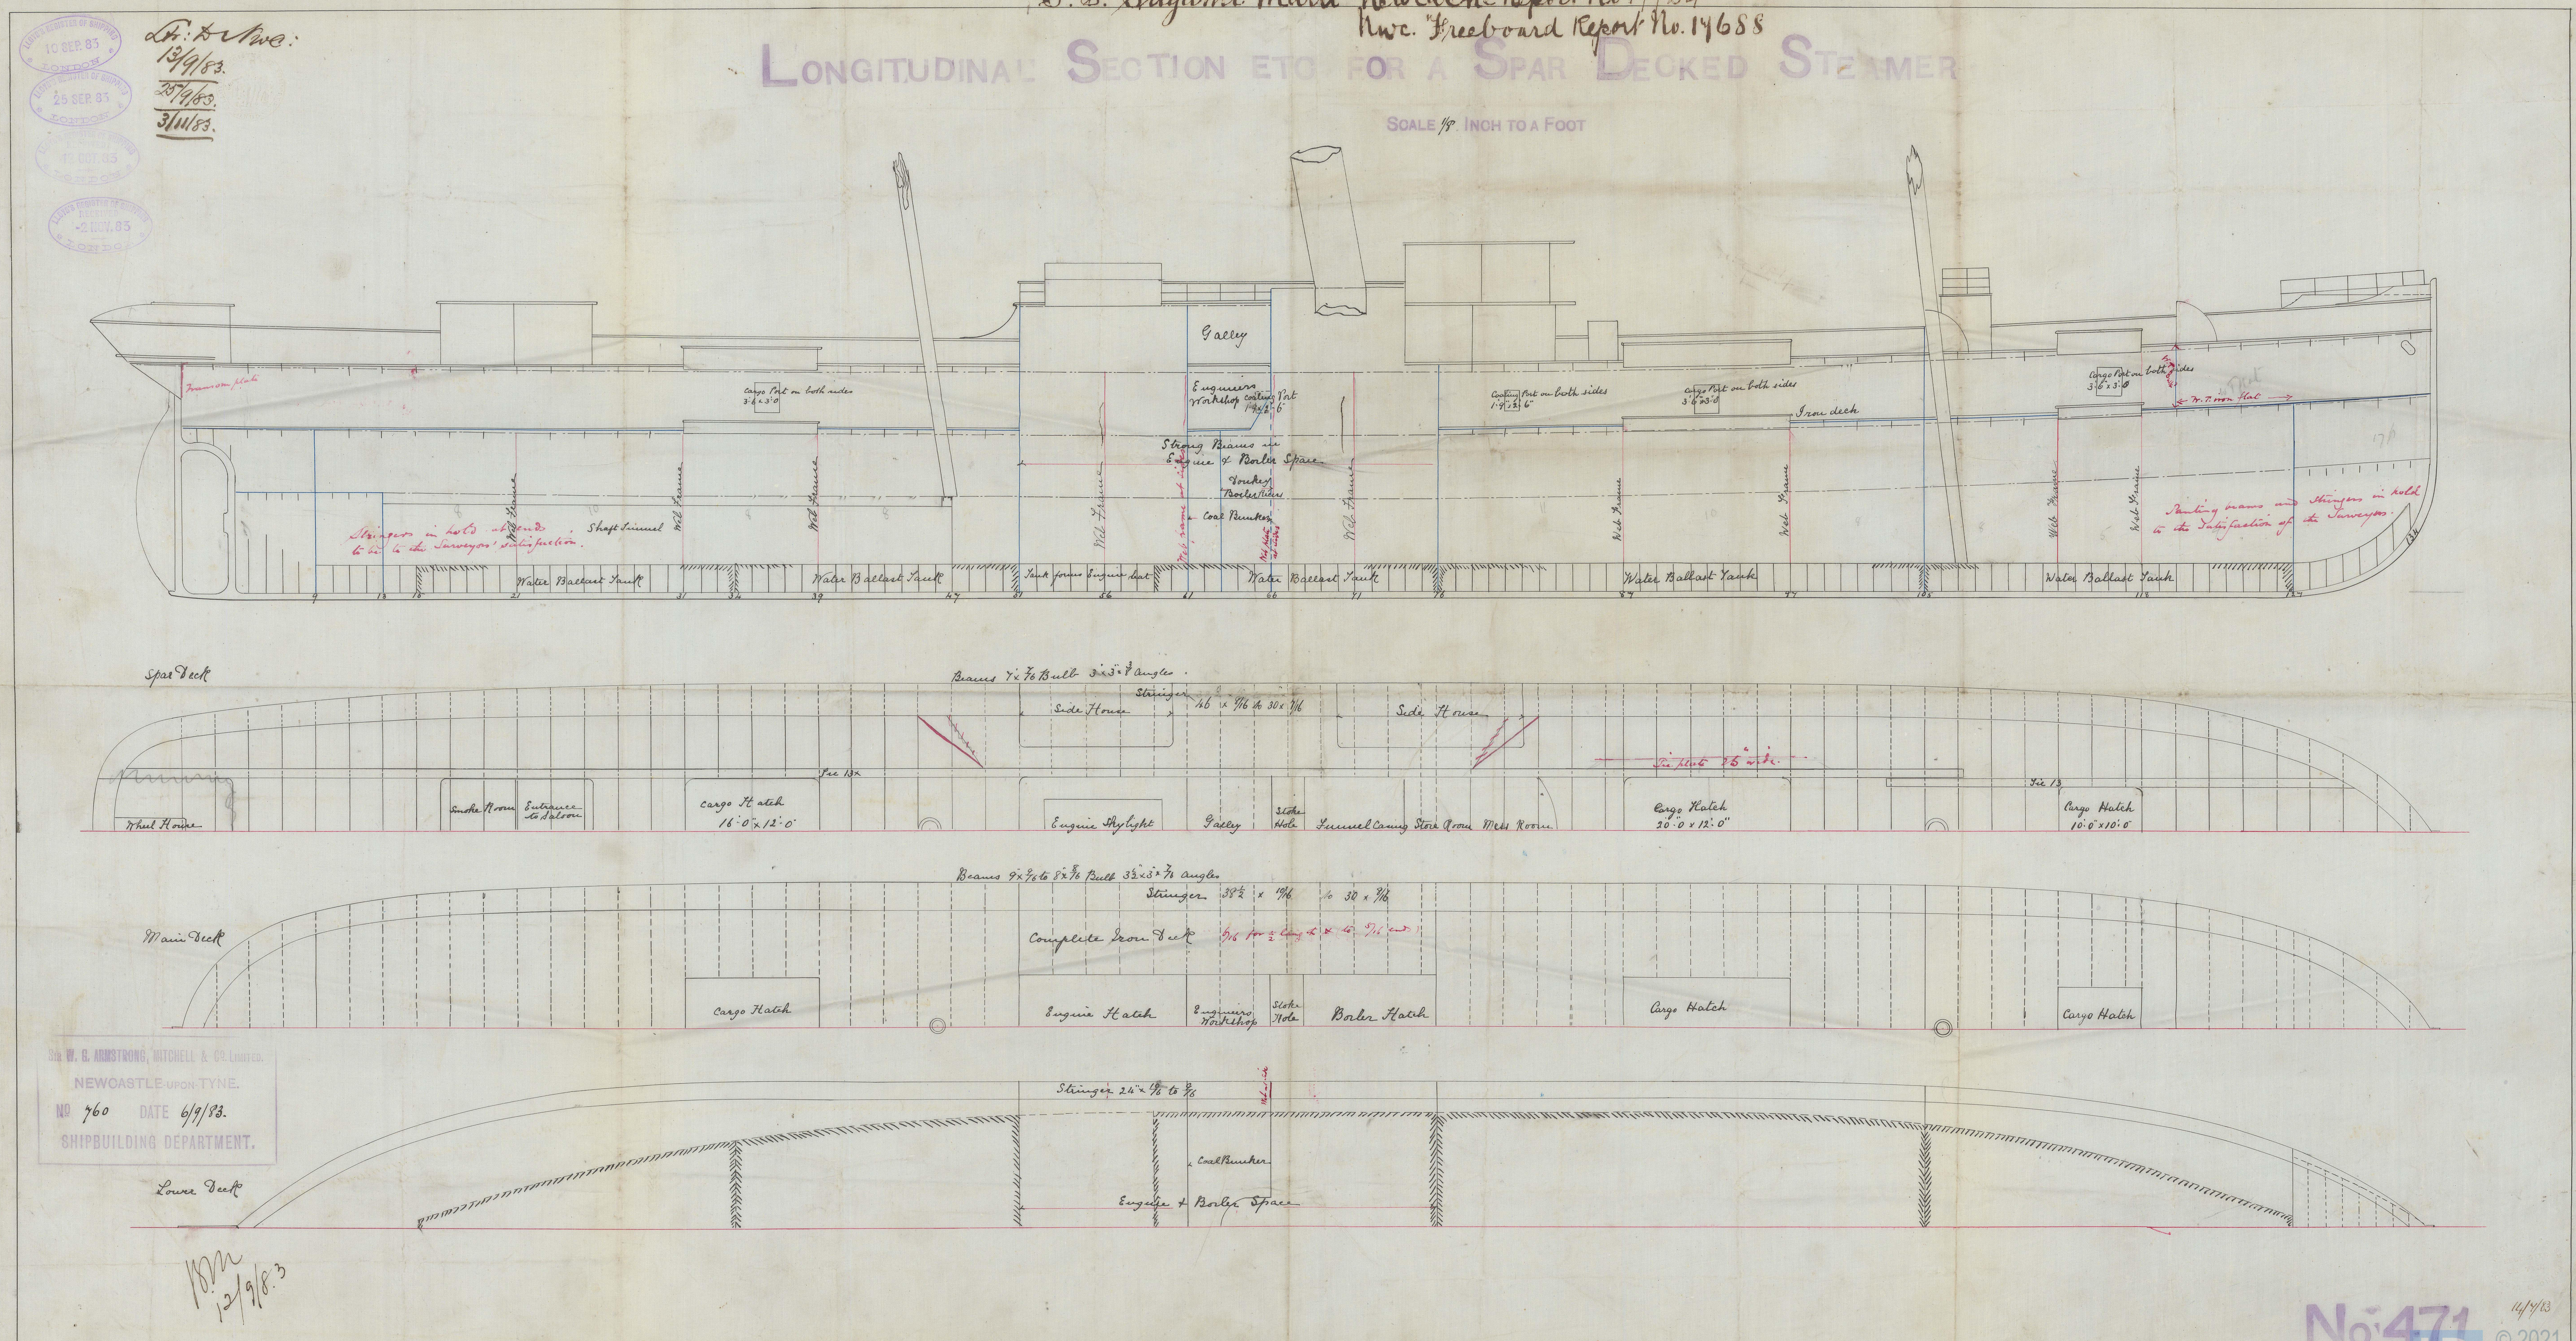

W. G. ARMSTRONG, MITCHELL & CO. LIMITED.  
NEWCASTLE-UPON-TYNE.  
No 760 DATE 6/9/83.  
SHIPBUILDING DEPARTMENT.