

## Lloyd's Register of British and Foreign Shipping.

(Report on Vessel No. \_\_\_\_\_ Port \_\_\_\_\_)

No. 549

## SHIP FORGINGS OR CASTINGS.

I have to report that the undermentioned Iron or ~~Steel~~ Forgings or Castings, manufactured by

*Messrs The Elswick Forge Co. Newcastle*  
 for the Vessel No. *471*, being built by *Messrs J. & G. Armstrong Mitchell & Co.*  
 of *Newcastle* have been inspected by me as set forth below, and found  
 to be, so far as can be seen, *sound and efficient.*

Mark on Forgings.

Lloyd's


No. 549

N.C.

*H. Cameron,**Sunderland.*

	STERN FRAME.	RUDDER FRAME.	STEM.
Material* - - - -	<i>Scrap Iron</i>	<i>Scrap Iron</i>	<i>Scrap Iron</i>
How made - - - -	<i>Forged</i>	<i>Forged</i>	<i>Forged</i>
Dimensions - - - -	<i>9' x 5"</i>	<i>6 1/4" x 3 1/4"</i>	<i>9' x 2 1/2"</i>
Progress on Inspection -	<i>Finished</i>	<i>Forged and smithed</i>	<i>Forged</i>
Dates when Inspected {	<i>Oct 10/83</i>	<i>Jan 30 Feb 11-19-23/84</i>	<i>Nov 30/83</i>

SKETCHES OF FRAMES SHEWING POSITION AND DESCRIPTION OF WELDS OF FORGINGS, OR PARTICULARS OF TESTS APPLIED TO CASTINGS.

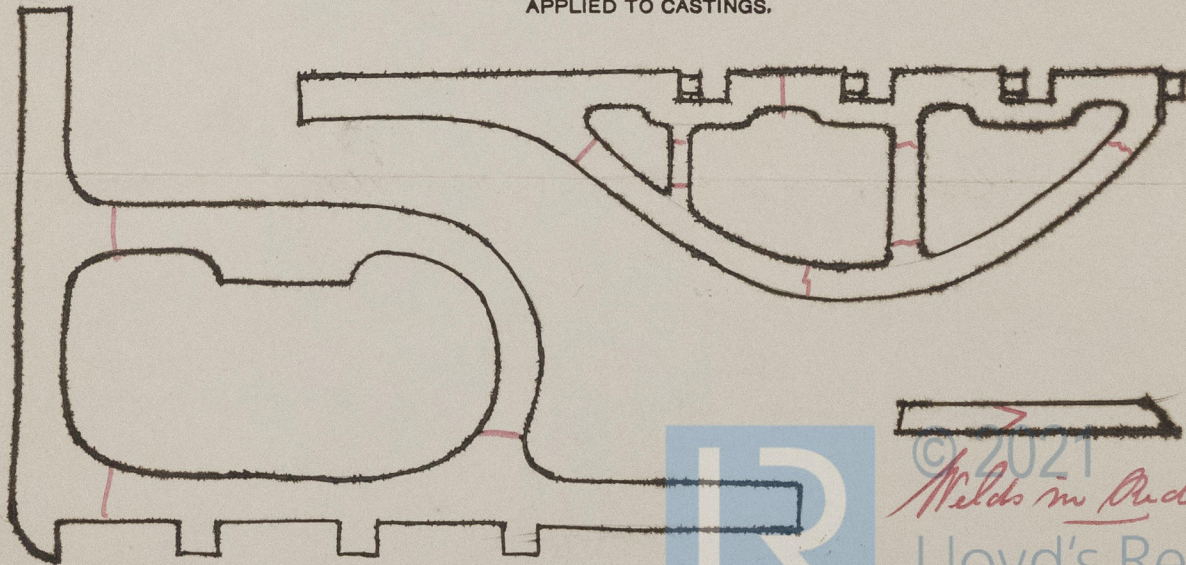



Amehong Mitchell & Co  
No. 471.  
S. S. "Sagami Maru"  
Ave. Report No. 14424



© 2021

Lloyd's Register  
Foundation