


MIDSHIP SECTION OF SAILING SHIP N^o 542

SCALE $\frac{1}{2}'' = 1 \text{ FOOT}$.

Ltr. to Mac:
 16/5/84.

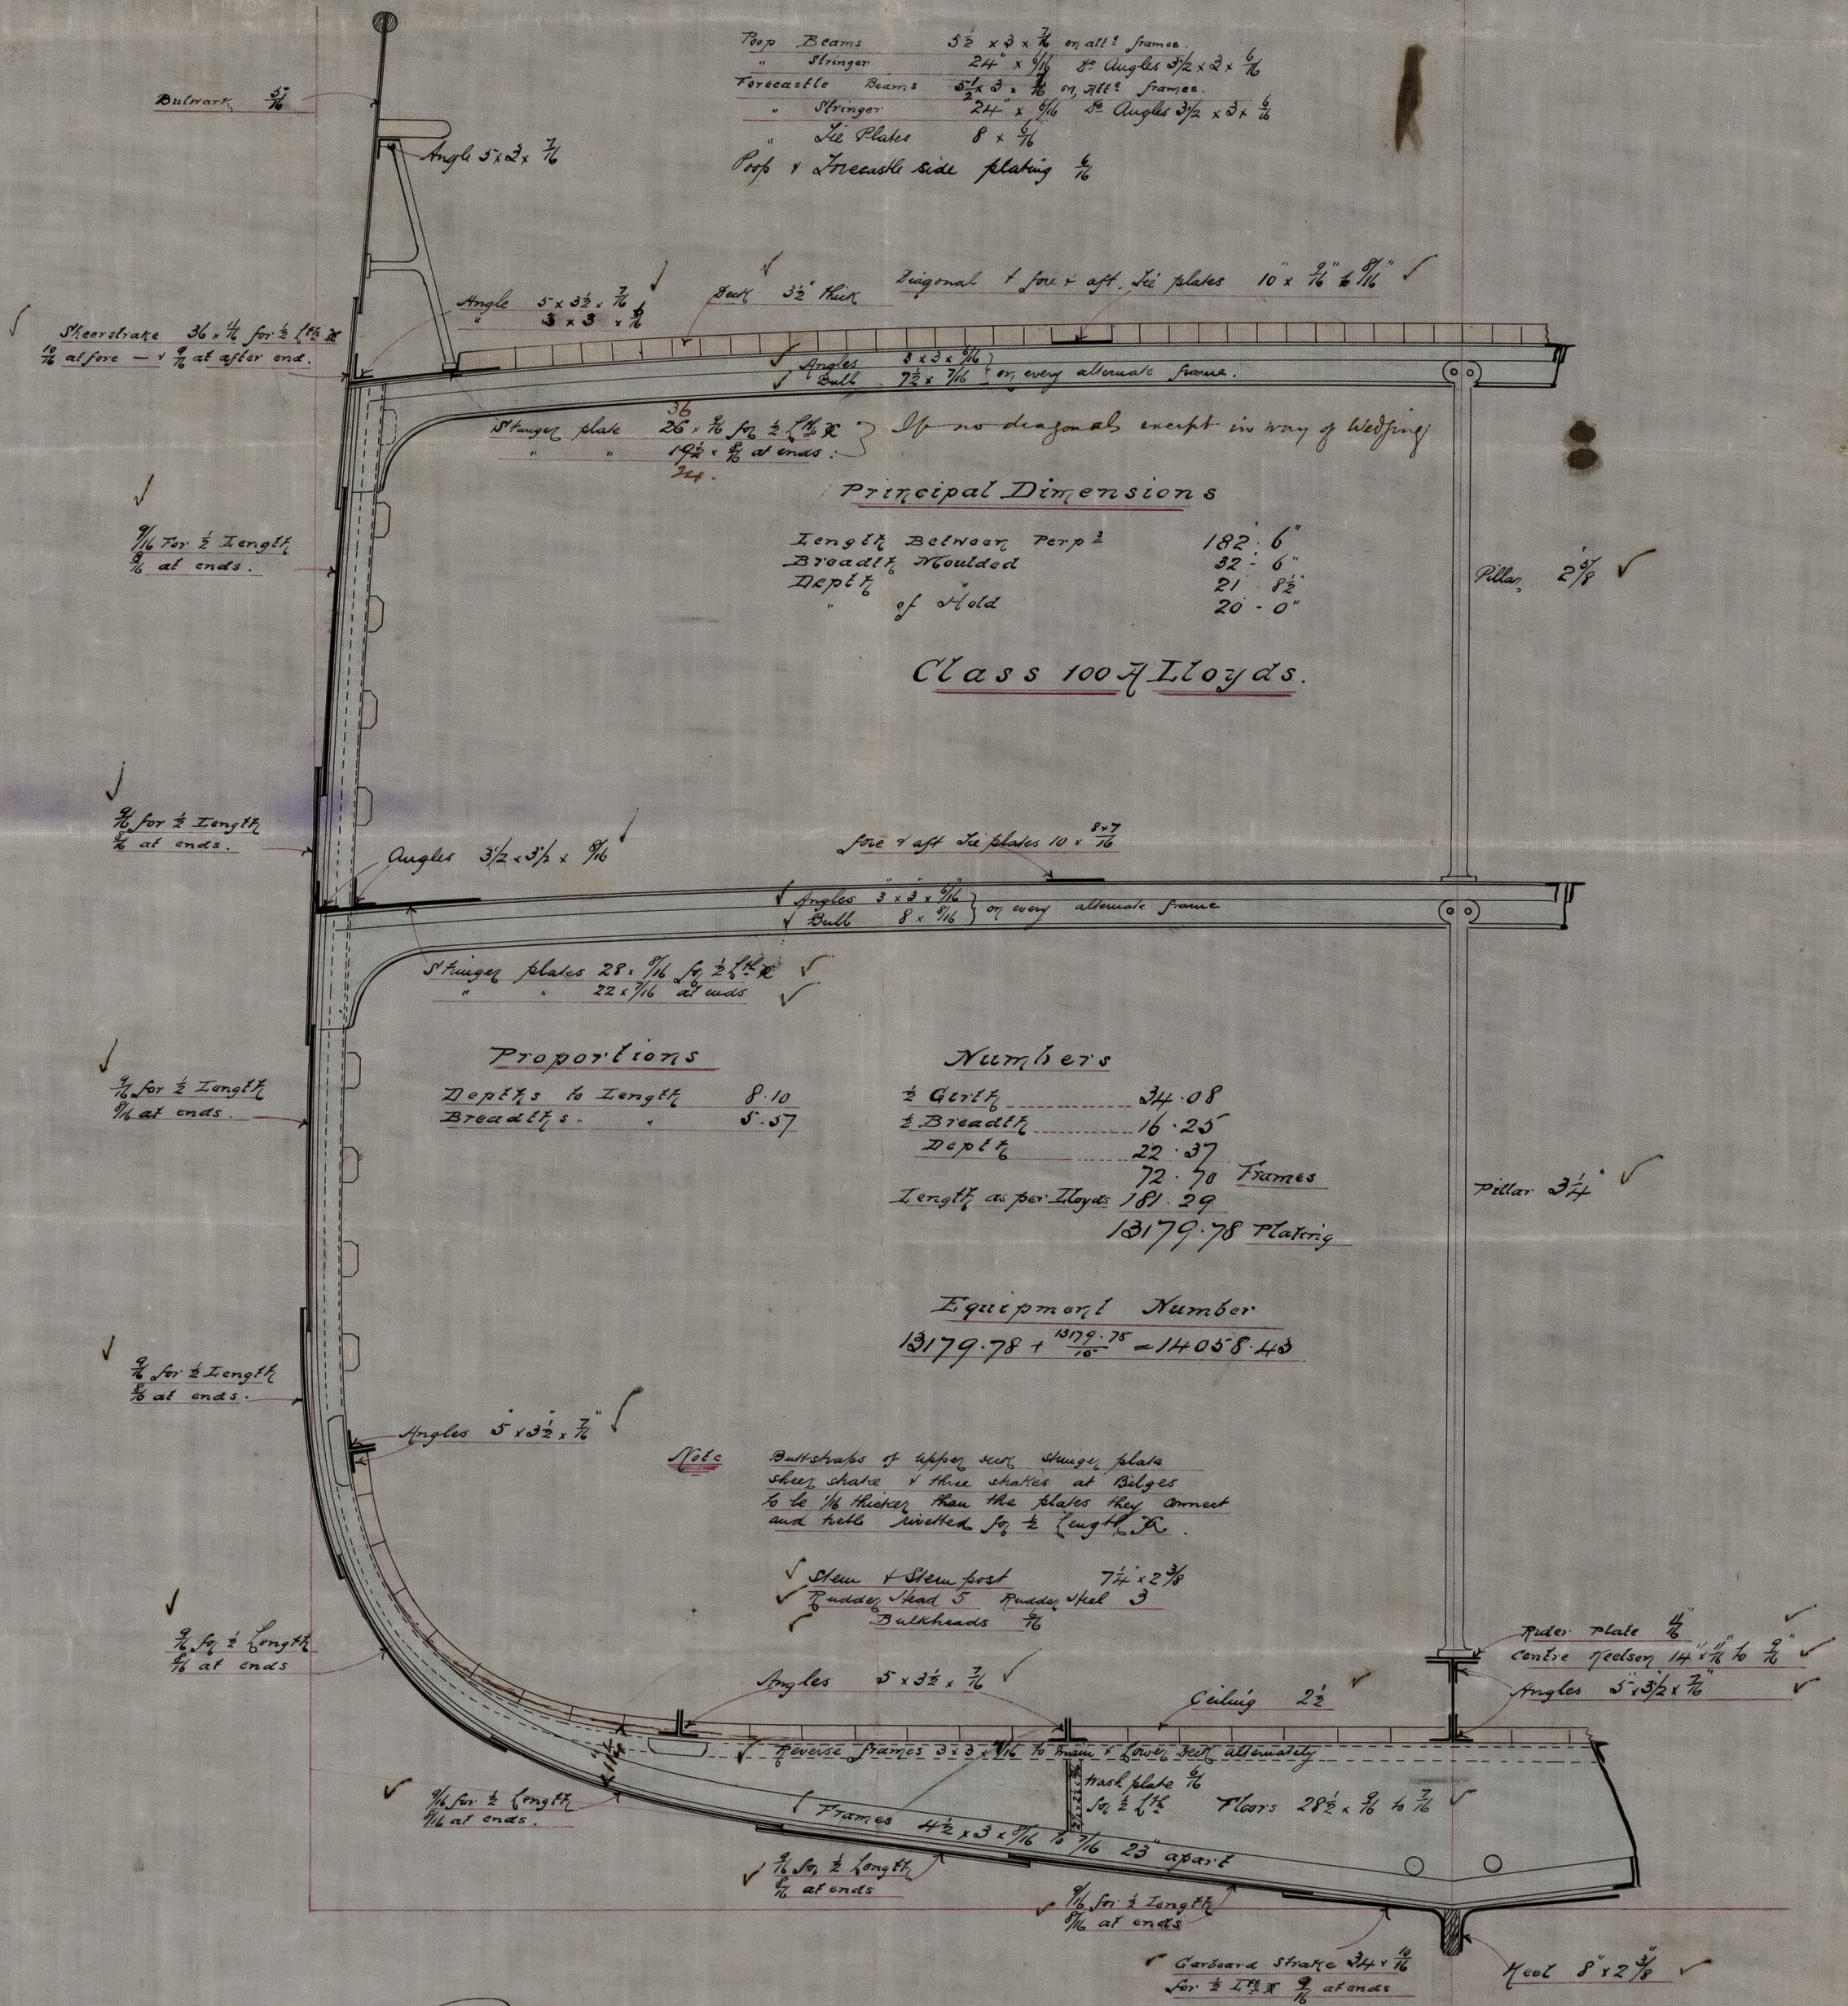

165784