

# Lloyd's Register of British and Foreign Shipping.

(Report on Vessel No. \_\_\_\_\_ Port \_\_\_\_\_)

No. 106 a

## SHIP FORGINGS OR CASTINGS.

I have to report that the undermentioned Iron or Steel Forgings or Castings, manufactured by

*The Palmes S. B. Co.* of *Janou*

for the Vessel No. *542*, being built by *The Palmes S. B. Co.*

of *Janou* have been inspected by me as set forth below, and found to be, so far as can be seen, *sound and efficient.*

The words FORGINGS or CASTINGS, IRON or STEEL, should be struck out as may be required.

Mark on Forgings.


**Lloyd's**  
No. 106 a  
*J.B.C.*

*J.B. Cameron*

*Sunderland*

	STERN FRAME. <i>Port</i>	RUDDER FRAME.	STEM.
Material* - - - -	<i>Scrap iron</i>	<i>Scrap iron</i>	<i>Scrap iron</i>
How made - - - -	<i>Forged</i>	<i>Forged</i>	<i>Forged</i>
Dimensions - - - -	<i>8" x 2 3/8"</i>	<i>5" x 3"</i>	<i>7 1/2" x 2 3/8"</i>
Progress on Inspection -	<i>Finished</i>	<i>Forged &amp; mitted</i>	<i>Finished</i>
Dates when Inspected	<i>June 23/84</i>	<i>July 25-28 Aug 7-12 28 Sept 2/84</i>	<i>June 23/84</i>

SKETCHES OF FRAMES SHEWING POSITION AND DESCRIPTION OF WELDS OF FORGINGS, OR PARTICULARS OF TESTS APPLIED TO CASTINGS.

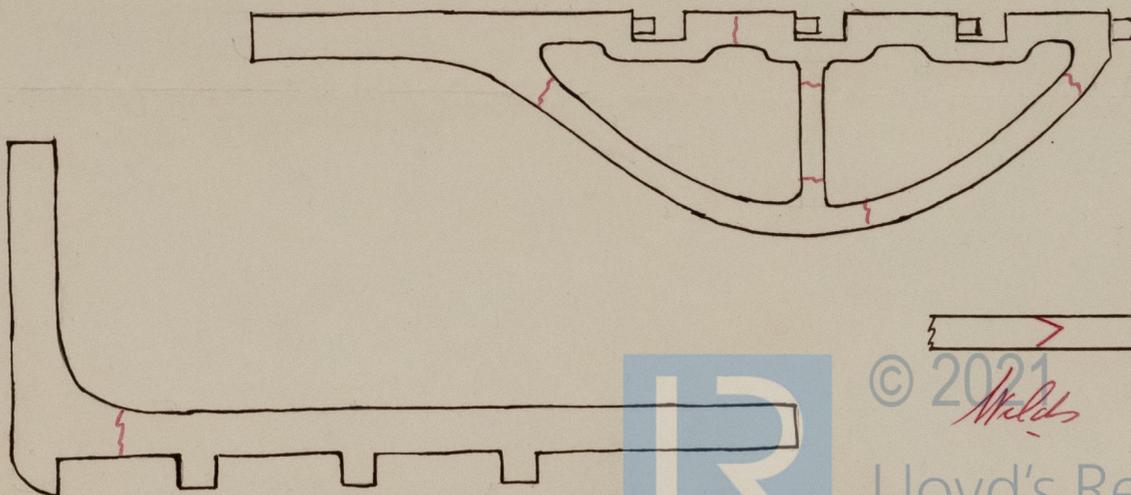


© 2021  
*Welds*  
Lloyd's Register  
Foundation  
NWC792-0077


\* If of Iron, state whether scrap or puddled iron.

Palmer No. 542  
Br. "Scotsman"  
NWC Report No. 17896

SHIP FORGING OR CASTING

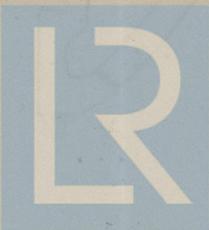

© 2021  
Lloyd's Register  
Foundation

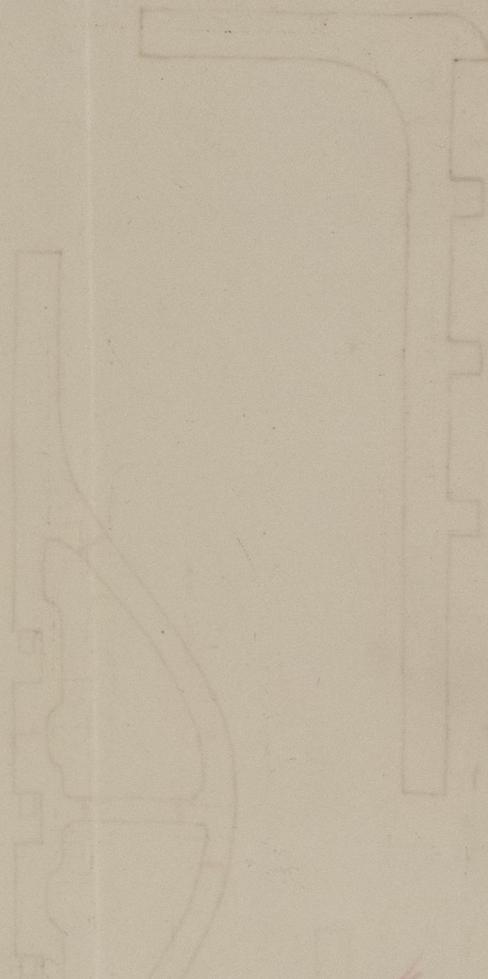

SHIP FORGING OR CASTING