


A circular postmark from London, dated 15 MAR 84, with a handwritten '84' and a large 'X' drawn over it.

Scale $\frac{1}{8}$ inch per foot

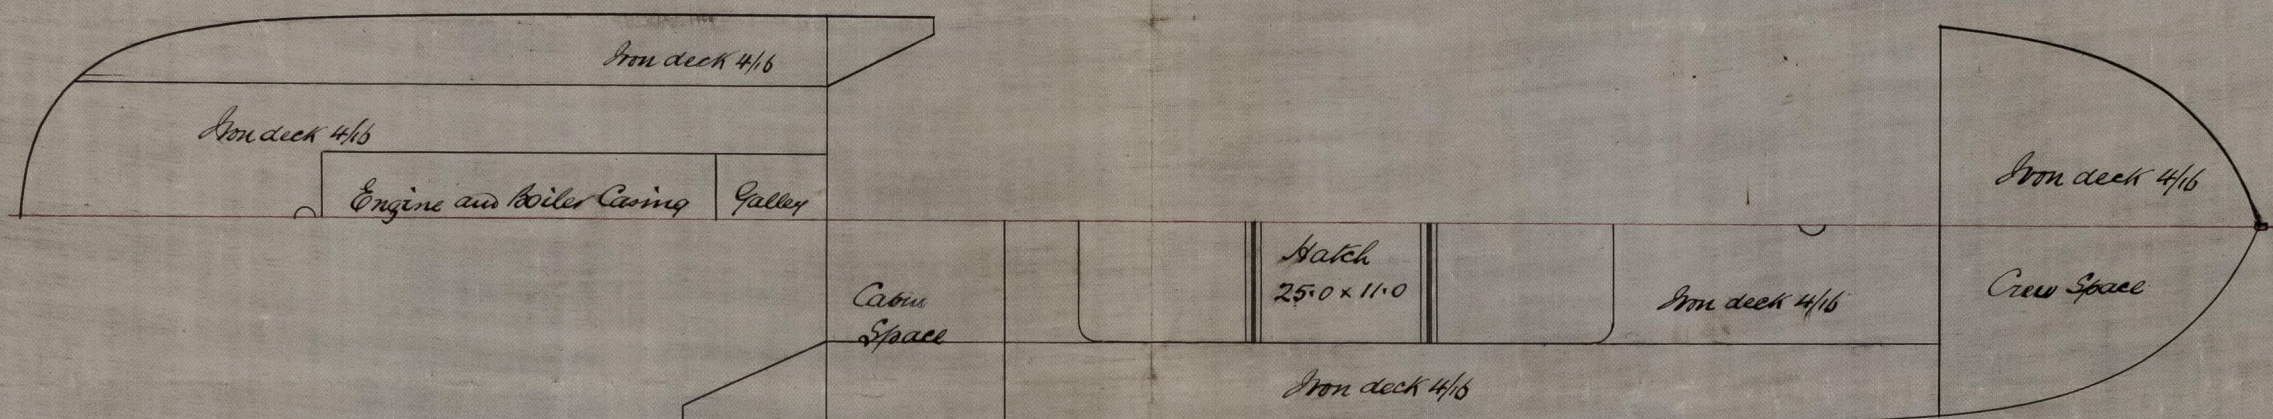


Profile, Deck plan and Midship Section SS No 90
To Class 100 A Lloyds

Ltr. to Mrs. 15³/₄ 184.
 15³/₄ 184.

| | |
|--------------------|------------|
| Half Girth | 17.5 |
| " Breadth | 9.5 |
| Depth | 9.8 |
| | <hr/> 36.8 |
| Length as per Rule | <hr/> 100 |
| | 36.800 |

Depth to length 10.2
Breadth " 5.2

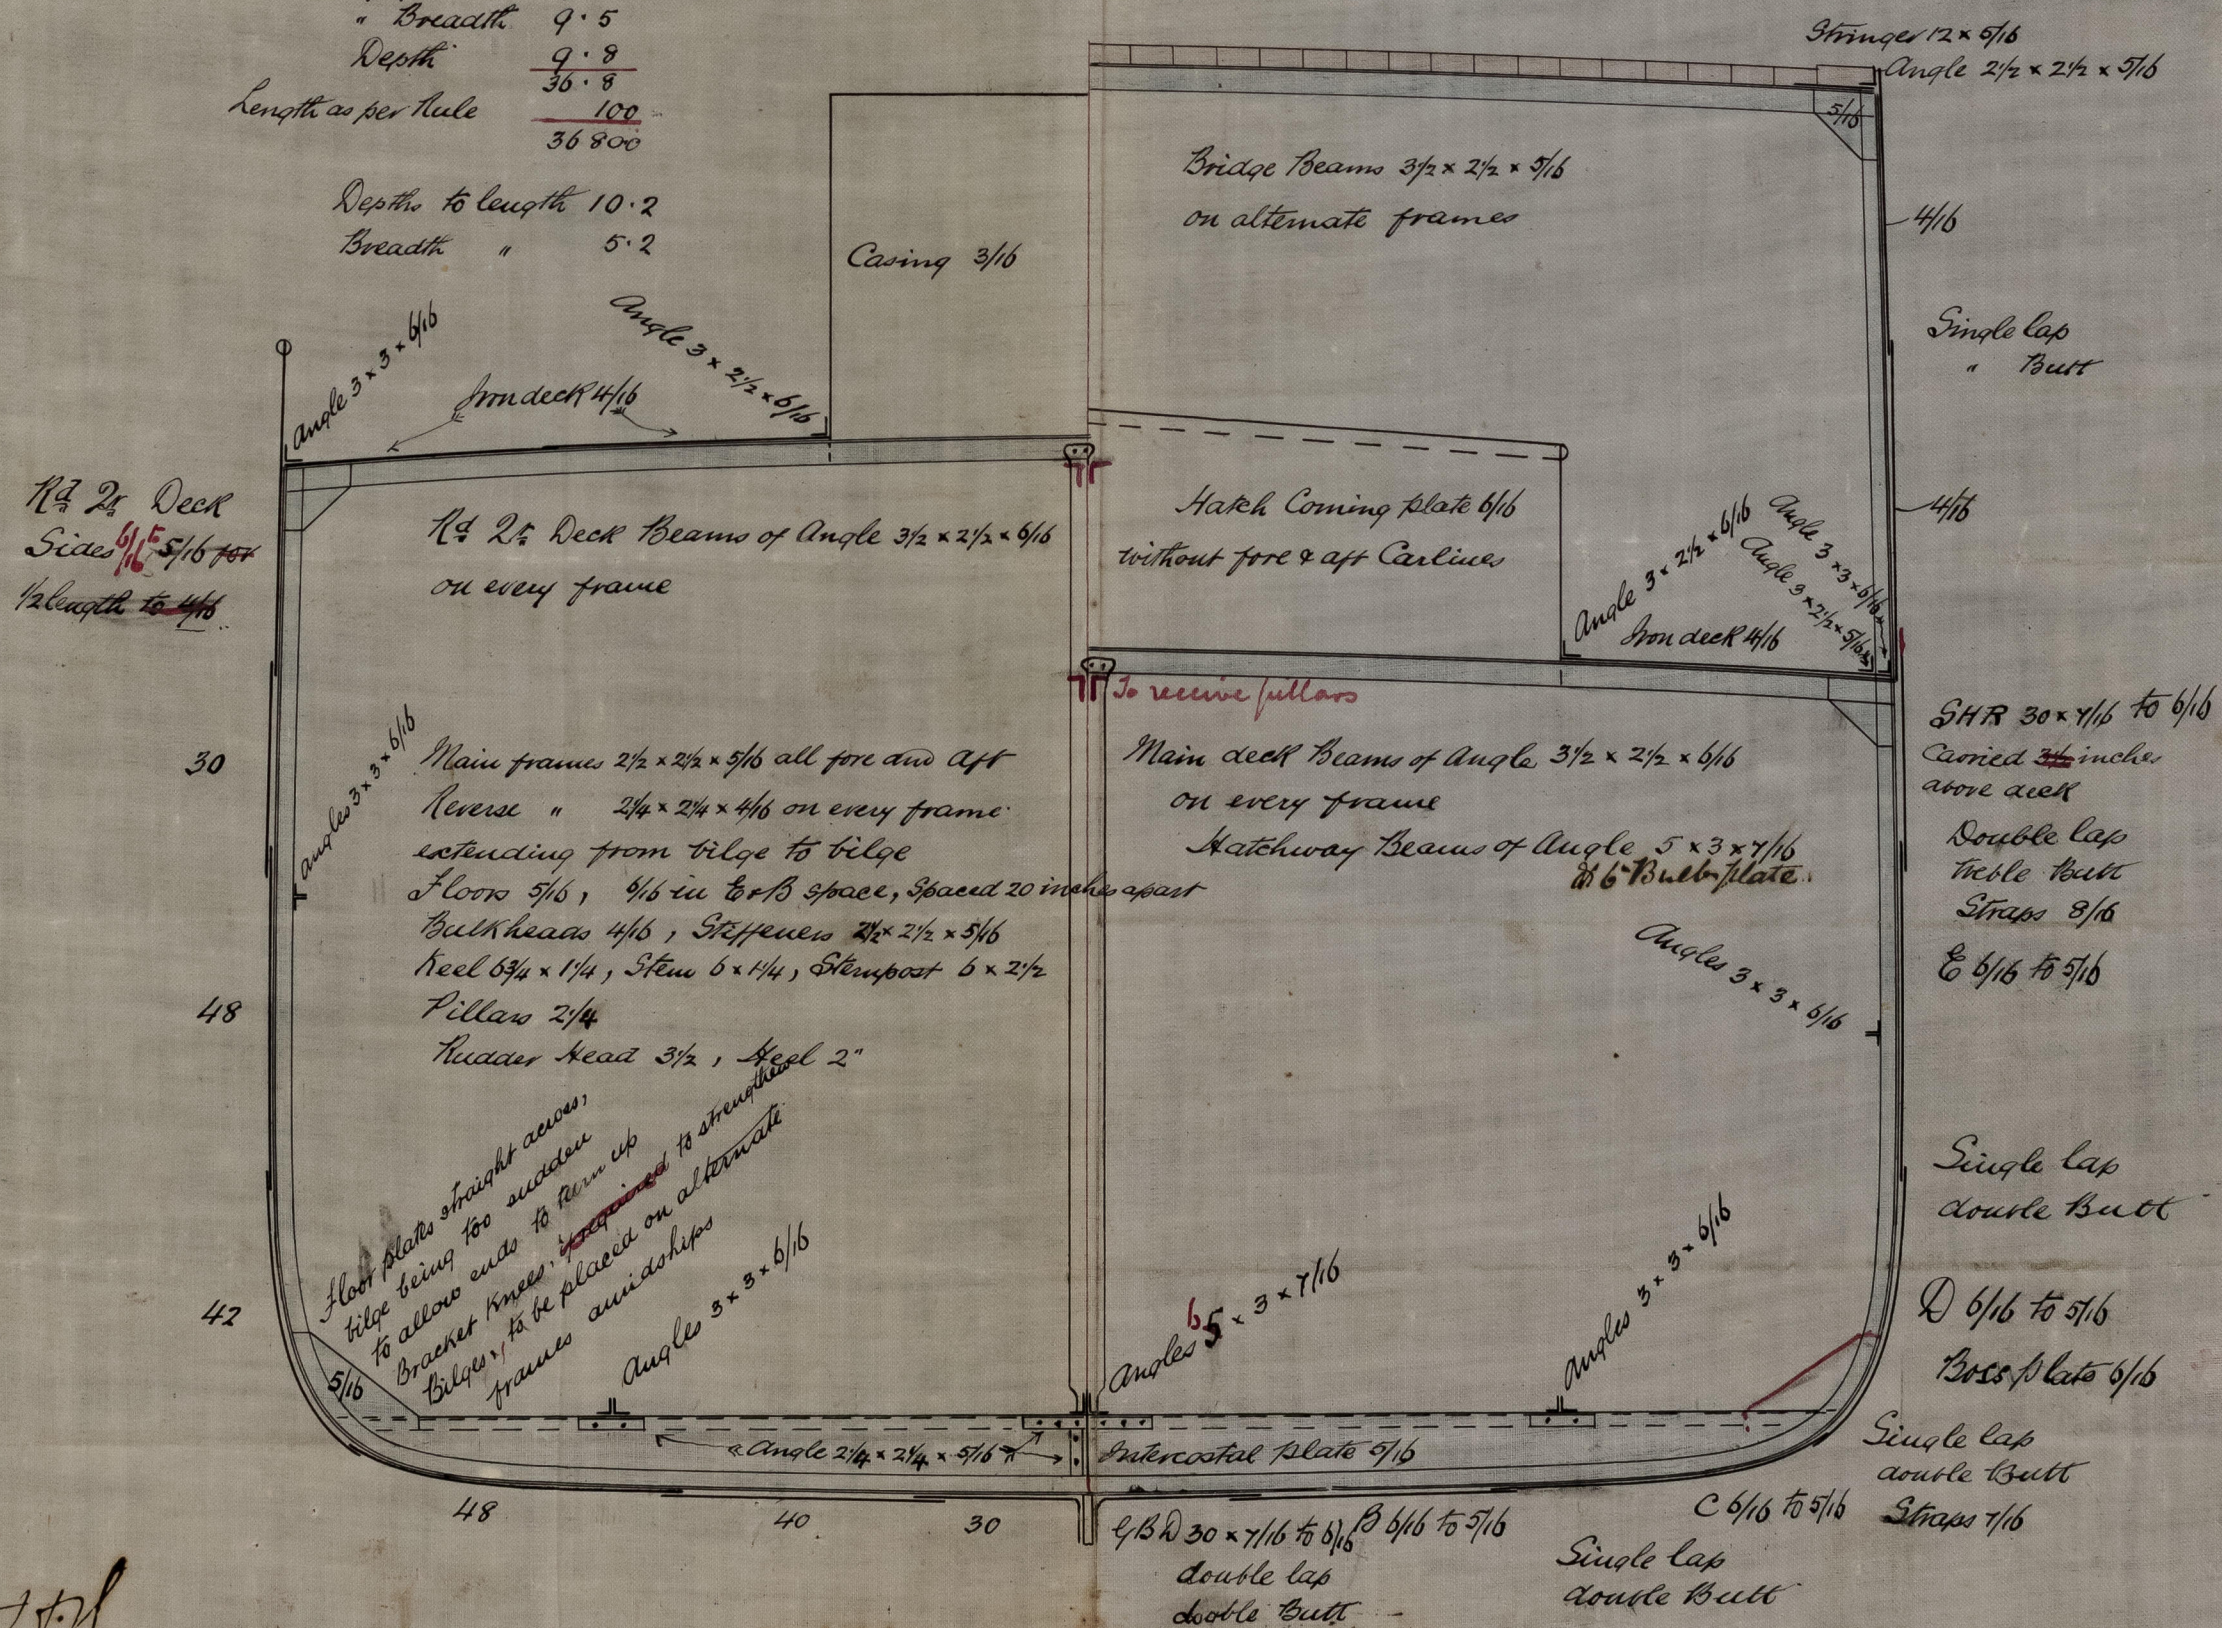

Scale $\frac{1}{2}$ inch per foot

J. V. N.
15/3/84