

The words FORGINGS or CASTINGS, IRON or STEEL, should be struck out as may be required.

Received at

Office,

18

# Lloyd's Register of British and Foreign Shipping.

(Report on Vessel No. \_\_\_\_\_ Port \_\_\_\_\_)

No. *130A*

## SHIP FORGINGS OR CASTINGS.

I have to report that the undermentioned Iron ~~or Steel~~ Forgings ~~or Castings~~, manufactured by

*The Palmers S.B. Co.*

of *London*

for the Vessel No. *546*, being built by

*them*

of \_\_\_\_\_ have been inspected by me as set forth below, and found

to be, so far as can be seen, *sound and efficient*

Mark on Forgings.

Lloyd's

No. *130A*


*S.B. Co.*

*M. Cameron.*

*London.*

	STERN FRAME.	RUDDER FRAME.	STEM.
Material* - - - -	<i>Scrap Iron</i>	<i>Scrap Iron</i>	<i>Scrap Iron</i>
How made - - - -	<i>Forged</i>	<i>Forged</i>	<i>Forged</i>
Dimensions - - - -	<i>7 1/2" x 4 3/4"</i>	<i>5 1/2" - 3"</i>	<i>7 1/2" x 2 3/8"</i>
Progress on Inspection -	<i>Forged &amp; Smithed</i>	<i>Smithed</i>	<i>Forged &amp; Smithed</i>
Dates when Inspected	<i>Aug 28 Sept 29 17/84</i>	<i>Oct 4 22-24/84</i>	<i>Aug 28 Sept 9/84</i>

SKETCHES OF FRAMES SHEWING POSITION AND DESCRIPTION OF WELDS OF FORGINGS, OR PARTICULARS OF TESTS APPLIED TO CASTINGS.

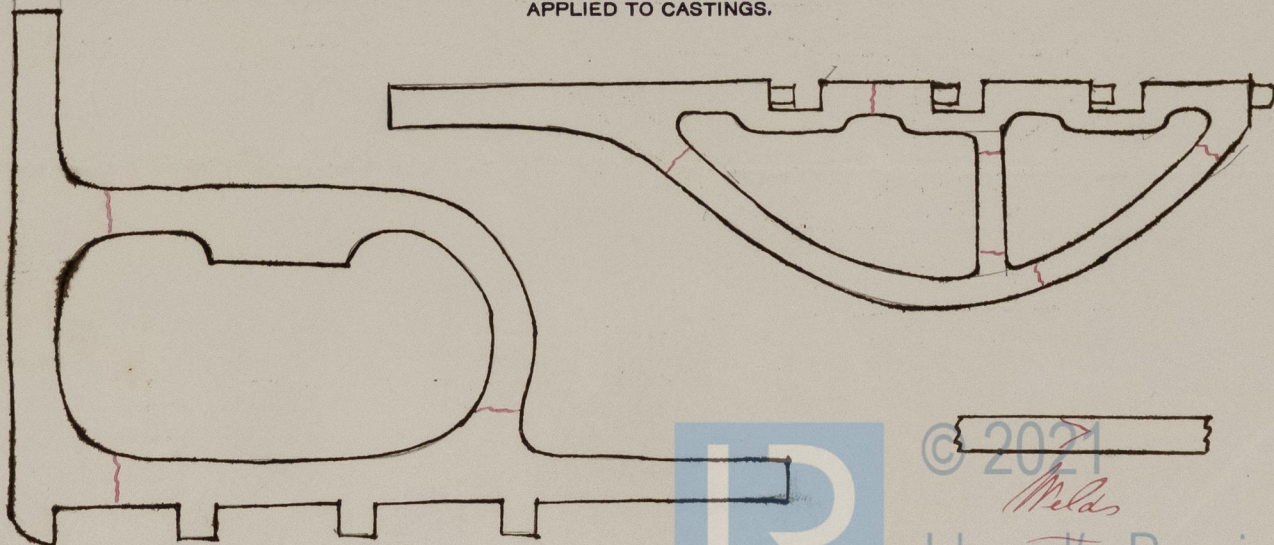



S.S. "Chelsea"  
Invc. Report No. 18054



© 2021

Lloyd's Register  
Foundation