


All Shell plates except Dome.

2. 24/10/84

S.S. "Benbigholive"
 No. Report No. 18225


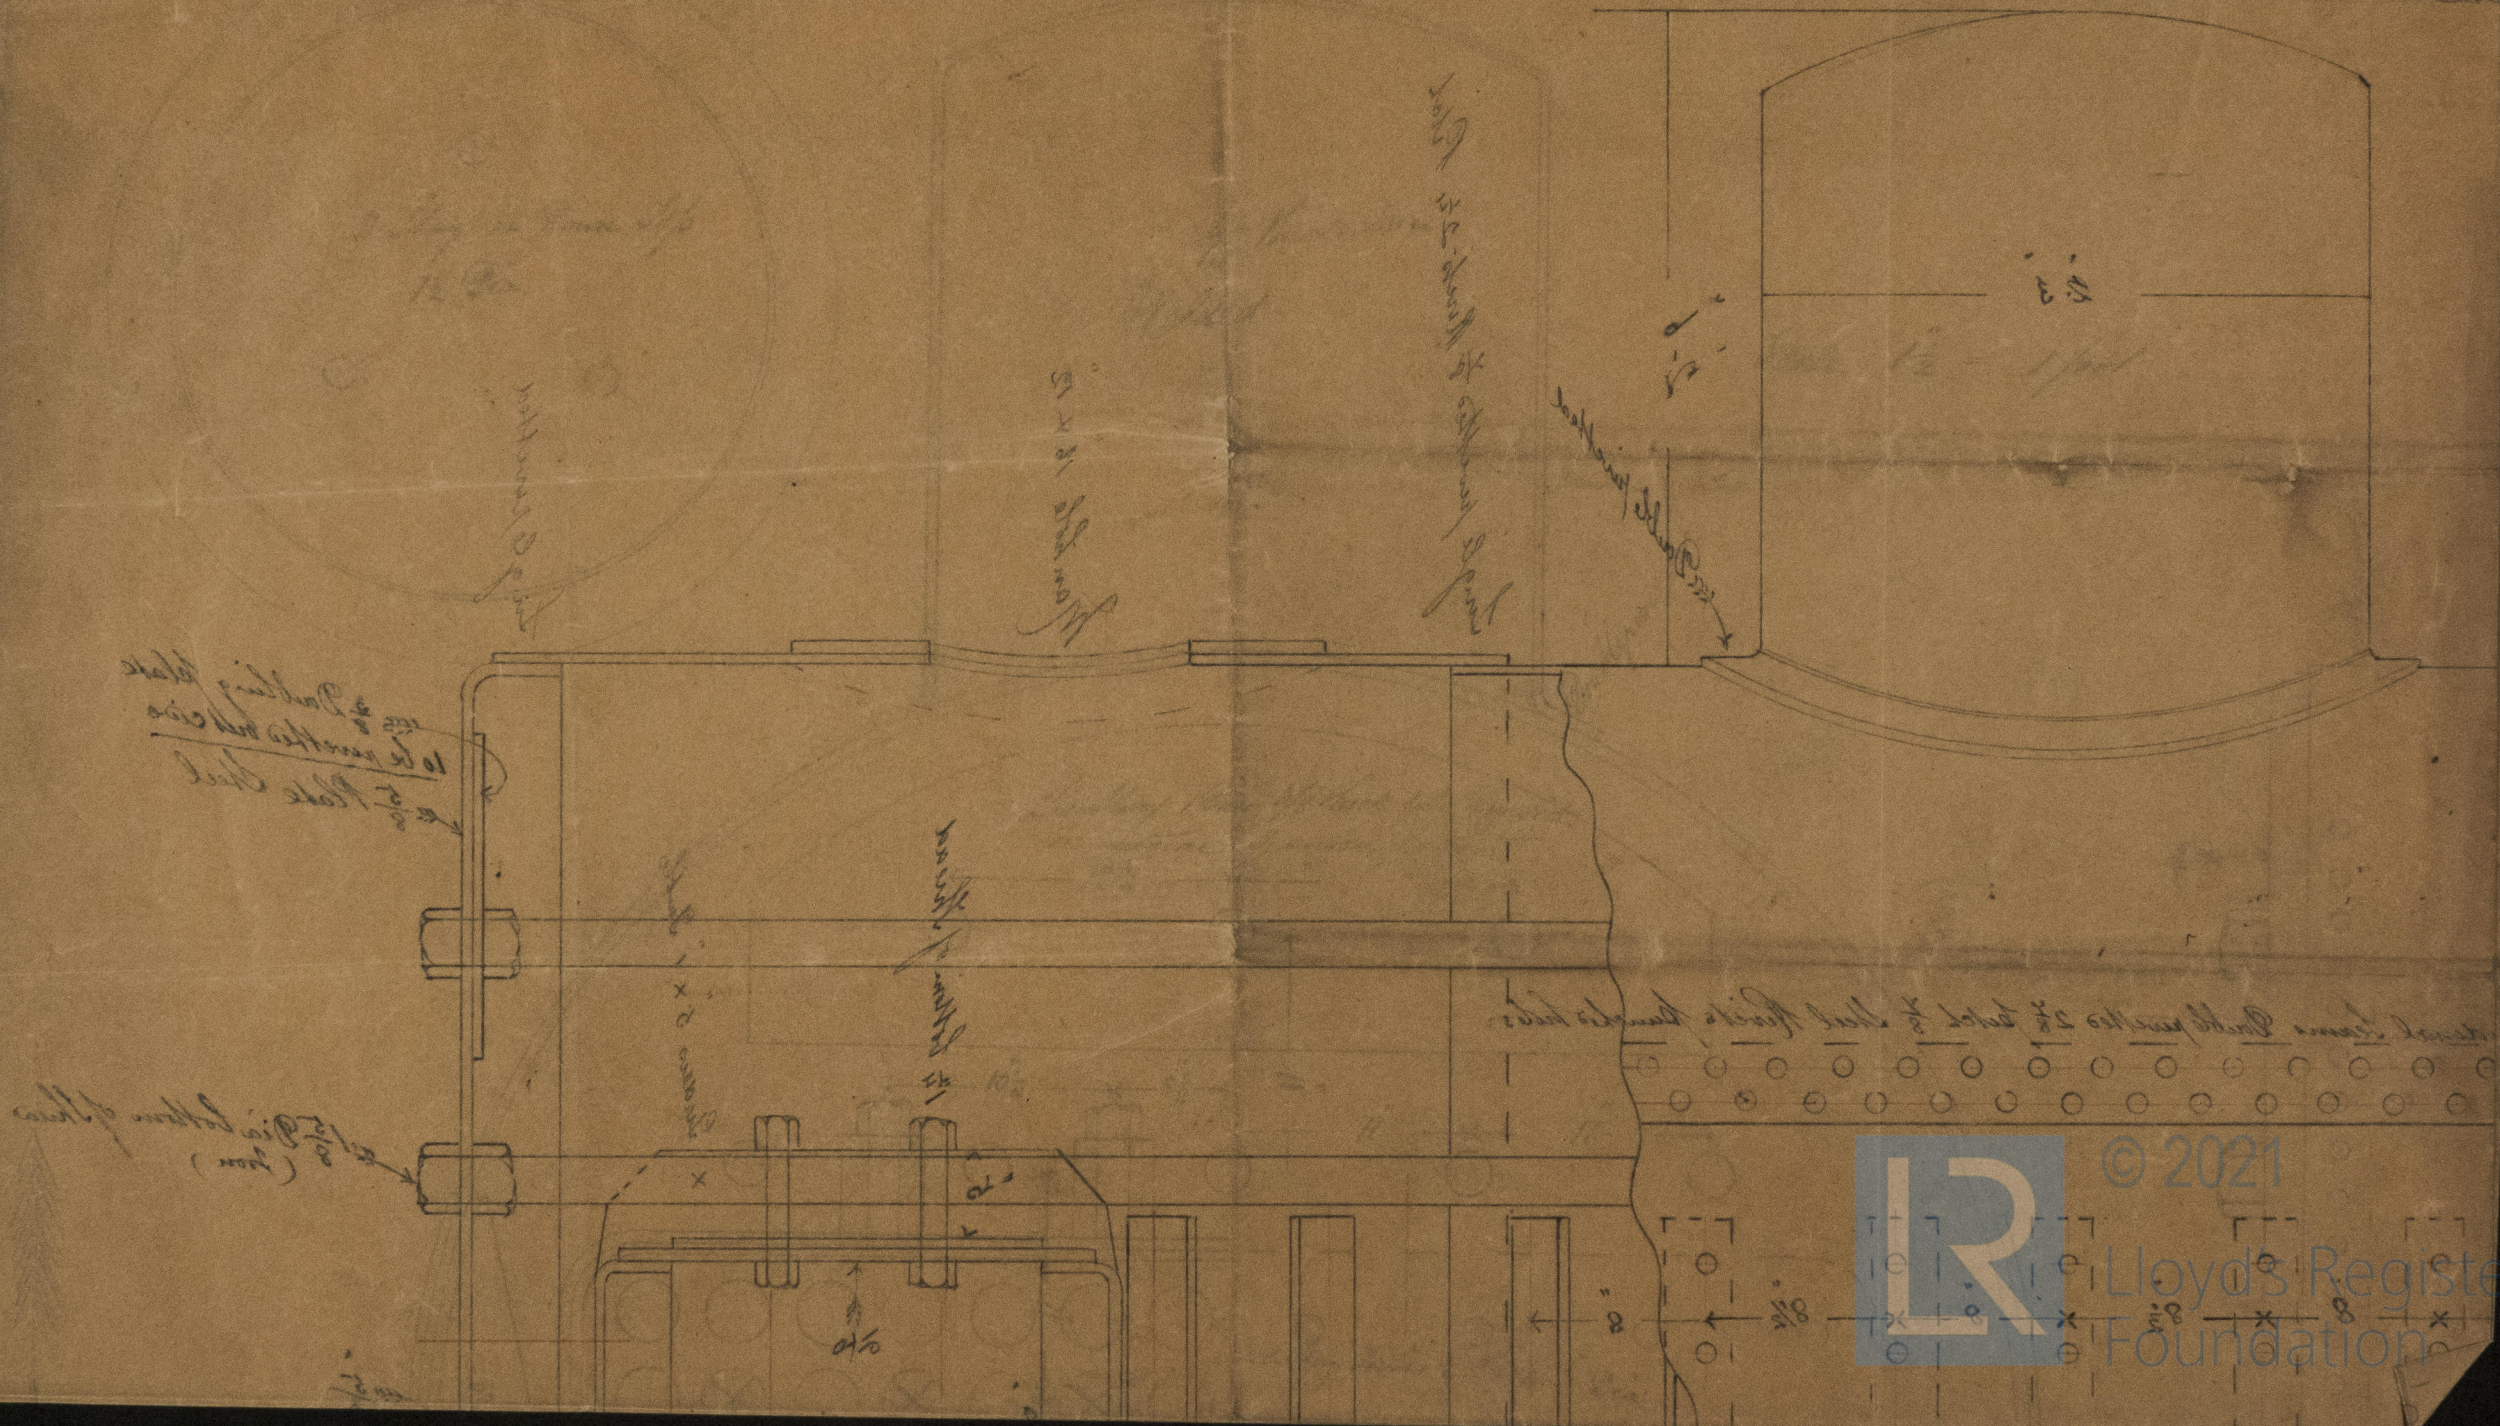

© 2021

Lloyd's Register
 Foundation