


RECEIVED
14 JAN 85
LONDON

Dr. K. Mue:
23.1.85.

S.S. "Edendale" Inc. Report No 18532

S.S. No 58
PROFILE & DECK PLAN.
SCALE 1/4" = 1 FT.

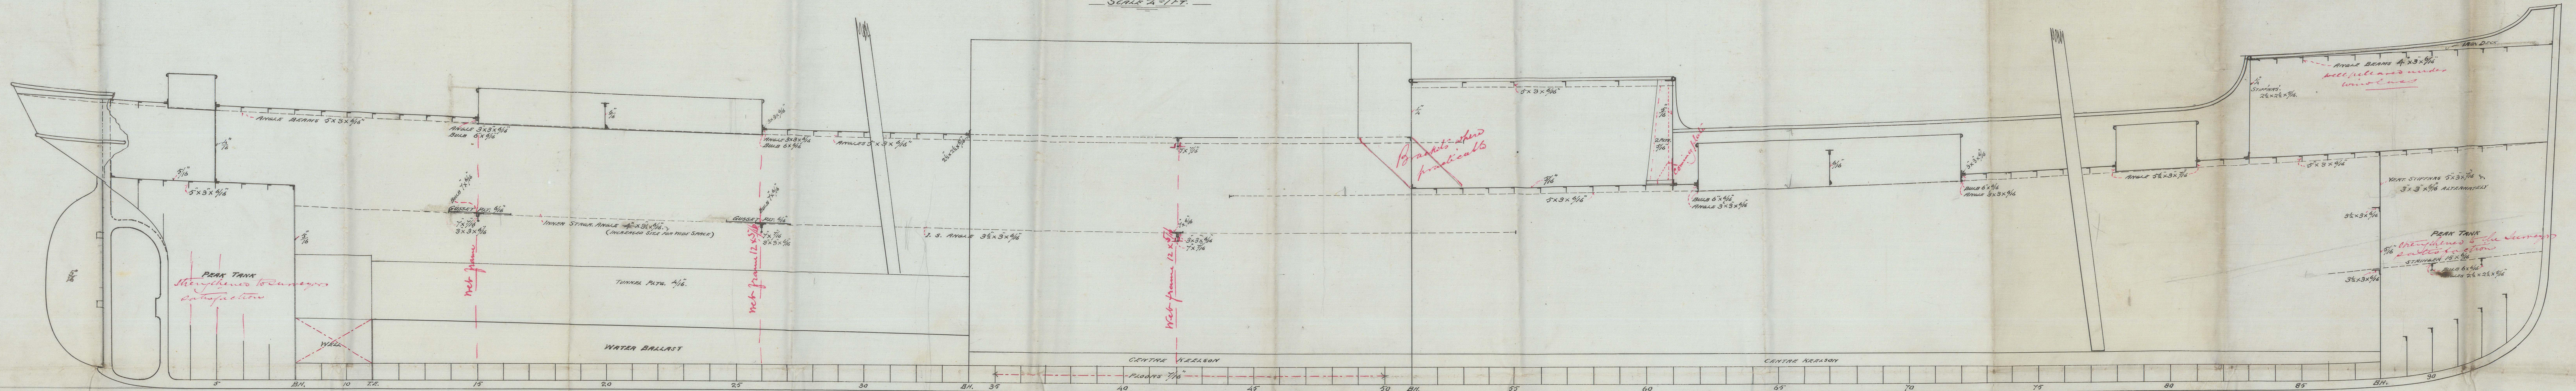

RECEIVED
14 JAN 1885
BLITH


RECEIVED
14 JAN 1885
BLITH

No 58

See letter 23/1/85

24/1/85

Dundonald

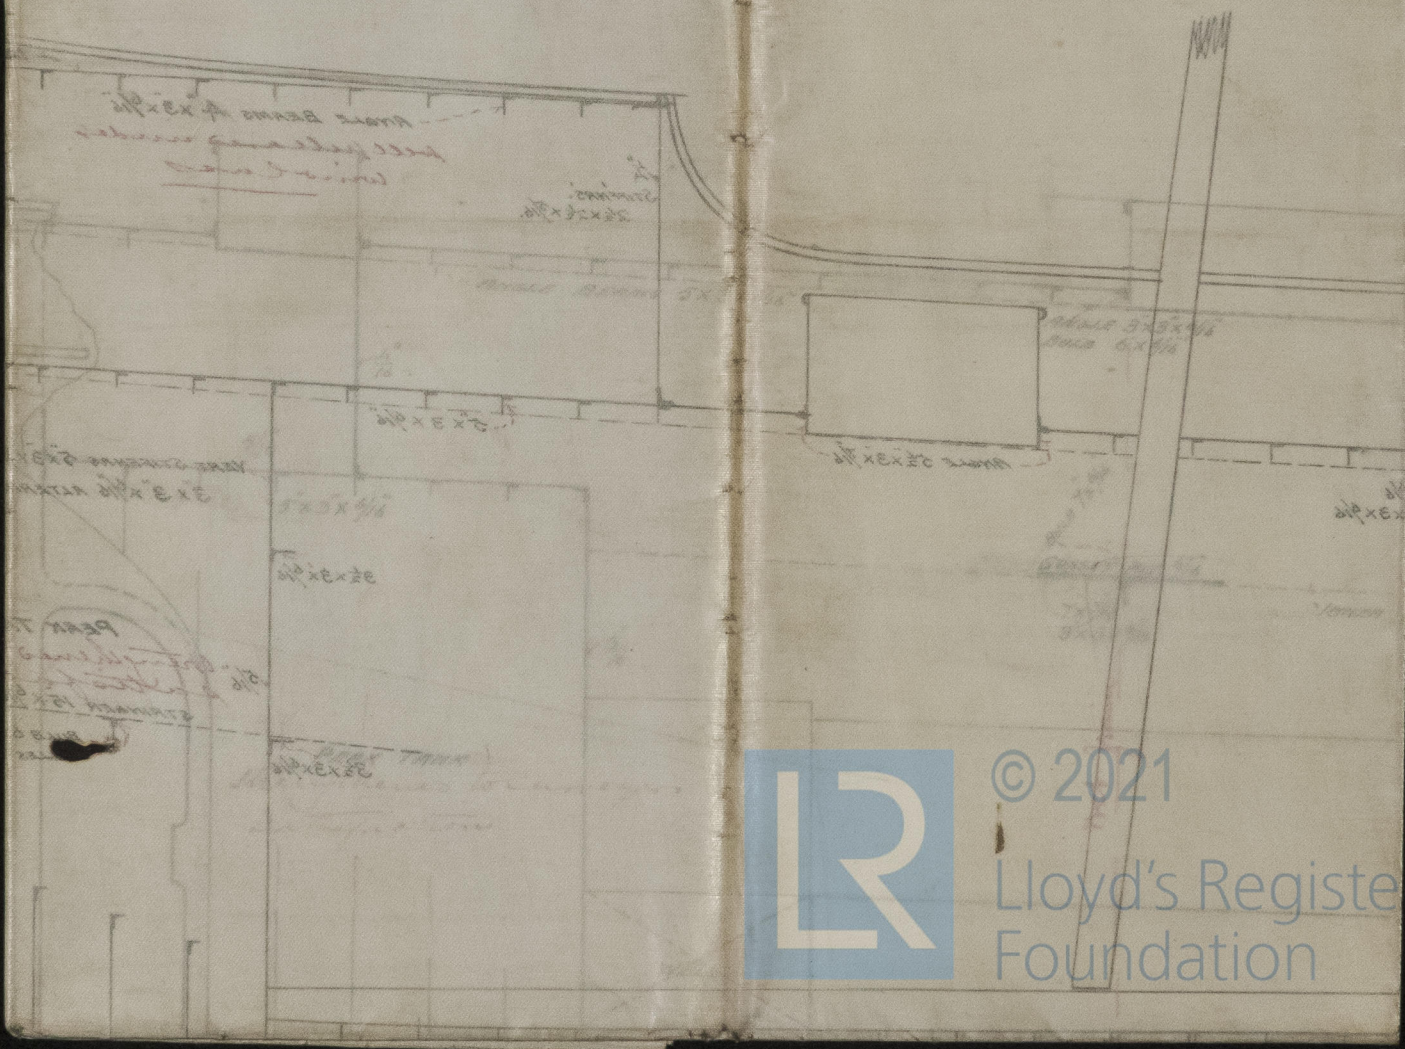

© 2021

Lloyd's Register
Foundation