

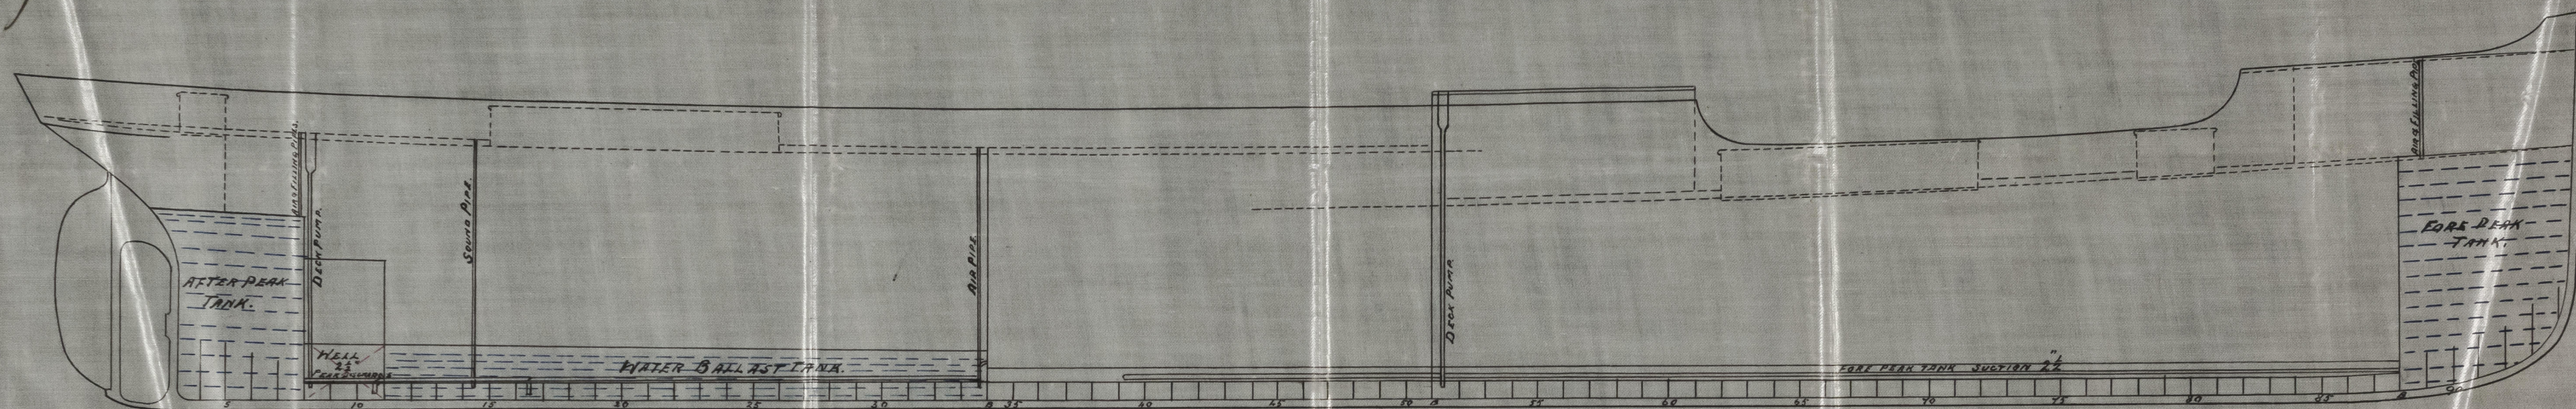
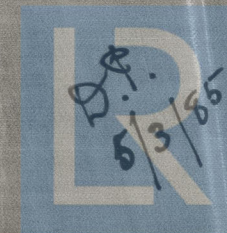


Dr. to Mr. C.  
5/3/85.

S.S. "Edendale" Nwc. Report No. 185-32

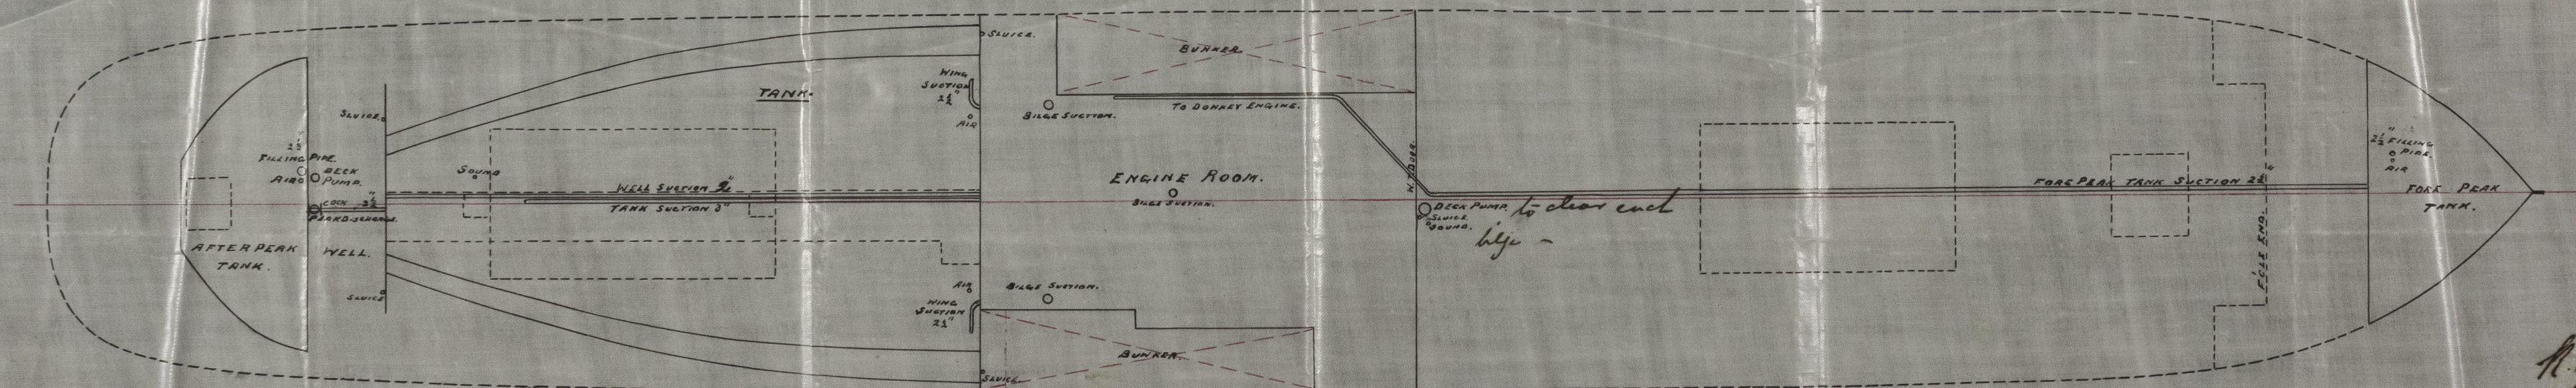

— S.S. N° 58. —  
— PUMPING ARRANGEMENT. —  
— SCALE  $\frac{1}{8}$ " = 1 FOOT. —

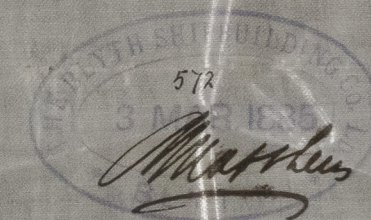

A.W.C.  
© 1885/86

Lloyd's Register  
Foundation