

The words FORGINGS or CASTINGS, IRON or STEEL, should be struck out as may be required.

Received at

Office,

18

# Lloyd's Register of British and Foreign Shipping.

(Report on Vessel No. \_\_\_\_\_ Port \_\_\_\_\_)

No. 234A

## SHIP FORGINGS OR CASTINGS.

I have to report that the undermentioned Iron or Steel Forgings or Castings, manufactured by Messrs C & B Reed & Co. of Sunderland for the Vessel No. 58, being built by the Blyth S & B Co. of Blyth have been inspected by me as set forth below, and found to be, so far as can be seen, sound.


Mark on Forgings.

Lloyd's  
No. 234A  
C & B Co.

Hugh Cameron,  
Sunderland.

	STERN FRAME.	RUDDER FRAME.	STEM.
Material* - - - -	Scrap Iron	Scrap Iron	Scrap Iron
How made - - - -	Forged	Forged	Forged
Dimensions - - - -	6 1/2" x 3 3/4"	4 1/4" - 2 1/2"	6 1/2" x 1 1/8"
Progress on Inspection -	Forged & smithed	Forged & smithed	Forged
Dates when Inspected {	Feb 11-20-24-27/85	April 9-15-18-20-22-28 30/85	Feb 11/85

SKETCHES OF FRAMES SHEWING POSITION AND DESCRIPTION OF WELDS OF FORGINGS, OR PARTICULARS OF TESTS APPLIED TO CASTINGS.

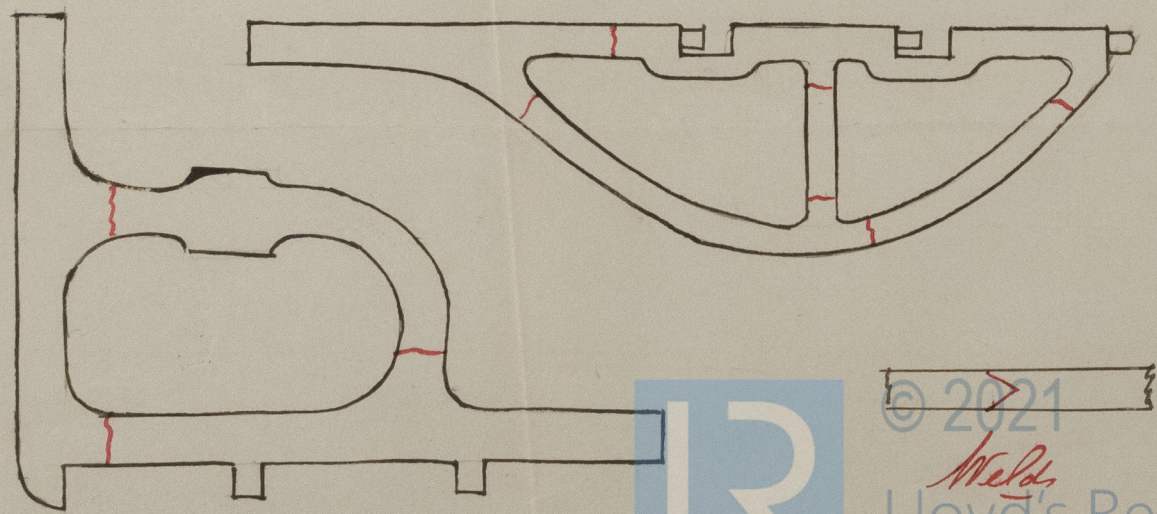

Glyth Shipby Co. No. 58  
S.S. "Edendale"  
Nuc. Repat No. 18532



© 2021

Lloyd's Register  
Foundation