
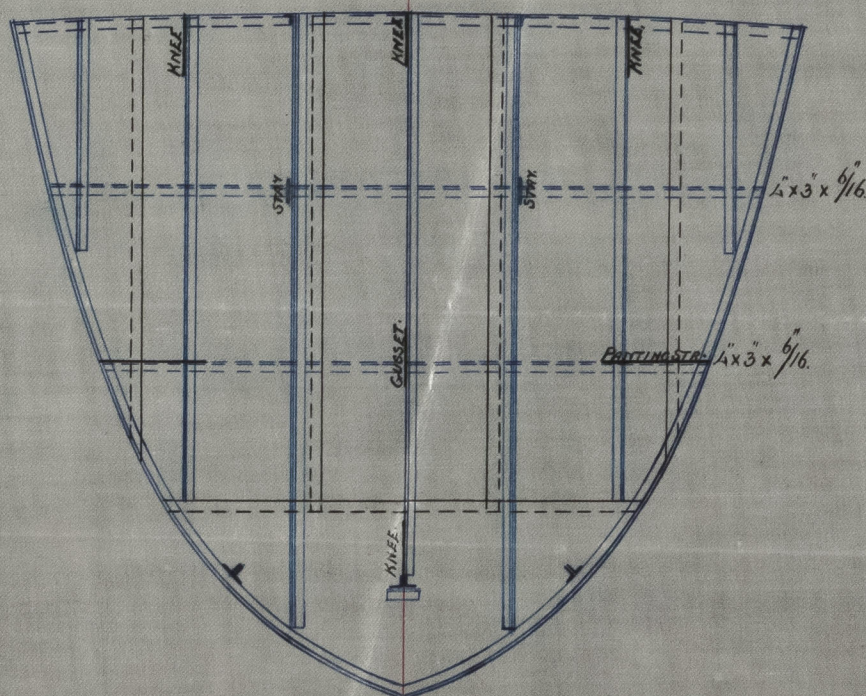
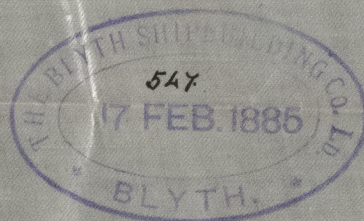


S.S. "Edendale" Nwc. Report No. 18532

— N<sup>o</sup> 58. —


— PLAN OF FORE PEAK TANK. —

— SCALE  $\frac{1}{4}$ " = 1 FOOT. —

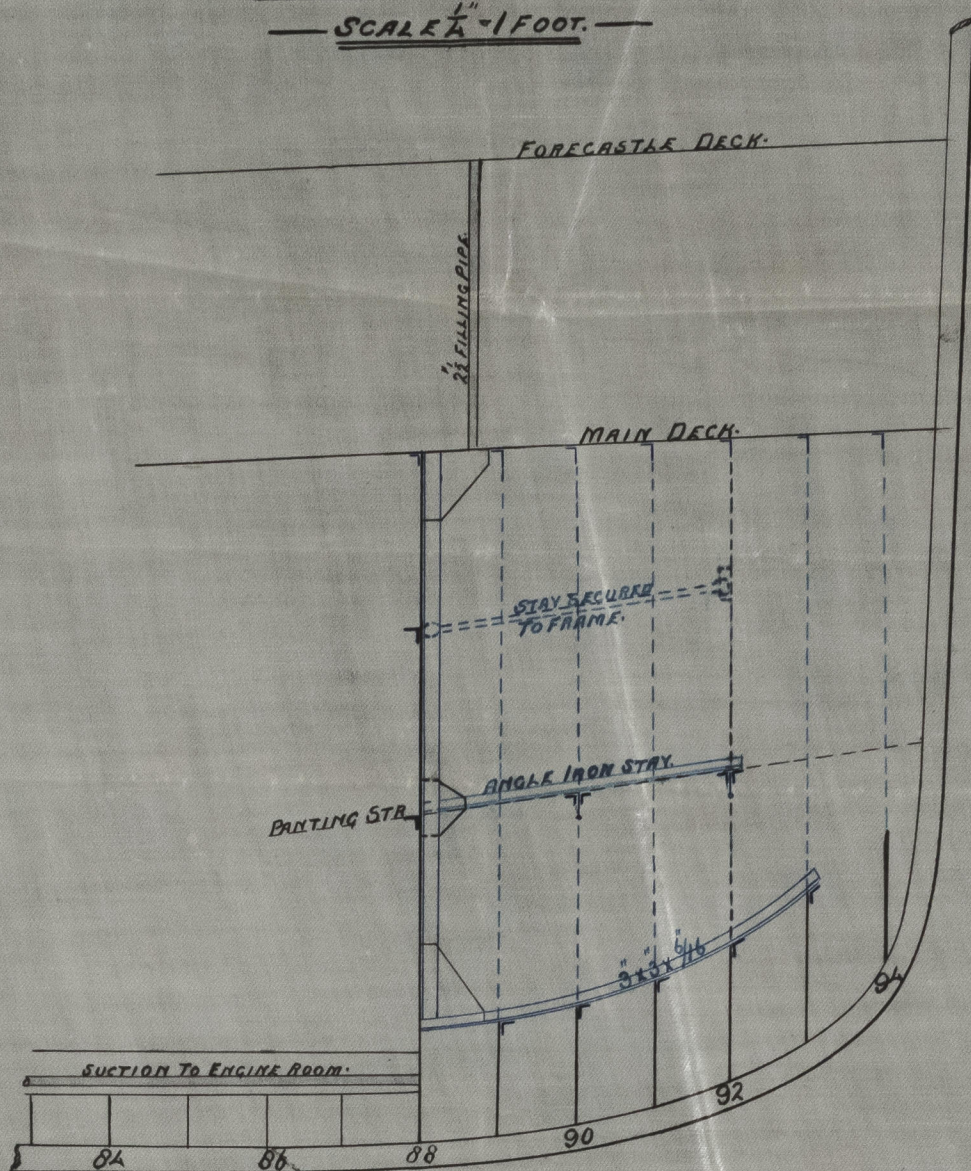

— B.H. 88. —

— PLAN OF STIFFENERS. —

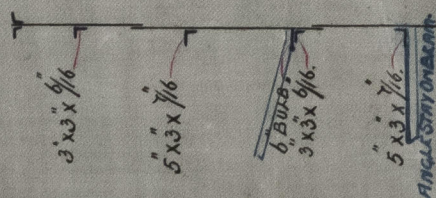

© 2021

Lloyd's Register Foundation

NWC793-0209