Lr. to Mrs: 13.2.85.

Lloyd's Register of Shipping RECEIVED 2 OCT 1885

WIGHAM RICHARDSON & CO SHIPYARD DEPT. NEPTUNE WORKS 9/2/85 NEWCASTLE-ON-TYNE

Scw. Stm. "Baghdadi" Mwc. Report No 18619

№ 194

Longitudinal Section

Scale 1/8 in = 1 ft

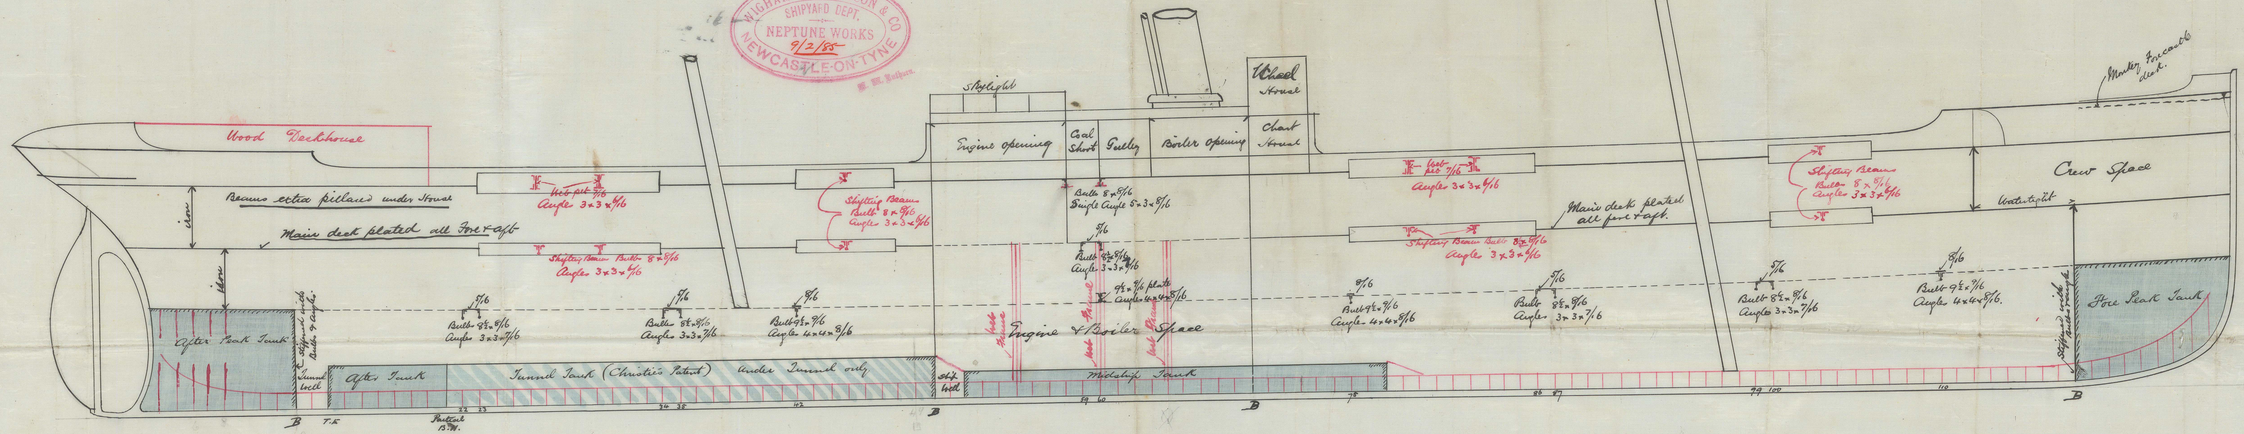

— PLAN OF SPAR DECK —

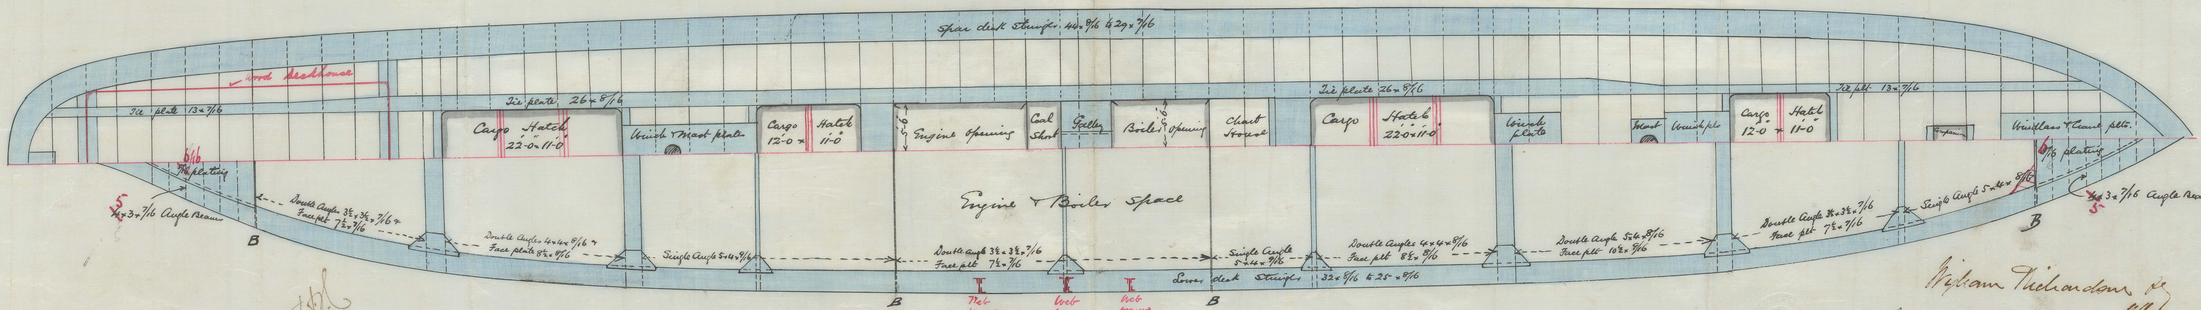

— PLAN OF LOWER DECK —

J.G.S. 13/2/85.

William Richardson & Co

Newcastle on Tyne 9 Feby 1885

J.G.S. 11/2/85

© 2021 Lloyd's Register Foundation

NWC793-0250

194

No. 194

Longitudinal Section

Scale 1/8 in = 1 ft

SHIPYARD DEPT.
NEPTUNE WORKS
NEWCASTLE-ON-TYNE

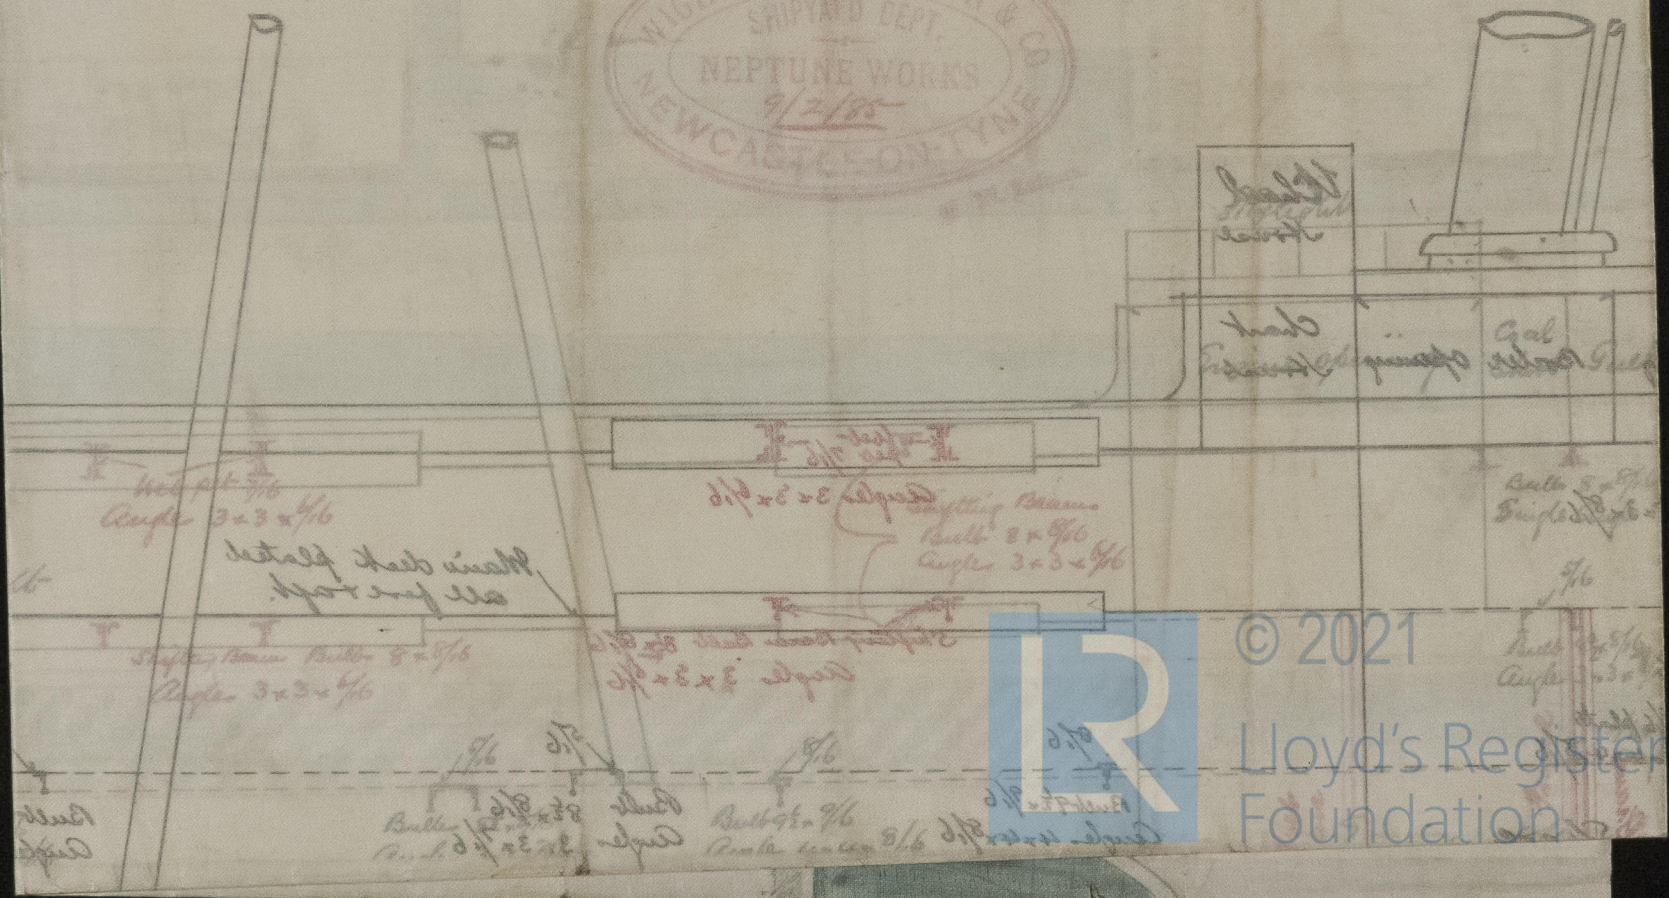

© 2021
Lloyd's Register
Foundation