

The words FORGINGS or CASTINGS, IRON or STEEL, should be struck out as may be required.

Received at

Office,

18

Lloyd's Register of British and Foreign Shipping.

(Report on Vessel No. _____ Port _____)

No. 255A. SHIP FORGINGS OR CASTINGS.

I have to report that the undermentioned Iron or Steel Forgings or Castings, manufactured by

Messrs A Leslie & Co. of *Hebburn*
for the Vessel No. *194*, being built by *Messrs W Richardson & Co.*
of *Waltham* have been inspected by me as set forth below, and found
to be, so far as can be seen, *sound*.

Mark on Forgings.


Lloyd's

No. 255A.
W.C.

Hugh Cameron.
Sunderland.

	STERN FRAME.	RUDDER FRAME.	STEM.
Material* - - - -	<i>Scrap Iron</i>	<i>Scrap Iron</i>	<i>Scrap Iron</i>
How made - - - -	<i>Forged</i>	<i>Forged</i>	<i>Forged</i>
Dimensions - - - -	<i>8 1/2' x 5'</i>	<i>6 1/4' - 3 1/4'</i>	<i>8 1/2' x 2 1/2'</i>
Progress on Inspection -	<i>Smithed</i>	<i>Forged Smithed</i>	<i>Forged</i>
Dates when Inspected	<i>July 25 March 11-23/85</i>	<i>March 11-23 April 13/85</i>	<i>July 25/85</i>

SKETCHES OF FRAMES SHEWING POSITION AND DESCRIPTION OF WELDS OF FORGINGS, OR PARTICULARS OF TESTS APPLIED TO CASTINGS.

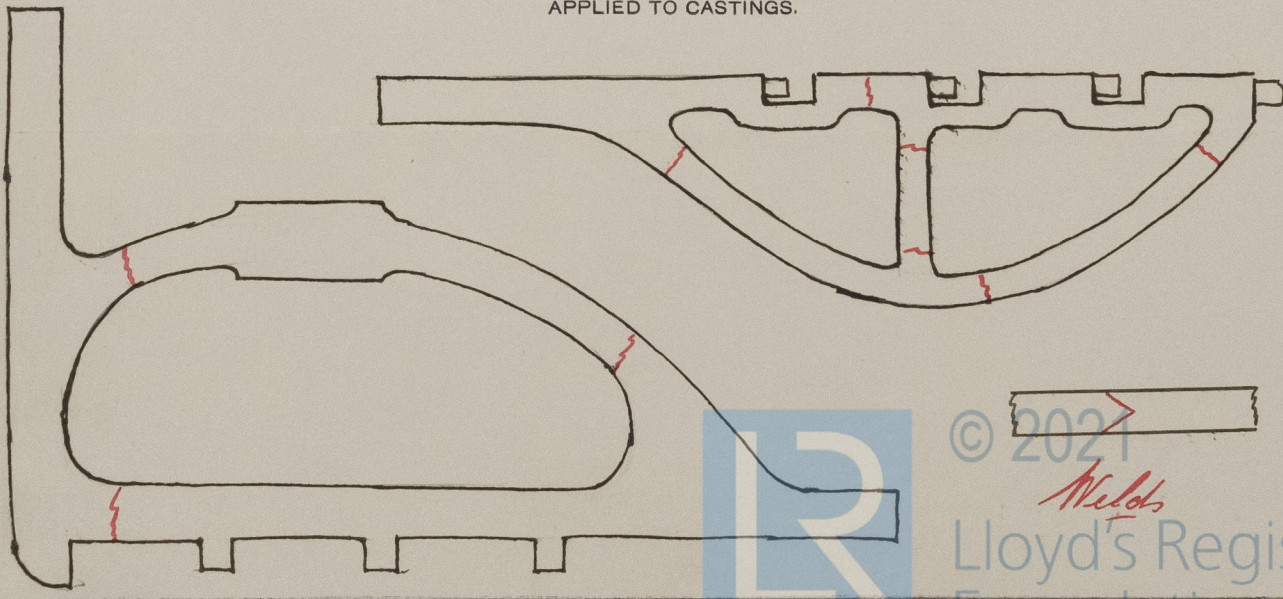

W Richardson & Co.
No. 194. Sew. Str
"Baghdadi"
Proc No. 18619



© 2021

Lloyd's Register
Foundation